

# U.S. PUBLIC LAND SURVEY MONUMENT RECORD


For Public Land Survey Corners in the  
T. 2 N., R. 12 E.

## CORNER CODE INDEX

|   |   |   |   |    |    |    |    |    |    |    |    |    |    |    |    |    |    |    |    |    |    |    |    |    |    |
|---|---|---|---|----|----|----|----|----|----|----|----|----|----|----|----|----|----|----|----|----|----|----|----|----|----|
|   | 1 | 2 | 3 | 4  | 5  | 6  | 7  | 8  | 9  | 10 | 11 | 12 | 13 | 14 | 15 | 16 | 17 | 18 | 19 | 20 | 21 | 22 | 23 | 24 | 25 |
| A |   |   |   |    |    |    |    |    |    |    |    |    |    |    |    |    |    |    |    |    |    |    |    |    |    |
| B |   |   |   |    |    |    |    |    |    |    |    |    |    |    |    |    |    |    |    |    |    |    |    |    |    |
| C | 6 |   |   |    |    |    |    |    |    |    |    |    |    |    |    |    |    |    |    |    |    |    |    |    |    |
| D |   | 5 |   |    |    |    |    |    |    |    |    |    |    |    |    |    |    |    |    |    |    |    |    |    |    |
| E |   |   | 4 |    |    |    |    |    |    |    |    |    |    |    |    |    |    |    |    |    |    |    |    |    |    |
| F |   |   |   | 3  |    |    |    |    |    |    |    |    |    |    |    |    |    |    |    |    |    |    |    |    |    |
| G |   |   |   |    | 2  |    |    |    |    |    |    |    |    |    |    |    |    |    |    |    |    |    |    |    |    |
| H | 7 |   |   |    |    |    |    |    |    |    |    |    |    |    |    |    |    |    |    |    |    |    |    |    |    |
| I |   | 8 |   |    |    |    |    |    |    |    |    |    |    |    |    |    |    |    |    |    |    |    |    |    |    |
| J |   |   | 9 |    |    |    |    |    |    |    |    |    |    |    |    |    |    |    |    |    |    |    |    |    |    |
| K |   |   |   | 10 |    |    |    |    |    |    |    |    |    |    |    |    |    |    |    |    |    |    |    |    |    |
| L |   |   |   |    | 11 |    |    |    |    |    |    |    |    |    |    |    |    |    |    |    |    |    |    |    |    |
| M |   |   |   |    |    | 12 |    |    |    |    |    |    |    |    |    |    |    |    |    |    |    |    |    |    |    |
| N |   |   |   |    |    |    | 13 |    |    |    |    |    |    |    |    |    |    |    |    |    |    |    |    |    |    |
| O |   |   |   |    |    |    |    | 14 |    |    |    |    |    |    |    |    |    |    |    |    |    |    |    |    |    |
| P |   |   |   |    |    |    |    |    | 15 |    |    |    |    |    |    |    |    |    |    |    |    |    |    |    |    |
| Q |   |   |   |    |    |    |    |    |    | 16 |    |    |    |    |    |    |    |    |    |    |    |    |    |    |    |
| R |   |   |   |    |    |    |    |    |    |    | 17 |    |    |    |    |    |    |    |    |    |    |    |    |    |    |
| S |   |   |   |    |    |    |    |    |    |    |    | 18 |    |    |    |    |    |    |    |    |    |    |    |    |    |
| T |   |   |   |    |    |    |    |    |    |    |    |    | 19 |    |    |    |    |    |    |    |    |    |    |    |    |
| U |   |   |   |    |    |    |    |    |    |    |    |    |    | 20 |    |    |    |    |    |    |    |    |    |    |    |
| V |   |   |   |    |    |    |    |    |    |    |    |    |    |    | 21 |    |    |    |    |    |    |    |    |    |    |
| W |   |   |   |    |    |    |    |    |    |    |    |    |    |    |    | 22 |    |    |    |    |    |    |    |    |    |
| X |   |   |   |    |    |    |    |    |    |    |    |    |    |    |    |    | 23 |    |    |    |    |    |    |    |    |
| Y |   |   |   |    |    |    |    |    |    |    |    |    |    |    |    |    |    | 24 |    |    |    |    |    |    |    |
| Z |   |   |   |    |    |    |    |    |    |    |    |    |    |    |    |    |    |    | 25 |    |    |    |    |    |    |

PLACE MONUMENT SYMBOL (◆) AT PROPER LOCATION ON ABOVE INDEX

### EXAMPLE

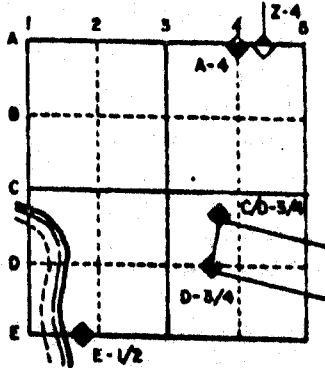


ROCK TWP  
ROCK COUNTY WI

IF AVAILABLE  
STATE PLANE COORDINATES

NAD North (Y) 235,460.67      Eleve. (Z) \_\_\_\_\_  
 27 East (X) 2,239,406.52      Zone \_\_\_\_\_  
 Hor. Datum \_\_\_\_\_      Vert. Datum \_\_\_\_\_  
 WPL 235,458.52  
2,239,406.82

e.) ◆ CORNER MONUMENT      ○ WITNESS MONUMENT  
 CAST IRON MONUMENT

BEARINGS ARE BASED ON: ASSUMED

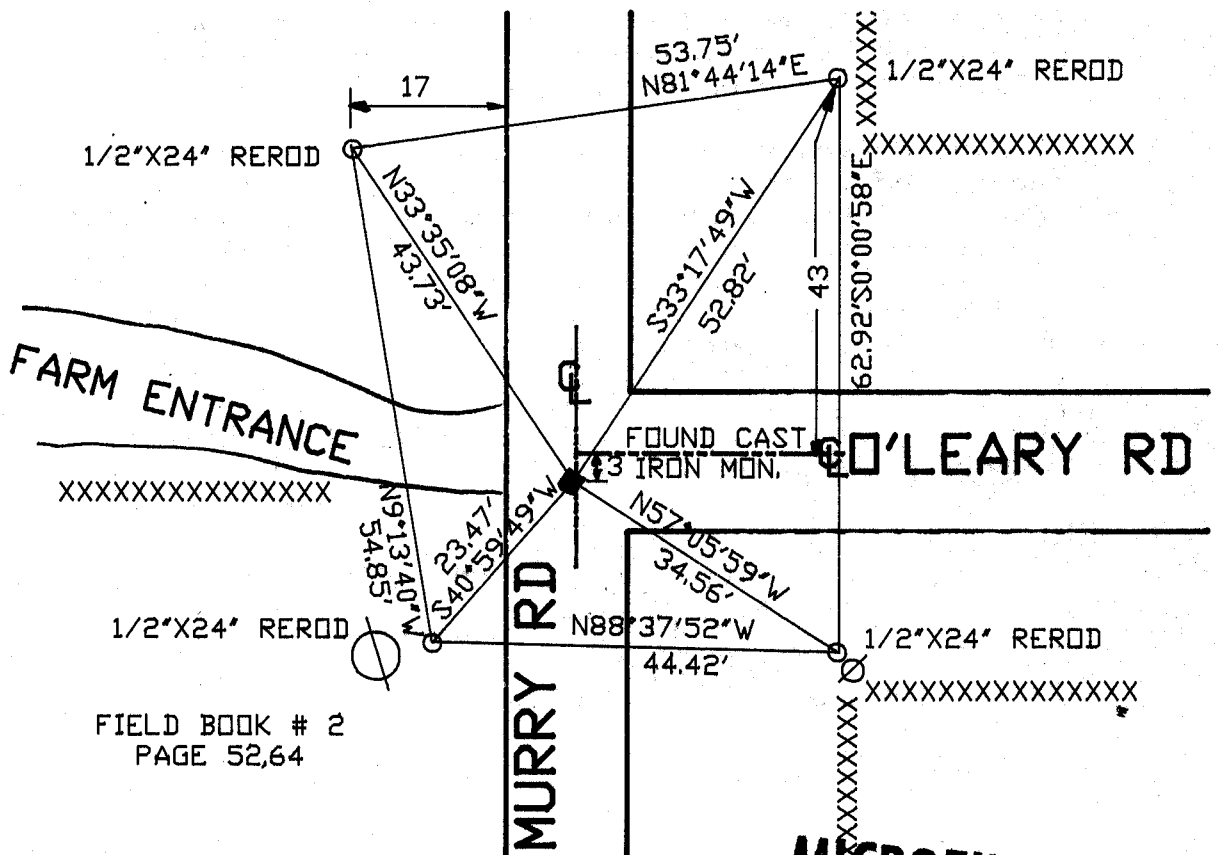

FIELD BOOK # 2  
PAGE 52,64

# MICROFILMED

SHEET \_\_\_ OF \_\_\_

CORNER CODE: JS

(B) Describe any record evidence, monument evidence, occupational evidence, testimonial evidence or any other material evidence you considered, and whether the monument was found or placed.

1866 LOCKE VOL 1 PG 266. FOUND STUMPS OF BERING TREES AND OLD STAKE. SET BR. O. AND SURROUNDED IT BY 3 HARD HEADS.

1892 BLEEDORN VOL 2 PG 462 FOUND STAKE. SET HARDHEAD 16X11X10 AND SURROUNDED IT BY 4 HARD HEADS. SHOWS A DISTANCE OF 2695.44' TO THE SOUTH 1/4 CORNER OF SECTION 8.

1972 LEE VOL 4 PG 570. DUG AND FOUND 5/8" PIN SURROUNDED BY HARD HEADS. PLACED CAST IRON MONUMENT AND REFERENCED SAME.

1972 LEE VOL 4 PG 588 SHOWS THE FOLLOWING DISTANCES AND BEARINGS IN SECTION 7:

TO SW N89-38-40W 5351.81  
NE S01-06-23E 2649.64

1974 LEE VOL 4 PG 589 SHOWS THE FOLLOWING DISTANCES IN SECTION 18:

TO NW S89-38-40E 5351.81  
SE N01-13-52W 2649.64

1980 BARNES SHOWS WPL COORDINATES; N/S 235,458.52; 2,239,406.80 SHOWS DISTANCES AND BEARINGS IN SECTION TO THE FOLLOWING CORNERS:

TO NE N1-01-27W 5298.24  
S1/4 COR S89-33-00E 2674.92

1982 BARNES VOL 6 PG 281 SHOWS A BEARING AND DISTANCE TO THE S 1/4 CORNER OF SECTION 7 AS S88-27-09E 2647.47

FOUND CAST IRON MONUMENT AND REFERENCED SAME.



C) Was the corner restored through acceptance of (1) an obliterated evidence location, or, (2) a found perpetuated location?

ACCEPTED FOUND PERPETUATED LOCATION.

D) Describe any material discrepancy between the location of the corner as restored or reestablished and the location of that corner as previously restored or reestablished by distance and direction. Show the discrepancy on the plan view drawing under (a), above. Show the distances between the corner as previously restored or reestablished and (1) the corner as restored or reestablished, and (2) to at least 4 of the witness monuments shown on the drawing in (a), above.

(E) Was the corner reestablished through lost corner proportionate methods? If so, show the method, including the directions and distances to other public land survey corners used as evidence or used for proportioning the corner location.

I, Donald Barnes, hereby certify that the corner points as identified by the corner code index were, in a field survey on, JULY 11, 1989, established, re-established, monumented, re-monumented, recovered or restored as expressed below and in conformance with the regulations and rules as required in the current manual of survey instructions of the United States Department of Interior, Bureau of Land Management.

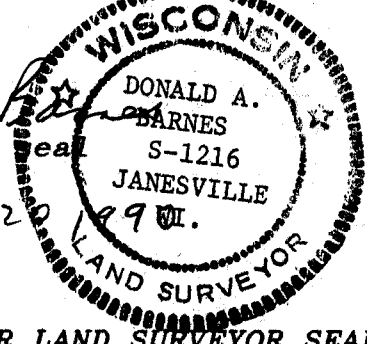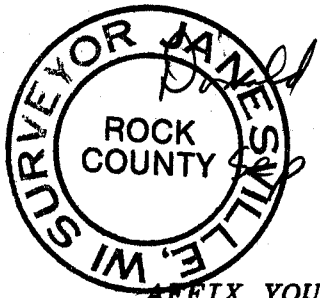

COUNTY SURVEYOR FILING DATA  
Date of computer entry \_\_\_\_\_  
Date microfilmed \_\_\_\_\_  
Number of included sheets \_\_\_\_\_  
CORNER CODE

AFFIX YOUR LAND SURVEYOR SEAL