

U.S. PUBLIC LAND SURVEY MONUMENT RECORD


For Public Land Survey Corners in the
T. 2 N., R. 12 E.

CORNER CODE INDEX

	1	2	3	4	5	6	7	8	9	10	11	12	13	14	15	16	17	18	19	20	21	22	23	24	25
A																									
B																									
C	6																								
D		5																							
E			4																						
F				3																					
G					2																				
H																									
I																									
J	7																								
K		8																							
L			9																						
M				10																					
N					11																				
O						12																			
P							13																		
Q								14																	
R									15																
S										16															
T											17														
U												18													
V													19												
W														20											
X															21										
Y																22									
Z																	23								
																		24							
																			25						
																				26					
																					27				
																						28			
																							29		
																								30	
																									31
																									32
																									33
																									34
																									35
																									36

PLACE MONUMENT SYMBOL (◆) AT PROPER LOCATION ON ABOVE INDEX

EXAMPLE

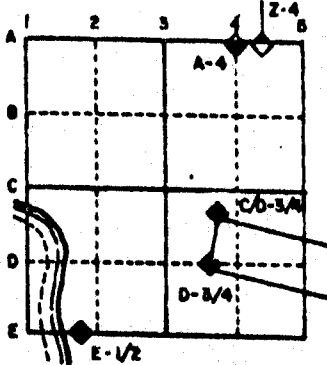


ROCK TWP
ROCK COUNTY WI

IF AVAILABLE STATE PLANE COORDINATES

NAD
27 North (Y) 222,263.63 Eleve. (Z) _____
East (X) 2,239,695.53 Zone _____
Hor. Datum _____ Vert. Datum _____
WPL 222,262.92
2,239,694.48

e) ◆ CORNER MONUMENT ○ WITNESS MONUMENT

BEARINGS ARE BASED ON: TOWNSHIP PROTECT

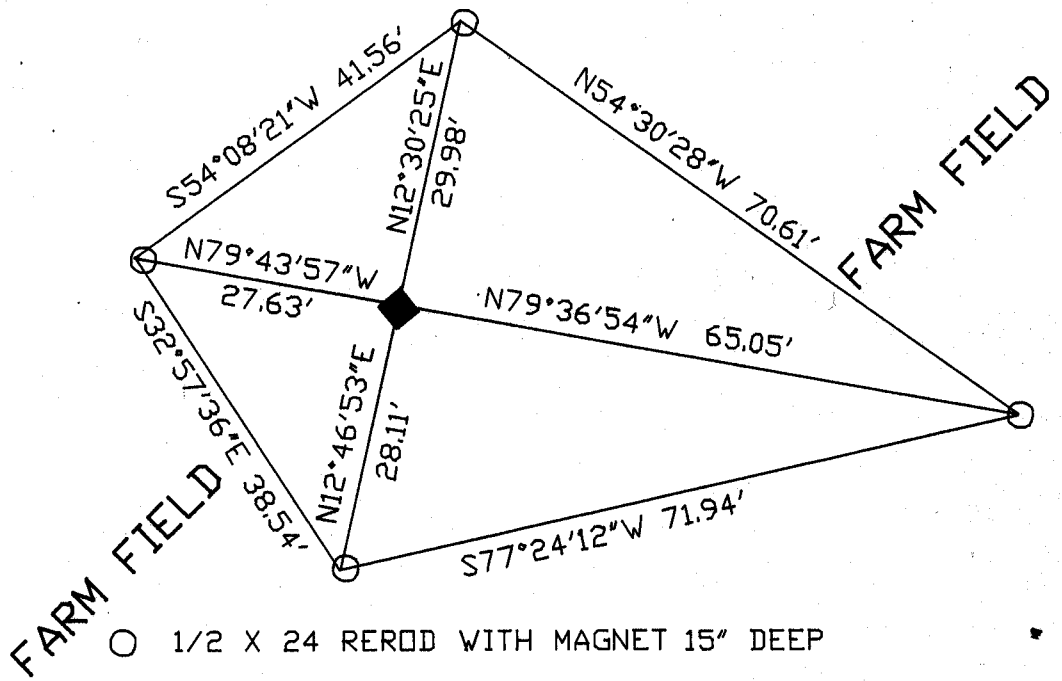

○ 1/2 X 24 REROD WITH MAGNET 15" DEEP
◆ FD CI MON WITH R/W POST PLACED CARSONITE MARKER

MICROFILMED

SHEET ___ OF ___

CORNER CODE: TS

(B) Describe any record evidence, monument evidence, occupational evidence, testimonial evidence or any other material evidence you considered, and whether the monument was found or placed.

1834 HARRISON ORIGINAL GOVERNMENT SURVEYOR. FIELD NOTES -
QUARTER SECTION CORNER WHITE OAK 12 S4W 13.00
1855 CHURCH VOL 1 PG 31. SHOWS 2645.28 TO CENTER OF SECTION 30.
1972 LEE VOL 4 PG 577 SET CAST IRON MONUMENT WITH R/W POST 2' NE.
WPL COORDINATES N/S 222,262.92 E/W 2,239,694.48 SHOWS S0-
05-48W 2639.11 TO NE COR SEC 30, S88-45-07E 5346.70 TO
CENTER SEC 30, AND S0-05-48W 2639.61 TO SE COR SEC 30.
1972 LEE VOL 4 PG 578. SHOWS N0-05-48E 2639.11 TO NW COR SEC 29,
S89-18-24E 2673.19 TO CENTER SEC 29, AND N0-05-48E 2639.11
TO SW COR SEC 29.
1981 BARNES VOL 6 PG 144 SHOWS N1-18-06W 2640.06 TO SW COR SEC
29.

FOUND CAST IRON MONUMENT WITH R/W POST. PLACED CARSONITE POST.


C) Was the corner restored through acceptance of (1) an obliterated evidence location, or, (2) a found perpetuated location?

ACCEPTED FOUND MONUMENT.

D) Describe any material discrepancy between the location of the corner as restored or reestablished and the location of that corner as previously restored or reestablished by distance and direction. Show the discrepancy on the plan view drawing under (a), above. Show the distances between the corner as previously restored or reestablished and (1) the corner as restored or reestablished, and (2) to at least 4 of the witness monuments shown on the drawing in (a), above.

(E) Was the corner reestablished through lost corner proportionate methods? If so, show the method, including the directions and distances to other public land survey corners used as evidence or used for proportioning the corner location.

I, Donald Barnes, hereby certify that the corner points as identified by the corner code index were, in a field survey on, July 20, 1990, established, re-established, monumented, re-monumented, recovered or restored as expressed below and in conformance with the regulations and rules as required in the current manual of survey instructions of the United States Department of Interior, Bureau of Land Management.

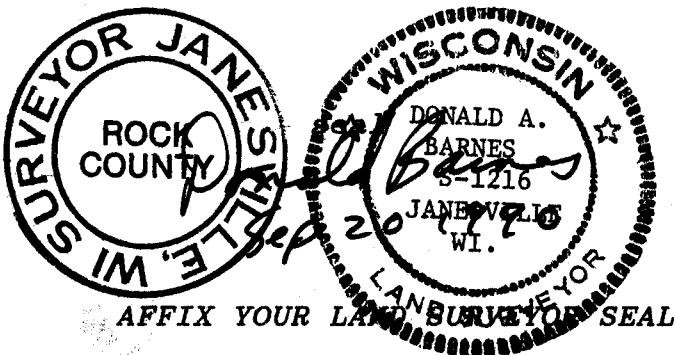

COUNTY SURVEYOR FILING DATA

Date of computer entry _____

Date microfilmed _____

Number of included sheets _____
CORNER CODE

T5