

(B) Describe any record evidence, monument evidence, occupational evidence, testimonial evidence or any other material evidence you considered, and whether the monument was found or placed.

1834 HARRISON ORIGINAL GOVERNMENT SURVEYOR. FIELD NOTES - QUARTER SECTION CORNER. BLACK OAK 8 N43E 2.20 AND BURR OAK 10 S82E 1.90. MEASURED 2665.74 TO THE SE AND SW CORNERS OF SECTION 27

1881 LEE VOL 2 PG 325 STUMPS OF BEARING TREES GONE. ESTABLISHED CORNER MIDWAY ON SECTION LINE. SET STAKE WITH HARDHEAD ON NORTH AND SOUTH AND SMALLER LIMESTONES EAST AND WEST. SHOWS A DISTANCE OF 2673.66 TO THE SW AND SE CORNERS OF SECTION 27.

1887 RUGER VOL 2 PG 413. FOUND STAKE SURROUNDED BY 2 HARDHEAD AND 2 LIMESTONES

1978 BARNES VOL 5 PG 383 FOUND 2' DEEP 1"(ID)X36" IRON PIPE SURROUNDED BY LIMESTONE. PLACED ALUMINUM MONUMENT 2' DEEP AND REFERENCED SAME.

FOUND ALUMINUM MONUMENT AND PROPERTY PIN THAT WAS 10.60 TO THE EAST.


C) Was the corner restored through acceptance of (1) an obliterated evidence location, or, (2) a found perpetuated location?

ACCEPTED FOUND ALUMINUM MONUMENT.

D) Describe any material discrepancy between the location of the corner as restored or reestablished and the location of that corner as previously restored or reestablished by distance and direction. Show the discrepancy on the plan view drawing under (a), above. Show the distances between the corner as previously restored or reestablished and (1) the corner as restored or reestablished, and (2) to at least 4 of the witness monuments shown on the drawing in (a), above.

(E) Was the corner reestablished through lost corner proportionate methods? If so, show the method, including the directions and distances to other public land survey corners used as evidence or used for proportioning the corner location.

I, Donald Barnes, hereby certify that the corner points as identified by the corner code index were, in a field survey on, July 20, 1990, established, re-established, monumented, re-monumented, recovered or restored as expressed below and in conformance with the regulations and rules as required in the current manual of survey instructions of the United States Department of Interior, Bureau of Land Management.

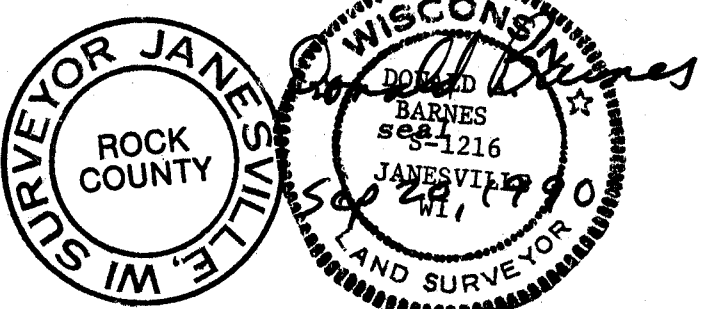

AFFIX YOUR LAND SURVEYOR SEAL

COUNTY SURVEYOR FILING DATA

Date of computer entry _____

Date microfilmed _____

Number of included sheets _____

CORNER CODE

V15