

U.S. PUBLIC LAND SURVEY MONUMENT RECORD


For Public Land Survey Corners in the
T. 2 N., R. 12 E.

CORNER CODE INDEX

	1	2	3	4	5	6	7	8	9	10	11	12	13	14	15	16	17	18	19	20	21	22	23	24	25
A																									
B																									
C	6																								
D		5																							
E			4																						
F				3																					
G					2																				
H																									
I	7																								
J		6																							
K			5																						
L				4																					
M					3																				
N						2																			
O							1																		
P	8																								
Q		20																							
R			21																						
S				22																					
T					23																				
U						24																			
V							25																		
W								26																	
X									27																
Y										28															
Z											29														
												30													
													31												
														32											
															33										
																34									
																	35								
																		36							

PLACE MONUMENT SYMBOL (●) AT PROPER LOCATION ON ABOVE INDEX

EXAMPLE

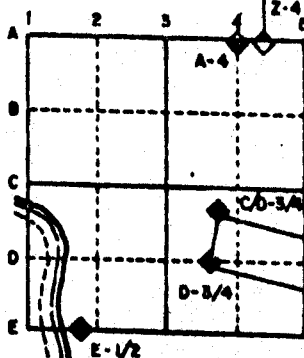

ROCK TWP
ROCK COUNTY WI

IF AVAILABLE
STATE PLANE COORDINATES


North (Y) _____ Elev. (Z) _____
 East (X) _____ Zone _____
 Hor. Datum _____ Vert. Datum _____

e.) **◆ CORNER MONUMENT** **○ WITNESS MONUMENT**
 ALUMINUM MON

FOUND 1" PIPE

OAKHILL
RD

3/4X24" REROD WITH
ORANGE PLASTIC CAP

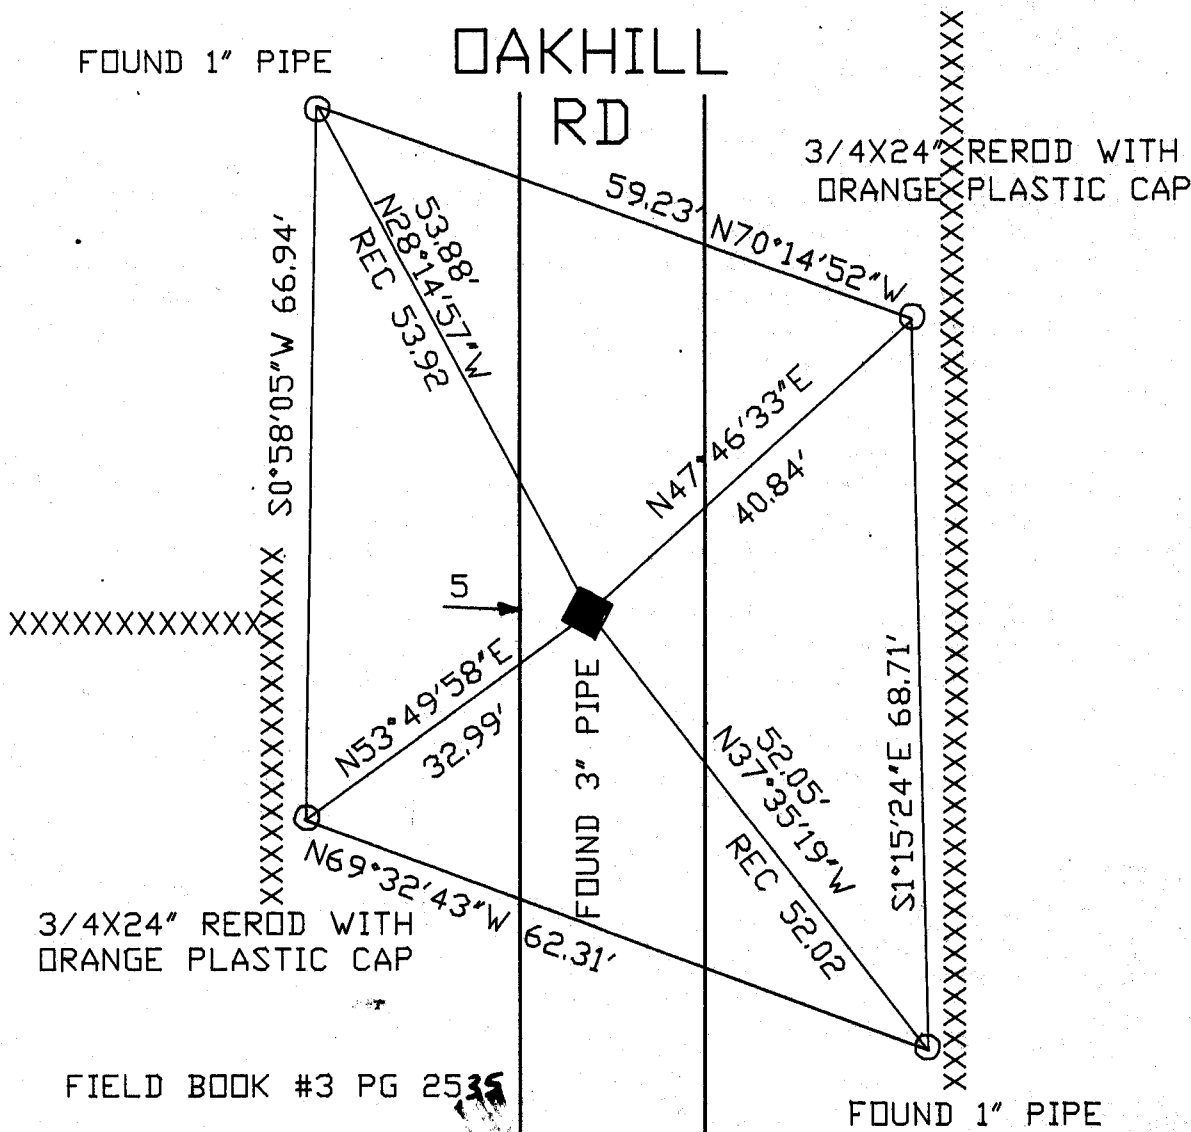

MICROFILMED

SHEET ___ OF ___

CORNER CODE: J 19

(B) Describe any record evidence, monument evidence, occupational evidence, testimonial evidence or any other material evidence you considered, and whether the monument was found or placed.

1867 LOCKE VOL 1 PG 289 CORNER LOST. SET (FROM CORNERS OF SECTION) STAKE SURROUNDED BY 3 FLAT LIMESTONES. SHOWS 2664.75' TO SW CORNER OF SECTION 11 AND 2664.75 TO SE CORNER OF SECTION 11.

1870 RUGER VOL 2 PG 21 FOUND CORNER AS ESTABLISHED BY LOCKE. STAKE SURROUNDED BY 3 LIMESTONES.

1870 RUGER VOL 2 PG 37 SHOWS 990 TO A CORNER THAT IS TO THE NORTH.

1880 LEE VOL 2 PG 298 FOUND STAKE SURROUNDED BY 3 LIMESTONES. IT IS 33' WEST OF EAST ROAD FENCE AND 23.1' EAST OF WEST ROAD FENCE AND IN LINE WITH DITCH. SHOWS A DISTANCE OF 2641.98 TO CENTER OF SECTION 11 AND 2656.50' TO SE CORNER OF SECTION 11.

1883 RUGER VOL 2 PG 408 FOUND STAKE SURROUNDED BY 3 LIMESTONES. SHOWS A DISTANCE OF 2661.12 TO SW CORNER OF SECTION 11 AND 2641.98 TO CENTER OF SECTION 11.

1894 BLEEDORN VOL 2 PG 484. FOUND STAKE AND STONE. SHOWS 1328.58' TO S 1/16th CORNER OF THE SW 1/4 OF SECTION 11 AND 990' TO A CORNER ON THE N/S LINE OF SECTION 11.

1961 BATTERMAN JR. VOL 4 PG 124 FOUND RIGHT ANGLE REFERENCE TIES SET BY C. SHIMEALL AND REFERENCED SAID CORNER.

1975 SCHROEDER VOL 5 PG 56. SHOWS REFERENCE TIES.

FOUND 3x29" PIPE. AT 29" DEEP FOUND REMAINS OF WOOD STAKE. PLACED ALUMINUM MON.



C) Was the corner restored through acceptance of (1) an obliterated evidence location, or, (2) a found perpetuated location?

ACCEPTED FOUND MONUMENT.

D) Describe any material discrepancy between the location of the corner as restored or reestablished and the location of that corner as previously restored or reestablished by distance and direction. Show the discrepancy on the plan view drawing under (a), above. Show the distances between the corner as previously restored or reestablished and (1) the corner as restored or reestablished, and (2) to at least 4 of the witness monuments shown on the drawing in (a), above.

(E) Was the corner reestablished through lost corner proportionate methods? If so, show the method, including the directions and distances to other public land survey corners used as evidence or used for proportioning the corner location.

I, Donald Barnes, hereby certify that the corner points as identified by the corner code index were, in a field survey on, August 17, 1990, established, re-established, monumented, re-monumented, recovered or restored as expressed below and in conformance with the regulations and rules as required in the current manual of survey instructions of the United States Department of Interior Bureau of Land Management.

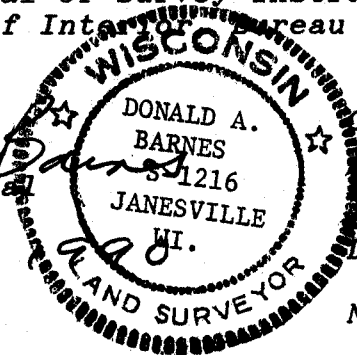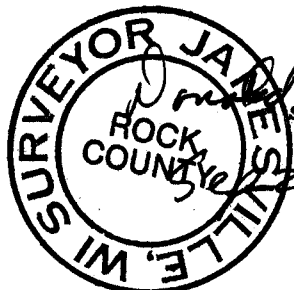

COUNTY SURVEYOR FILING DATA

Date of computer entry _____

Date microfilmed _____

Number of included sheets _____

CORNER CODE

AFFIX YOUR LAND SURVEYOR SEAL

J 19