

PUBLIC LAND SURVEY MONUMENT RECORD


For Public Land Survey Corners in the
T. 2 N., R. 12 E

CORNER CODE INDEX

	1	2	3	4	5	6	7	8	9	10	11	12	13	14	15	16	17	18	19	20	21	22	23	24	25
A																									
B																									
C	6																								
D		5																							
E			4																						
F				3																					
G					2																				
H																									
I	7																								
J		8																							
K			9																						
L				10																					
M					11																				
N						12																			
O	13																								
P		14																							
Q			15																						
R				16																					
S					17																				
T						18																			
U							19																		
V								20																	
W									21																
X										22															
Y											23														
Z												24													
													25												
														26											
															27										
																28									
																	29								
																		30							
																			31						
																				32					
																					33				
																						34			
																							35		
																								36	

PLACE MONUMENT SYMBOL (◆) AT PROPER LOCATION ON ABOVE INDEX

EXAMPLE

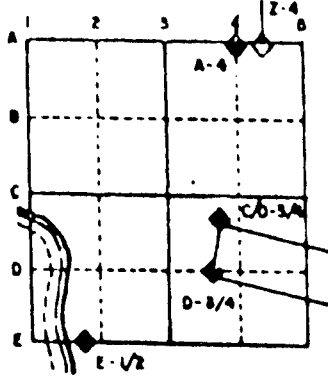

Rock TWP
ROCK COUNTY WI


IF AVAILABLE
STATE PLANE COORDINATES

North (Y) _____ Eleve. (Z) _____
 East (X) _____ Zone _____
 Hor. Datum _____ Vert. Datum _____

◆ CORNER MONUMENT

○ WITNESS MONUMENT

BEARINGS ARE BASED ON:

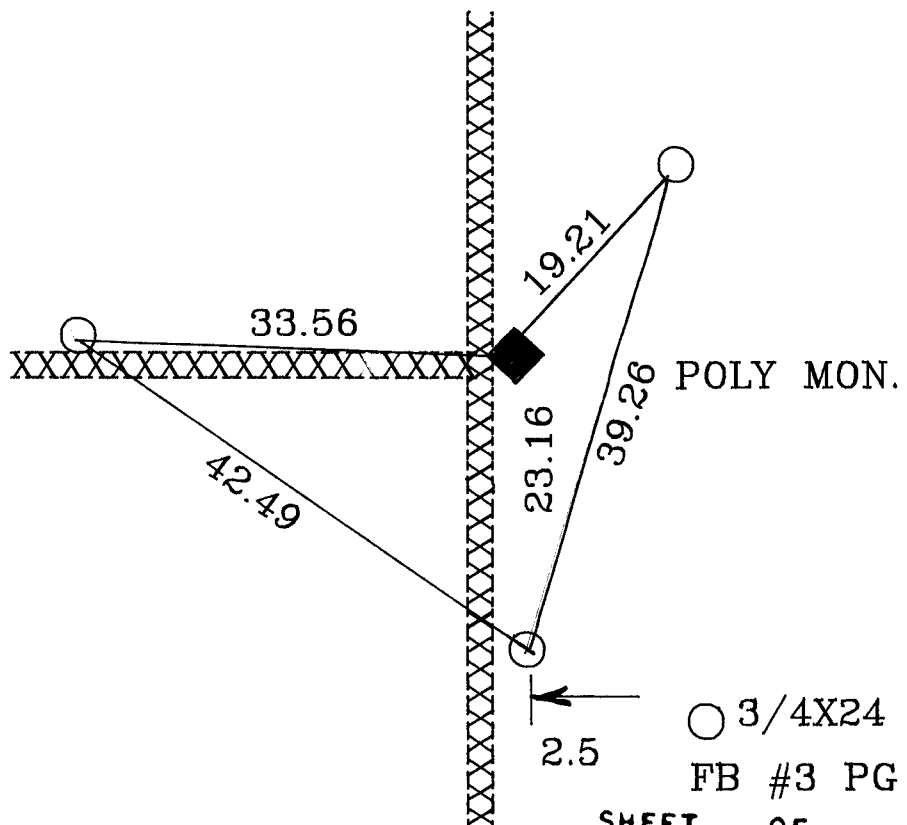

○ 3/4X24 REROD

FB #3 PG 37

SHEET _____ OF _____

CORNER CODE: c9

(B) Describe any record evidence, monument evidence, occupational evidence, testimonial evidence or any other material evidence you considered, and whether the monument was found or placed.

1836 LYON ORIGINAL GOVERNMENT SURVEY. 2743.62 TO NE & 2640 TO SE CORNERS OF SECTION 5.

1867 LEE VOL 1 PG 333 FOUND OLD FENCE POST AT CORNER. CALLS FOR 2653.53 FROM E 1/4 CORNER OF SECTION 5 TO CENTER OF SECTION 5, 2766.72' FROM N 1/4 CORNER TO CENTER OF SECTION 5, 2657.59 TO SE & 2769.36' TO NE CORNERS OF SECTION 5.

DUG 1' DEEP ABOUT 2' AROUND FENCE INTERSECTION. PLACED POLY MONUMENT ON LINE WITH E/W FENCE & 2.5 EAST OF N/S FENCE. PLACED CARSONITE POST NEXT TO MONUMENT. FOUND OLD N/S FENCE DOWN & JUST EAST OF EXISTING N/S FENCE. 2651.28 (REC 2653.53)' TO INTERSECTION OF 1/4 LINES & 2763.09' (REC 2766.72) FROM N 1/4 CORNER SECTION 5 TO INTERSECTION OF 1/4 LINES.

C) Was the corner restored through acceptance of (1) an obliterated evidence location, or, (2) a found perpetuated location?

CORNER RESTORED THROUGH ACCEPTANCE OF OBLITERATED EVIDENCE LOCATION. ACCEPTED FENCE LOCATION WHICH WAS IN HARMONY WITH OLD SURVEYS.

D) Describe any material discrepancy between the location of the corner as restored or reestablished and the location of that corner as previously restored or reestablished by distance and direction. Show the discrepancy on the plan view drawing under (a), above. Show the distances between the corner as previously restored or reestablished and (1) the corner as restored or reestablished, and (2) to at least 4 of the witness monuments shown on the drawing in (a), above.

(E) Was the corner reestablished through lost corner proportionate methods? If so, show the method, including the directions and distances to other public land survey corners used as evidence or used for proportioning the corner location.

NO

I, Donald Barnes, hereby certify that the corner points as identified by the corner code index were, in a field survey on, Nov 29, 1990, established, re-established, monumented, re-monumented, recovered or restored as expressed below and in conformance with the regulations and rules as required in the current manual of survey instructions of the United States Department of Interior, Bureau of Land Management.

seal
Donald Barnes
AUG 11 1990

COUNTY SURVEYOR FILING DATA

Date of computer entry _____

Date microfilmed _____

Number of included sheets _____
CORNER CODE

AFFIX YOUR LAND SURVEYOR SEAL

19