U.S.

PUBLIC LAND MONUMENT RECORD


S	J	J	R	7	7	E	•	Y	
-									

For Public Land Survey Corners in:

WI ADMINISTRATIVE CODE A-E 7.08 REQUIREMENT

T. ZN., R. 12 E

CORNER CODE INDEX

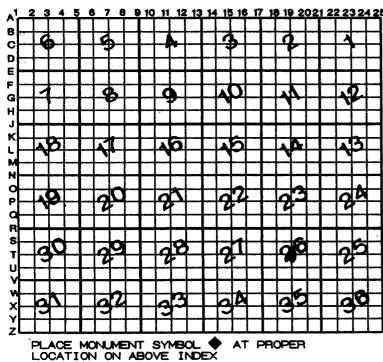

ROCK ROCK COUNTY WI

IF AVAILABLE ROCK COUNTY COORDINATES PERFERRED

North Elev.

East

Hor. Datum _____ Vert, Datum

LATITUDE __ ELLIPS. HT.

LONGITUTE

GPS (X) ___ TRAVERSE (X) ___

BASED ON THE FOLLOWING CONTROL:

◆CORNER MONUMENT

WITNESS MONUMENT

BASED ON: BEARINGS ARE

(a)

SHEET . _PAGE # FIELD BOOK _ SHOW A PLAN VIEW DRAWING DEPICTING THE CORNER MONUMENT AND SURROUNDING PHYSICAL FEATURES, INCLUDING THE EXCAVATION AREA AND DEPTH. PLANNING & ZONING COMMITTEE ADOPTED THE ABOVE FORM ON 12/2/1982

RO1598

- (B) Describe any record evidence, monument evidence, occupational evidence, testimonial evidence or any other material evidence you considered, and whether the monument was found or placed.
- 1873 RUGER- VOL 2 PG 110 INTERSECTED 1/4 LINES. DROVE STAKE. SAID STAKE IS IN LINE WITH E & W FENCE & ABOUT 9.24' WEST OF N & S FENCE. 2645.28' TO E 1/4 COR SEC 26, 2643.96' TO S 1/4 COR SEC 26, & 2627.13' TO W 1/4 COR SEC 26.
- 1882 LEE- VOL 2 PG 370 FOUND FENCES DESCRIBED BY RUGER & FROM THERE DETERMINED THE POSITION OF THE CORNER. 2645.28' TO E 1/4 COR SEC 26.
- 1960 SHIMEALL- MAP #5356 STONE AT CENTER OF SEC 26. S0-05E 403.30 TO PIPE AT CENTER OF HAPPY HOLLOW ROAD & S89-28E 2646.07 TO STONE AT E 1/4 COR SEC 26.
- 196? SHIMEALL- MAP #5371 4"X5" STONE AT CENTER OF SEC 26. S0-05E 250.00 TO A PIPE, S89-28E 758.67 TO A PIN, & S89-28E 2646.07 TO A 7"X10"X12" STONE AT THE E 1/4 COR SEC 26
- 1964 LEE- MAP #4234, 5233, & 4232 DUG AND FOUND NOTHING. SET MONUMENT AT INTERSECTION OF CENTERLINES OF SECTION 26. 1323.65 TO S 1/16TH COR OF NE 1/4 OF SEC 26, 2647.3 TO E 1/4 COR SEC 26.
- COR OF NE 1/4 OF SEC 26, 2647.3 TO E 1/4 COR SEC 26.

 1964 LEE- MAP #4230 & #5350 CALLS FOR CONC. MON & 1323.65 TO S 1/16TH COR OF NE 1/4 SEC 26, 2639.1' TO E 1/4 COR SEC 26, 400.18' TO CENTER OF HAPPY HOLLOW ROAD, AND ANGLE OF 90-37 AT CENTER OF SECTION 26 FROM N 1/4 COR SEC 26 TO E 1/4 COR SEC 26.
- 1964 LEE- MAP #4235 CALLS FOR A CONC. MON. AT CENTER OF SEC 26 & 2647.29 TO E 1/4 COR SEC 26.
- 1964 BATTERMAN- MAPS #3958,6851,6852,4185,4205,6853,4246 SET CONC. MON. S89-51-25E 2647.30 TO E 1/4 COR SEC 26, N89-51-25W 1315.45 TO A CONC. MON., N89-51-25W 2630.9' TO W 1/4 COR SEC 26, S0-28-25E 2646.60 TO S 1/4 COR SEC 26, N0-28-25W 2648.66 TO N 1/4 COR SEC 26.
- 1967 SHIMEALL- MAP #6915 STONE AT CENTER OF SEC 26 & S0-05E 821.03 TO PIPE.
- 1971 SHIMEALL- CSM VOL 2 PG 35 FOUND STONE AT CORNER. SOUTH 821.03 TO PIPE.
- 1973 LEE- CSM VOL 3 PG 88 SYMBOL CALLS FOR CONCRETE MONUMENT. 2647.07 TO E 1/4 COR SEC 26 & AT CENTER OF SECTION AN ANGLE OF 89-23 FROM E 1/4 COR SEC 26 TO A MONUMENT AT CENTER OF HAPPY HOLLOW ROAD. DISTANCE TO MONUMENT AT CENTER OF ROAD IS 403.30'.
- 1989 BARNES- VOL 6 PG 396 MAP SHOWS RECORD MEASUREMENTS. LEE 1964 2646.58 TO N 1/4 COR SEC 26, LEE 1964 2639.1 TO E 1/4 COR SEC 26, ANGLE BY LEE IN 1964 FROM N 1/4 COR SEC 26 TO N 1/16TH COR OF SE 1/4 SEC 26 OF 90-39, & ANGLE BY SHIMEALL IN 1960 FROM E 1/4 COR SEC 26 TO S 1/4 COR SEC 26 OF 89-23.
- 1996 JIM BRINKMAN REPORTED THE CONCRETE MONUMENT WAS BUSTED INTO MANY SMALL PIECES. HE DUG AND COULD NOT FIND A PART THAT WOULD PERPETUATED THE MONUMENT.

THIS RECORD IS FOR THE SOLE PURPOSE OF CONSOLIDATING RECORD EVENTS CONCERNING THE CENTER OF SECTION 26.

D) Describe any material discrepancy between the location of the corner as restored or reestablished and the location of that corner as previously restored or reestablished by distance and direction. Show the discrepancy on the plan view drawing under (a), above. Show the distances between the corner as previously restored or reestablished and (1) the corner as restored or reestablished, and (2) to at least 4 of the witness monuments shown on the drawing in (a), above.

RECORDS SEEM TO INDICATE THAT SHIMEALL USED A FOUND STONE AT THE CENTER OF SECTION 26 AND LEE INSTALLED A CONCRETE MONUMENT AT THE INTERSECTION OF THE 1/4 LINES.

Pould Barnes

Number of included sheets

OCT 30,1996

CORNER CODE