

# U.S. PUBLIC LAND SURVEY MONUMENT RECORD


For Public Land Survey Corners in the  
T. 2 N., R. 12 E.

## CORNER CODE INDEX

|   |   |   |   |    |    |    |    |    |    |    |    |    |    |    |    |    |    |    |    |    |    |    |    |    |    |
|---|---|---|---|----|----|----|----|----|----|----|----|----|----|----|----|----|----|----|----|----|----|----|----|----|----|
|   | 1 | 2 | 3 | 4  | 5  | 6  | 7  | 8  | 9  | 10 | 11 | 12 | 13 | 14 | 15 | 16 | 17 | 18 | 19 | 20 | 21 | 22 | 23 | 24 | 25 |
| A |   |   |   |    |    |    |    |    |    |    |    |    |    |    |    |    |    |    |    |    |    |    |    |    |    |
| B |   |   |   |    |    |    |    |    |    |    |    |    |    |    |    |    |    |    |    |    |    |    |    |    |    |
| C | 6 |   |   |    |    |    |    |    |    |    |    |    |    |    |    |    |    |    |    |    |    |    |    |    |    |
| D |   | 5 |   |    |    |    |    |    |    |    |    |    |    |    |    |    |    |    |    |    |    |    |    |    |    |
| E |   |   | 4 |    |    |    |    |    |    |    |    |    |    |    |    |    |    |    |    |    |    |    |    |    |    |
| F |   |   |   | 3  |    |    |    |    |    |    |    |    |    |    |    |    |    |    |    |    |    |    |    |    |    |
| G |   |   |   |    | 2  |    |    |    |    |    |    |    |    |    |    |    |    |    |    |    |    |    |    |    |    |
| H | 7 |   |   |    |    |    |    |    |    |    |    |    |    |    |    |    |    |    |    |    |    |    |    |    |    |
| I |   | 8 |   |    |    |    |    |    |    |    |    |    |    |    |    |    |    |    |    |    |    |    |    |    |    |
| J |   |   | 9 |    |    |    |    |    |    |    |    |    |    |    |    |    |    |    |    |    |    |    |    |    |    |
| K |   |   |   | 10 |    |    |    |    |    |    |    |    |    |    |    |    |    |    |    |    |    |    |    |    |    |
| L |   |   |   |    | 11 |    |    |    |    |    |    |    |    |    |    |    |    |    |    |    |    |    |    |    |    |
| M |   |   |   |    |    | 12 |    |    |    |    |    |    |    |    |    |    |    |    |    |    |    |    |    |    |    |
| N |   |   |   |    |    |    | 13 |    |    |    |    |    |    |    |    |    |    |    |    |    |    |    |    |    |    |
| O |   |   |   |    |    |    |    | 14 |    |    |    |    |    |    |    |    |    |    |    |    |    |    |    |    |    |
| P |   |   |   |    |    |    |    |    | 15 |    |    |    |    |    |    |    |    |    |    |    |    |    |    |    |    |
| Q |   |   |   |    |    |    |    |    |    | 16 |    |    |    |    |    |    |    |    |    |    |    |    |    |    |    |
| R |   |   |   |    |    |    |    |    |    |    | 17 |    |    |    |    |    |    |    |    |    |    |    |    |    |    |
| S |   |   |   |    |    |    |    |    |    |    |    | 18 |    |    |    |    |    |    |    |    |    |    |    |    |    |
| T |   |   |   |    |    |    |    |    |    |    |    |    | 19 |    |    |    |    |    |    |    |    |    |    |    |    |
| U |   |   |   |    |    |    |    |    |    |    |    |    |    | 20 |    |    |    |    |    |    |    |    |    |    |    |
| V |   |   |   |    |    |    |    |    |    |    |    |    |    |    | 21 |    |    |    |    |    |    |    |    |    |    |
| W |   |   |   |    |    |    |    |    |    |    |    |    |    |    |    | 22 |    |    |    |    |    |    |    |    |    |
| X |   |   |   |    |    |    |    |    |    |    |    |    |    |    |    |    | 23 |    |    |    |    |    |    |    |    |
| Y |   |   |   |    |    |    |    |    |    |    |    |    |    |    |    |    |    | 24 |    |    |    |    |    |    |    |
| Z |   |   |   |    |    |    |    |    |    |    |    |    |    |    |    |    |    |    | 25 |    |    |    |    |    |    |
|   |   |   |   |    |    |    |    |    |    |    |    |    |    |    |    |    |    |    |    | 26 |    |    |    |    |    |
|   |   |   |   |    |    |    |    |    |    |    |    |    |    |    |    |    |    |    |    |    | 27 |    |    |    |    |
|   |   |   |   |    |    |    |    |    |    |    |    |    |    |    |    |    |    |    |    |    |    | 28 |    |    |    |
|   |   |   |   |    |    |    |    |    |    |    |    |    |    |    |    |    |    |    |    |    |    |    | 29 |    |    |
|   |   |   |   |    |    |    |    |    |    |    |    |    |    |    |    |    |    |    |    |    |    |    |    | 30 |    |
|   |   |   |   |    |    |    |    |    |    |    |    |    |    |    |    |    |    |    |    |    |    |    |    |    | 31 |
|   |   |   |   |    |    |    |    |    |    |    |    |    |    |    |    |    |    |    |    |    |    |    |    |    | 32 |
|   |   |   |   |    |    |    |    |    |    |    |    |    |    |    |    |    |    |    |    |    |    |    |    |    | 33 |
|   |   |   |   |    |    |    |    |    |    |    |    |    |    |    |    |    |    |    |    |    |    |    |    |    | 34 |
|   |   |   |   |    |    |    |    |    |    |    |    |    |    |    |    |    |    |    |    |    |    |    |    |    | 35 |
|   |   |   |   |    |    |    |    |    |    |    |    |    |    |    |    |    |    |    |    |    |    |    |    |    | 36 |

PLACE MONUMENT SYMBOL (◆) AT PROPER LOCATION ON ABOVE INDEX

### EXAMPLE

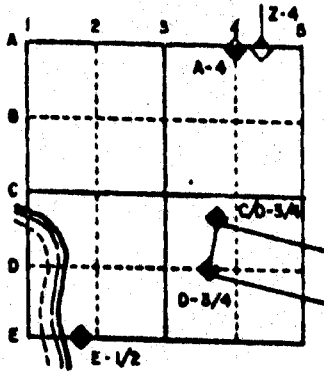

ROCK TWP  
ROCK COUNTY WI


IF AVAILABLE  
STATE PLANE COORDINATES

North (Y) \_\_\_\_\_ Eleve. (Z) \_\_\_\_\_  
 East (X) \_\_\_\_\_ Zone \_\_\_\_\_  
 Hor. Datum \_\_\_\_\_ Vert. Datum \_\_\_\_\_

◆ CORNER MONUMENT

○ WITNESS MONUMENT

BEARINGS ARE BASED ON: ROCK TWP PROJECT

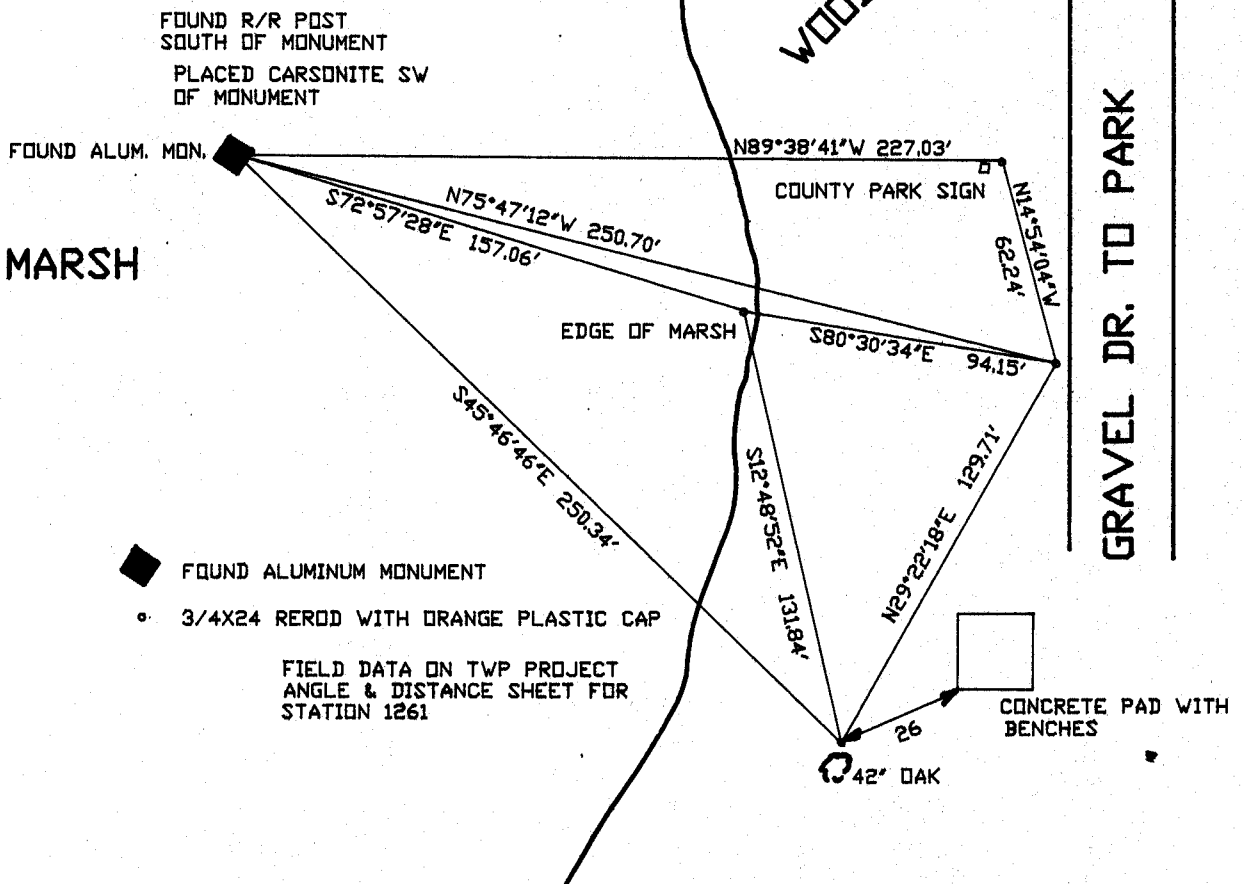

◆ FOUND ALUMINUM MONUMENT  
 ○ 3/4X24 REROD WITH ORANGE PLASTIC CAP

FIELD DATA ON TWP PROJECT  
ANGLE & DISTANCE SHEET FOR  
STATION 1261

# MICROFILMED

SHEET \_\_\_ OF \_\_\_

CORNER CODE: V19

(B) Describe any record evidence, monument evidence, occupational evidence, testimonial evidence or any other material evidence you considered, and whether the monument was found or placed.

1864 LOCKE VOL 1 PG 198 SHOWS 798.6' TO SOUTHERLY MEANDER CORNER, 235.62 TO A CORNER THAT IS NORTH, AND ESTABLISHED MANY CORNERS THAT ARE ON THE SOUTH LINE OF THE SW QUARTER OF SECTION 26.

1873 RUGER VOL 2 PG 110 FOUND BOTH BEARING TREES AND OLD STAKE. SET LIMESTONE 18X9X4. SHOWS 2635.38 TO SE CORNER OF SECTION 26 AND 2643.96 TO CENTER OF SECTION 26.

1889 BLEEDORN VOL 2 PG 423 FOUND LIMESTONE SET BY RUGER ALSO STUMPS OF BEARING TREES. SET BIG HARDHEAD ON NORTH. STUMP IS ON SOUTH AND 2 SMALL HARDHEADS ON E AND WEST SIDES. SHOWS 974.82 TO A CORNER THAT IS TO THE WEST AND 235.62 TO LARGE HH THAT IS TO THE NORTH AND 415.14 TO A LIMESTONE THAT IS TO THE NORTH.

1980 BARNES VOL 6 PG 67. FOUND 2" IRON PIPE, REPLACED WITH ALUMINUM MONUMENT. SHOWS DISTANCES BY COMBS, SHIMEALL, AND BARNES TO CORNERS THAT ARE ALONG THE N/S LINE OF SECTION 26. ALSO SHOWS S79-23-36E 1318.86 TO THE S 1/16th CORNER OF THE SE 1/4 OF SECTION 26. SHOWS THAT COMBS MEASURED 1318.47 FOR THAT LINE. SHOWS S79-25-18E 1319.79 FROM THE SE CORNER OF SECTION 26 TO THAT 1/16th CORNER.

1989 BARNES VOL 6 PG 396 SHOWS SHIMEALL'S 1957 DISTANCE OF 2638.66 TO THE SE CORNER OF SECTION 26.

FOUND ALUMINUM MONUMENT.



C) Was the corner restored through acceptance of (1) an obliterated evidence location, or, (2) a found perpetuated location?

ACCEPTED FOUND PERPETUATED LOCATION.

D) Describe any material discrepancy between the location of the corner as restored or reestablished and the location of that corner as previously restored or reestablished by distance and direction. Show the discrepancy on the plan view drawing under (a), above. Show the distances between the corner as previously restored or reestablished and (1) the corner as restored or reestablished, and (2) to at least 4 of the witness monuments shown on the drawing in (a), above.

(E) Was the corner reestablished through lost corner proportionate methods? If so, show the method, including the directions and distances to other public land survey corners used as evidence or used for proportioning the corner location.

I, Donald Barnes, hereby certify that the corner points as identified by the corner code index were, in a field survey on, October 19 1990, established, re-established, monumented, re-monumented, recovered or restored as expressed below and in conformance with the regulations and rules as required in the current manual of survey instructions of the United States Department of Interior, Bureau of Land Management.

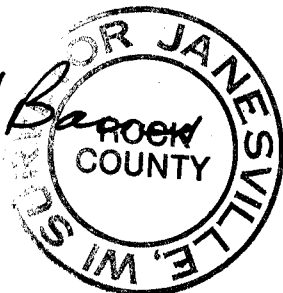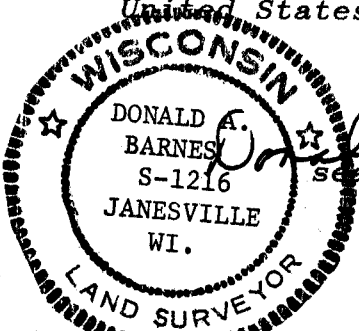

COUNTY SURVEYOR FILING DATA

Date of computer entry \_\_\_\_\_

Date microfilmed \_\_\_\_\_

Number of included sheets \_\_\_\_\_  
CORNER CODE

AFFIX YOUR LAND SURVEYOR SEAL