

U.S. PUBLIC LAND SURVEY MONUMENT RECORD


For Public Land Survey Corners in the
T. 2 N., R. 12 E.

CORNER CODE INDEX

	1	2	3	4	5	6	7	8	9	10	11	12	13	14	15	16	17	18	19	20	21	22	23	24	25
A																									
B																									
C	6																								
D		5																							
E			4																						
F				3																					
G					2																				
H	7																								
I		8																							
J			9																						
K				10																					
L					11																				
M						12																			
N	13																								
O		14																							
P			15																						
Q				16																					
R					17																				
S						18																			
T							19																		
U								20																	
V									21																
W										22															
X											23														
Y												24													
Z													25												
														26											
															27										
																28									
																	29								
																		30							
																			31						
																				32					
																					33				
																						34			
																							35		
																								36	

PLACE MONUMENT SYMBOL (◆) AT PROPER LOCATION ON ABOVE INDEX

EXAMPLE

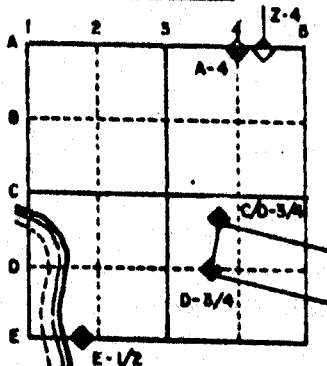

ROCK TWP
ROCK COUNTY WI

IF AVAILABLE
STATE PLANE COORDINATES


North (Y) _____ Elev. (Z) _____
 East (X) _____ Zone _____
 Hor. Datum _____ Vert. Datum _____

e.)

◆ CORNER MONUMENT

○ WITNESS MONUMENT

BEARINGS ARE BASED ON: ASSUMED

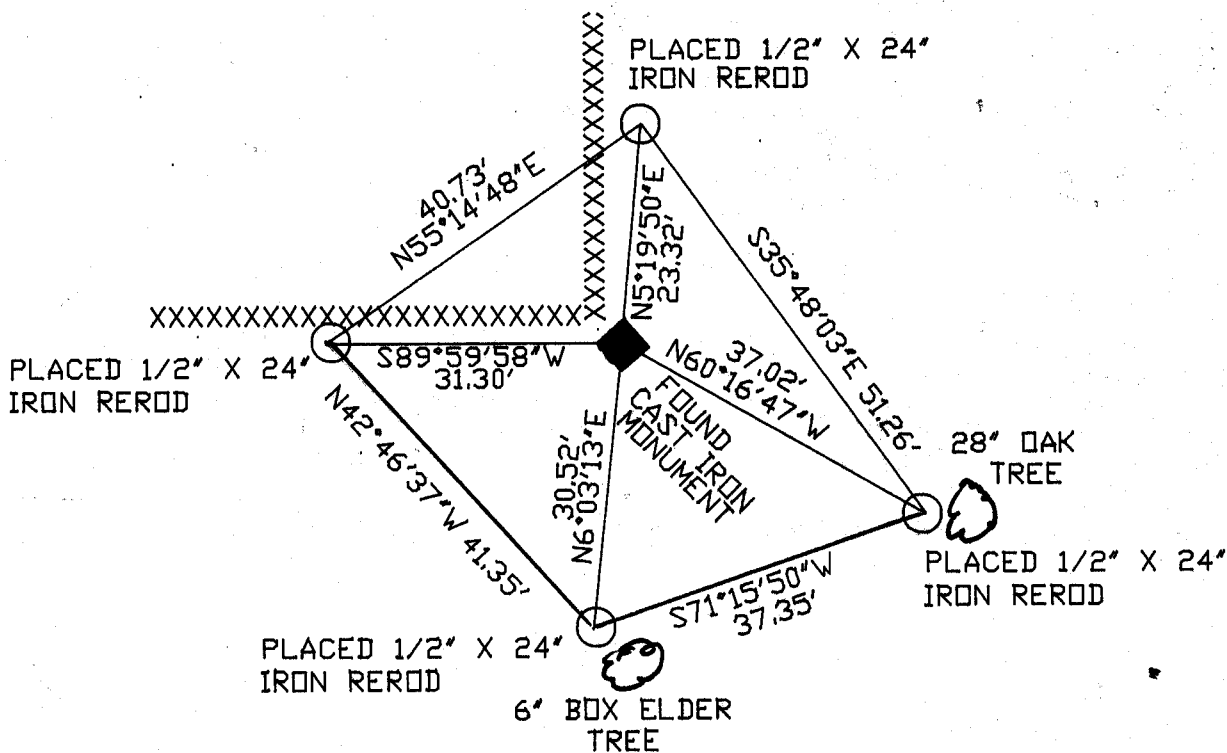

MICROFILMED

SHEET ___ OF ___

CORNER CODE: 29

(B) Describe any record evidence, monument evidence, occupational evidence, testimonial evidence or any other material evidence you considered, and whether the monument was found or placed.

1833 MULLETT ORIGINAL GOVERNMENT SURVEYOR. FIELD NOTES - SET POST CORNER SECTIONS 32 & 33 IN MARSH AND MADE MOUND . FLAG BUSHES WILLOW GRASS

1834 HARRISON ORIGINAL GOVERNMENT SURVEYOR. FIELD NOTES - INTERSECTED NORTH BOUNDARY IN MARSH 158.40' WEST OF POST. SET POST FOR CORNERS SECTION 4 & 5 AND RAISED TUSSACK MOUND.

1855 CHURCH VOL 1 PG 30 SHOWS 2646.27 TO THE W 1/4 CORNER OF SECTION 33 AND 2655.84 TO THE S 1/4 CORNER OF SECTION 33.

1971 LEE VOL 4 PG 539 SET CAST IRON MONUMENT. SHOWS 158.40 TO THE NE CORNER OF SECTION 5 AND 2671 TO THE S 1/4 CORNER OF SECTION 32.

1981 BARNES VOL 6 PG 143. SHOWS N89-36-32E 2669.30 TO S 1/4 CORNER OF SEC 32, BATTERMAN 1952 2653.47 TO W 1/4 CORNER OF SECTION 33, BATTERMAN 1952 2603 TO THE S 1/4 CORNER OF SECTION 33. ALSO SHOWS 5381.18 TO THE SE CORNER OF SECTION 33.

FOUND CAST IRON MONUMENT.

C) Was the corner restored through acceptance of (1) an obliterated evidence location, or, (2) a found perpetuated location?

ACCEPTED FOUND MONUMENT.

D) Describe any material discrepancy between the location of the corner as restored or reestablished and the location of that corner as previously restored or reestablished by distance and direction. Show the discrepancy on the plan view drawing under (a), above. Show the distances between the corner as previously restored or reestablished and (1) the corner as restored or reestablished, and (2) to at least 4 of the witness monuments shown on the drawing in (a), above.

(E) Was the corner reestablished through lost corner proportionate methods? If so, show the method, including the directions and distances to other public land survey corners used as evidence or used for proportioning the corner location.

I, Donald Barnes, hereby certify that the corner points as identified by the corner code index were, in a field survey on, July 20, 1990, established, re-established, monumented, re-monumented, recovered or restored as expressed below and in conformance with the regulations and rules as required in the current manual of survey instructions of the United States Department of the Interior, Bureau of Land Management.

COUNTY SURVEYOR FILING DATA

Date of computer entry _____

Date microfilmed _____

Number of included sheets _____

CORNER CODE

29

AFFIX YOUR LAND SURVEYOR SEAL

