Paper weight-110# (minimum)

Black nonfading ink required

# U.S. PUBLIC LAND SURVEY MONUMENT RECORD


For Public Land Survey Corners In:

WI ADMINISTRATIVE CODE A-E 7.08 REQUIREMENT

REV 10/23/2004 USMONREC.DWG

T. 4 N. R. 10 E. 4th P.M.

CORNER CODE INDEX

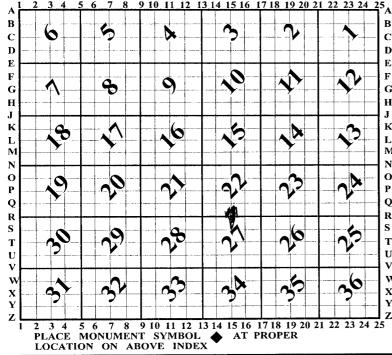

# UNION TWP

IF AVAILABLE ROCK COUNTY COORDINATES PERFERRED

North	Elev
East	
Hor. Datum	Vert. Datum
LATITUDE	ELLIPS. HT.
LONGITUDE	
NAD83(91)	NETWORK ADJ. YR 2010
GPS (X)	TRAVERSE (X) X
BASED ON THE	FOLLOWING CONTROL:

**◆ CORNER MONUMENT** 

WITNESS MONUMENT

FIELD BOOK \_\_\_\_\_ PAGE # \_\_\_\_ OR OBSERVATION SHEET \_\_\_\_ OF SHOW A PLAN VIEW DRAWING DEPICTING THE CORNER MONUMENT AND SURROUNDING PHYSICAL FEATURES, INCLUDING THE EXCAVATION AREA AND DEPTH.
PLANNING & ZONING COMMITTEE ADOPTED THIS FORM ON 12/2/1982

#### N1/4CORSEC 27

(B) Describe any record evidence, monument evidence, occupational evidence, testimonial evidence or any other material evidence you considered, and whether the monument was found or placed.

1833 HARRISON TAN RIDE 4TH MER EAST BET. SECS 22 & 27

C? CREEK CRS SE 828.96

2640.00 TEMPY 1/4 SEC COR 5214.00 INT. E BDY 33.0 N OF P LAND & SAME WEST COR WEST BET 22 & 27

2607.00 QUARTER SEC COR {WO 36 S19E 29.04'; WO 29 N45W 50.16' WO 36 & WO 29 MARKED

5214.00 SEC COR

LOCKE VOL 1 PG 330 & #5207 USED TO SUBDIVIDE SEC 1866 27. FD STUMPS OF BTS & REMAINS OF OLD STAKE. SET STAKE WITH LARGE HH ON E & W AND SMALLER ON N & S.

RUGER AUG REMON-98 AUGUST 30, 1870 WEST ON NORTH LINE OF NE 1/4 SEC 27 ON A

VAR 7-00'; OFFSET NORTH 14.52' AT

2616.90 INTERSECTED QUARTER LINE 19.14' NORTH OF QUARTER CORNER. FOUND STAKE SURROUNDED BY HARD HEAD STONES SET BY LOCKE AT CORNER. ALSO FOUND STUMPS OF BEARING TREES. TESTED STAKE AND FOUND IT CORRECT. COR VAR 7-06

> WEST ON NORTH LINE OF NW 1/4 SEC 27 ON A VAR 7-00 AT

2632.08 INTERSECTED WET BOUNDARY LINE 6.6' NORTH CORNER. COR VAR 7-09

- RUGER VOL 2 PG 398 STATES NOTHING ABOUT MON. CALLS FOR 2665.08 TO CEN OF SEC 27
- ELY VOL 3 PG 108 FD LIMESTONE. CALLS FOR NORTH 338 1921 TO CEMETERY BOUNDARY
- UNKOWN VOL 3 PG 123 ESTABLISHED TIES BUT STATES 1924 NOTHING ABOUT MON.
- 1931 WIDOT STH 92 PROJ 1341 SHEET 1 STATES NOTHING ABOUT MON
- 1938 SUNNY VOL 3 PG 405 FD PIPE IN CONCRETE RD OF STH 13. 2623.2X TO STONE @ SE COR SEC 22. PENCILED: MD 5327.2 TO N 1/4 COR SEC 22
- 1950 SUNNY #5160 & #6996 PIPE IN USH 13 & 14. NORTHERLY 338' TO PIPE @ SE CORNER OF HOLY CROSS CEMETERY
- 19?? WIDOT R-15(3) R/W PROJ 5670.00-21 ALUM MON. 287,865.41; 2,2188,180.87 REFERENCED CORNER. TIES ARE ON SHEET #5.5 STATE PROJ 5155-0-73
- KENNING #6997 APPROXIMATE LOCATION OF S 1/4 COR 1965 SEC 22. COULD FIND NO IRON PINS IN PVMT OR OTHER IDENTIFYING MARKS. PROPERTY OWNER ALSO CONFIRMED APPROXIMATE LOCATION. SHOWS IN USH 14 338' SOUTH OF SOUTH CEMETERY BDY
- LEE CSM VOL 7 PG 77 PK SOUTH 3.46 ALONG CENTER OF RD.
- BARNES VOL 5 PG 351 DUG HOLE 3X6X 3 DEEP & FD 1977 NOTHING. SET COR BY USING SUNNY'S SURVEY OF 1959. THIS AGREED WITH THE OCCUPATION LINES AT HOLY CROSS CEMETERY. HOLY CROSS CEMETERY WAS SURVEYED BY ELY IN 1921 & RECORDED IN COUNTY SURVEYOR'S RECORD VOL3 PG 108. SET ALUM MON & REFERENCED SAME. MAPS SHOWS FD PROPERTY CORNERS WITH RECORD & MEASURED DISTANCES.S
- DOT R-15 STATE PROJ #5155-0-73 SHEET #5.5 MAP #??? 19?? ALUM MON WITH TIES.
- 1980 DOT STH 59 #11806 & 6665 ALUM MON 287,865.41; 2,188,180.87
- WIDOT STH 14 PROJ 5670-00-21 SHEET 4.1 #11327 ALUM 1980 287,2,188,180.87

SHEET 1 OF 3

CORNER CODE R-15(5)

- UN588 N1/4CORSEC 27
- 1982 BARNES R-15(1) FD MON. BOX WITH ALUM. MON. 0.3 DEEP. 1.5 WEST OF N/S PVMT CENTER.
- 1982 COMBS #5173 FD ALUM. MON
- 1984 GRENSKE #14054 ALUM. N1-11-21W 263.47, USED CUT STONE @ NW COR SEC 27 FOR LINE.
- 1984 GENSKE ASSESSORS PLAT SHEET 4. #14063 CUT STONE.
- 1985 SCHROEDER CSM VOL 12 PG 192 STATES NOTHING ABOUT MON.
- 1985 COMBS CSM VOL 12 PG 179 STATES NOTHING ABOUT MONUMENTS @ N 1/4 & S 1/4 COR SEC 27. FROM S 1/4 27 TO LOT CORNER IS N78-11-40W 93.5X
- 1985 BARNES VOL 6 PG 337 MAP SHOWS 2672.4 TO INTERSECTION OF 1/4 LINES IN SEC 27, N88-46E 2619 TO NE COR SEC 27, & S1-08E 5340.9 TO S 1/4 COR SEC 27
- 1989 COMBS CSM VOL 13 PG 521 ALUM WEST 30.35 ON LINE TO FD STONE @ NW COR SEC 27
- 1990 WOODMAN P-32 PG 70 ALUM. 2642.68 TO STONE @ NW COR SEC 27
- 1990 SCHNEEBERGER "ASSESSORS PLAT SHEET #5" #1421 FD CONC. MON N89-46-29E 2619.70 TO CONC. @ NE COR SEC 27. N89-46-29E 3.78 TO HIGHWAY R/W REFERENCE LINE.
- 1994 BARNES R-15(2) FD ALUM. MON INSIDE MON. BOX. REF. COR. FIELD BK #2 PG 25.
- 1996 KARNS CSM VOL 19 PG 58 ROCK COUNTY MON.
- 2000 BARNES R-15(3) FD MON. BOX CHISLED X ON COVER WAS NOT ABLE TO REMOVE COVER. REFERENCED SAME.
- 2000 BARNES VOL 6 PG 456 307,391.38; 419,092.14 FD MON. BOX N89-40-49W 2642.94 TO LS @ SW COR SEC 22, S89-35-06E 2619.79 TO FD LS @ SE COR SEC 22. FD MON BOX
- 2005 JENKINS #15068 FD ROCK COUNTY MON. 2642.68 TO CUT LS @ SW COR SEC 22
- 2010 COMBS R-15(4) REFERENCED SET MAG NAIL. FD 2
  REFERENCE MONUMENTS. USED THESE TO SET MAG. NAIL AT
  SECTION CORNER. IT'S LOCATION CHECKED WITHIN REASON
  TO PRELIMINARY ROCK COUNTY COORD. VALUE. NO-29-54W
  5340.83 TO N 1/4 COR SEC 22. BEARINGS ARE ASUMED NO29-54W ALONG NORTH-SOUTH CENTERLINE OF SECTION 274-10

#### USED MY OLD OBSERVATIONS TO DETERMINE POSITION.

C) Was the corner restored through acceptance of (1) an obliterated evidence location, or, (2) a found perpetuated location?

### ACCEPTED 1975 LOCATION.

D) Describe any material discrepancy between the location of the corner as restored or reestablished and the location of that corner as previously restored or reestablished by distance and direction. Show the discrepancy on the plan view drawing under (a), above. Show the distances between the corner as previously restored or reestablished and (1) the corner as restored or reestablished, and (2) to at least 4 of the witness monuments shown on the drawing in (a), above.

## NONE

- (E) Was the corner reestablished through lost corner proportionate methods? If so, show the method, including the directions and distances to other public land survey corners used as evidence or used for proportioning the corner location.
- I, **Donald Barnes**, hereby certify that the corner location as identified by the corner code index was determined by me under my direction and control and that this U.S. Public Land Survey Monument Record is correct and complete to the best of my knowledge and belief.

SHEET 2 OF 3

CORNER CODE R-15(5)

OT 24,201) A.E. 7.08 REQUIREMENT

