

Paper weight-110# (minimum)

Black nonfading ink required

# U.S. PUBLIC LAND SURVEY MONUMENT RECORD

For Public Land Survey Corners In:  
T. 4 N. R. 10 E. 4th P.M.  
CORNER CODE INDEX

WI ADMINISTRATIVE CODE A-E 7.08 REQUIREMENT  
REV 10/23/2004 USMONREC.DWG

UNION TWP  
ROCK COUNTY WI

IF AVAILABLE  
ROCK COUNTY COORDINATES PREFERRED

A	1	2	3	4	5	6	7	8	9	10	11	12	13	14	15	16	17	18	19	20	21	22	23	24	25	A
B																										B
C																										C
D																										D
E																										E
F																										F
G																										G
H																										H
J																										J
K																										K
L																										L
M																										M
N																										N
O																										O
P																										P
Q																										Q
R																										R
S																										S
T																										T
U																										U
V																										V
W																										W
X																										X
Y																										Y
Z																										Z

North \_\_\_\_\_ Elev. \_\_\_\_\_

East \_\_\_\_\_

Hor. Datum \_\_\_\_\_ Vert. Datum \_\_\_\_\_

LATITUDE \_\_\_\_\_ ELLIPS. HT. \_\_\_\_\_

LONGITUDE \_\_\_\_\_

NAD83(91) \_\_\_\_\_ NETWORK ADJ. YR 2010 \_\_\_\_\_

GPS (X) \_\_\_\_\_ TRAVERSE (X) X

BASED ON THE FOLLOWING CONTROL:  
\_\_\_\_\_

PLACE MONUMENT SYMBOL  AT PROPER LOCATION ON ABOVE INDEX

CORNER MONUMENT

WITNESS MONUMENT

(2)

ROCK COUNTY PROJECTION  
BEARINGS ARE BASED ON: \_\_\_\_\_

FIELD BOOK \_\_\_\_\_ PAGE # \_\_\_\_\_  
OR OBSERVATION SHEET \_\_\_\_\_

SHEET 1 OF 3

SHOW A PLAN VIEW DRAWING DEPICTING THE CORNER MONUMENT AND SURROUNDING PHYSICAL FEATURES, INCLUDING THE EXCAVATION AREA AND DEPTH.

PLANNING & ZONING COMMITTEE ADOPTED THIS FORM ON 12/2/1982

CORNER CODE N-15(3)

UN 568 NYA COR SEC 22

(B) Describe any record evidence, monument evidence, occupational evidence, testimonial evidence or any other material evidence you considered, and whether the monument was found or placed.

1833 (NOV) HARRISON T4N R10E 4<sup>TH</sup> MER. EAST ON RAMDOM  
BET 15 & 22

2640.00 TEMPY 1/4 SEC COR

5225.88 INT E BDY 19.8' N OF P LAND ? SAME

WEST COR WEST BET 15 & 22

2579.94 QUARTER SEC COR {W.O. 24 S25W 50.82';  
BURR O 18 N65W 45.54' W.O. 24 & BURR O  
14} MARKED

5225.88 SEC COR

1870 RUGER AUG REMON-97 EAST ON NORTH LINE OF NW 1/4  
SEC 22 ON A VAR 6-35; OFFSET NORTH 12.54'  
AT

2635.38 INTERSECTED QUARTER LINE 6.6' SOUTH OF  
QUARTER CORNER. FOUND STUMPS OF  
BEARING TREES AND ESTABLISHED QUARTER  
CORNER FROM THEM. COR VAR 7-00

REMON-98 WEST ON NORTH LINE OF NE 1/4

SEC 22 ON A VAR 6-30' OFFST NORTH 1.32'

OFFSET NORTH 20.46' OFFSET NORTH 6.6' AT

2634.72 INTERSECTED QUARTER LINE 13.2' NORTH OF  
QUARTER CORNER. ESTABLISHED QUARTER  
CORNER FROM STUMPS OF BEARING TREES.  
COR VAR 6-10'

1924 UNK VOL 3 PG 124 TIES STATES NOTHING ABOUT MON.  
SHOWS ON CENTER LINE OF RD & REFERENCED SAME.

1976 CHENEY CSM VOL 5 PG 249 STATES NOTHING ABOUT MON.  
SOUTH 1349.00 WITH S 1/4 COR SEC 22 AS LINE.

1976 WOODMAN CSM VOL 6 PG 150 ALUM MON N1-45-00W TO  
SET PK @ N 1/4 COR SEC 15

1976 BARNES VOL 5 PG 222 DUG & FD NO MONUMENT.  
GROUND ON BOTH SIDES OF RD INDICATES A CUT FOR ROAD  
CONSTRUCTION. SET W-1 BERNSTEN ALUM. MON AT OLD  
CENTER LINE OF RD & ON LINE WITH FENCE TO THE EAST.  
SEE COUNTY SURVEY RECORDS VOL 3 PG 124

1982 COMBS #5173 FD ALUM. MON.

1991 SCHROEDER CSM VO 15 PG 132 STATES NOTHING ABOUT  
MON

1992 SCHROEDER CSM VOL 15 PG 448 STATES NOTHING ABOUT  
MON

1994 BARNES N-15 FD PK. ACCEPTED FD MONUMENT. RD  
CONSTRUCTION WILL DISTURB AREA. FD REFERENCE PIPES

1996 KARNS CSM VOL 19 PG 58 ROCK COUNTY MON.

2000 BARNES VOL 6 PG 456 FD PK & TIES S89-04-50E TO FD  
BENT PIPE & TIES @ NE COR SEC 22, N89-30-30W 2636.37  
TO FD LS @ NW COR SEC 22 312,677.20; 421,740.22

2000 BARNES N-15(1) FD PK & REFERENCE PIPES.

2009 COMBS N-15(2) SET PK USING PREVIOUS TIE SHEET (D.  
BARNES 05/08/00) & FD REFERENCE MONUMENTS. NE  
REFERENCE MONUMENT APPEARS TO HAVE BEEN  
DISTURBED. DID NOT USE THIS MONUMENT IN SETTING PK  
NAIL. 5340.83 TO S 1/4 COR SEC 22.

2009 COMBS #16188 ST PK NO-17-15E 5335.99 TO SET PK @ S  
1/4 COR SEC 22 USING PREVIOUS TIE SHEET (D. BARNES 05-  
08-00) AND FD REFERENCE MONUMENTS. NE REFERENCE  
MONUMENT APPEARS TO HAVE BEEN DISTURBED. DID NOT  
USE THIS MONUMENT IN SETTING PK NAIL.

FD REFERENCE PIPES. DID NOT FIND PK.

SEAL  
Emboss  
N. J. Barnes  
OCT 24, 2011

SHEET 1 OF 3

CORNER CODE N-15(3)

UN568 N1/4CORSEC22

C) Was the corner restored through acceptance of (1) an obliterated evidence location, or, (2) a found perpetuated location?

ACCEPTED POSITION AS DETERMINED BY REFERENCE TIES.

D) Describe any material discrepancy between the location of the corner as restored or reestablished and the location of that corner as previously restored or reestablished by distance and direction. Show the discrepancy on the plan view drawing under (a), above. Show the distances between the corner as previously restored or reestablished and (1) the corner as restored or reestablished, and (2) to at least 4 of the witness monuments shown on the drawing in (a), above.

NONE, HOWEVER COMB'S DISTANCE OF 5340.83 TO THE S 1/4 COR SEC 22 IS GREATLY DIFFERENT FROM THE FOLLOWING:

		DIFFERENCE
1938 SUNNY 3-405	5327.2X	0.99'
2010 COMBS R-15(4)	5340.83	12.64
NO-05-49E	5328.19	

(E) Was the corner reestablished through lost corner proportionate methods? If so, show the method, including the directions and distances to other public land survey corners used as evidence or used for proportioning the corner location.

NO

I, Donald Barnes, hereby certify that the corner location as identified by the corner code index was determined by me under my direction and control and that this U.S. Public Land Survey Monument Record is correct and complete to the best of my knowledge and belief.

SEAL

SHEET 2 OF 3

Emboss

CORNER CODE

N-15(3)

A.E. 7.08 REQUIREMENT

OCT 24, 2011

N 1/4 COR  
 SEC 22  
 UNION TWP  
 T4N R10E


1976 BARNES VOL 5 PG 222  
 1994 BARNES N-15  
 2000 BARNES VOL 6 PG 456  
 2000 BARNES N-15(1)  
 2009 COMBS N-15(2)

CENTER TWP FB #2 PG 24

OBSERVATIONS SHEETS  
 93, 246, & 491

S86-49-41E 67.27  
 2009 S87-07-59E 67.43  
 2000 S86-50-02E 67.27  
 1994 S86-14-08E 67.27  
 1976 67.33

FD 1 1/2 PIPE  
 2000 FD 2" PIPE  
 1976 SET 2" PIPE  
 2009 MON. APPEARS  
 TO HAVE BEEN DISTURBED  
 DID NOT USE IN  
 SETTING PK

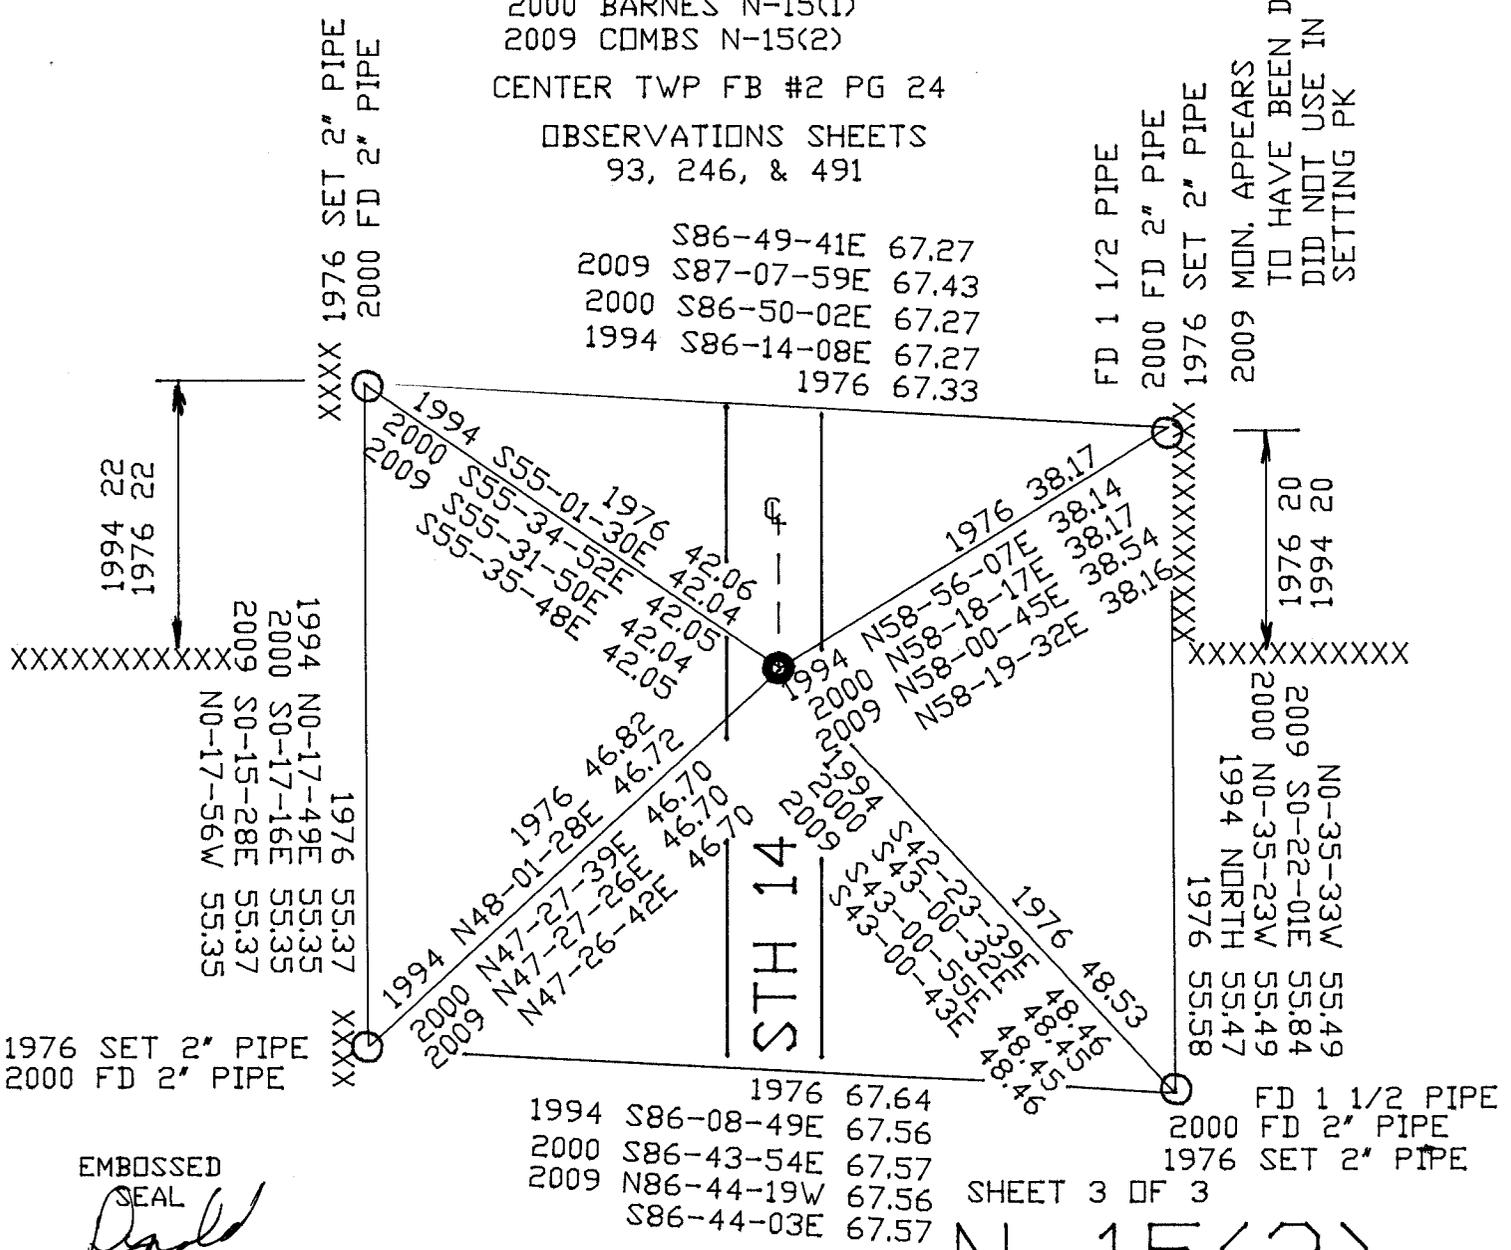

1976 67.64  
 1994 S86-08-49E 67.56  
 2000 S86-43-54E 67.57  
 2009 N86-44-19W 67.56  
 S86-44-03E 67.57

SHEET 3 OF 3

N-15(3)

EMBOSSED  
 SEAL  
*Dodd Barnes*  
 Oct 18, 2011