U.S.


PUBLIC LAND SURVEY MONUMENT RECORD

For Public Land Survey Corners in:

WI ADMINISTRATIVE CODE A-E 7.08 REQUIREMENT

NT. ZN., R. ∠Z__E

CORNER CODE INDEX

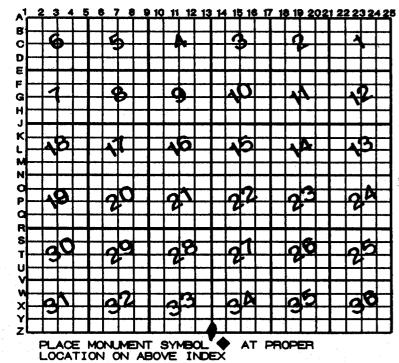

ROCK COUNTY WI

IF AVAILABLE
ROCK COUNTY COORDINATES PERFERRED

North _____ Elev. ____

East ____

Hor. Datum _____ Vert, Datum ____

_____ELLIPS. HT.

LONGITUTE

GPS (X) ___ TRAVERSE (X) ___

BASED ON THE FOLLOWING CONTROL:

♦CORNER MONUMENT

O WITNESS MONUMENT

LATITUDE

BEARINGS ARE BASED ON:

(a)

FIELD BOOK _____PAGE # _____ SHEET ____ OF ___
SHOW A PLAN VIEW DRAWING DEPICTING THE CORNER MONUMENT AND SURROUNDING
PHYSICAL FEATURES, INCLUDING THE EXCAVATION AREA AND DEPTH.
PLANNING & ZONING COMMITTEE ADOPTED THE ABOVE FORM ON 12/2/1982

- (B) Describe any record evidence, monument evidence, occupational evidence, testimonial evidence or any other material evidence you considered, and whether the monument was found or placed.
- 1833 MULLETT ORIGINAL GOVERNMENT SURVEYOR. FIELD NOTES SET POST IN PRAIRIE . CORNER SECTIONS 33 AND 34 AND RAISED A MOUND.
- 1834 HARRISON ORIGINAL GOVERNMENT SURVEYOR. FIELD NOTES -NORTH BETWEEN SECTION 3 & 4. INTERSECTED NORTH BOUNDARY 82.5' WEST OF POST NEAR EAST EDGE OF MARSH. SET A POST AND RAISED MOUND.
- 1855 CHURCH VOL 1 PG 30 2655.84 TO S 1/4 CORNER OF SECTION 33 AND 2632.08 TO THE E 1/4 CORNER OF SECTION 33.
- 1858 CHURCH VOL 1 PG 80 SHOWS 82.5 TO THE NW CORNER OF SECTION 3 BELOIT TOWNSHIP AND 2647.26 TO THE S 1/4 CORNER OF SECTION 34.
- 1874 RUGER VOL 2 PG 143. FOUND OLD STAKE IN HIGHWAY DROVE NEW STAKE DEEP IN PLACE OF OLD ONE AND PUT ON TOP OF IT LIMESTONE 16 X 6 X 3 1/2. THE CORNER IS 3.63' FEET SOUTH OF EAST WEST FENCE AND 32.01' FROM FENCE ON WEST SIDE OF ROAD AND 33.66' FROM FENCE ON EAST SIDE OF ROAD. SHOWS 81.84' TO THE NW CORNER OF SECTION BELOIT.,
- 19?? BATTERMAN VOL 3 PG 551. 1/2" PIN AT CORNER. SHOWS 81.77 TO THE NW CORNER OF SECTION 3 BELOIT TOWNSHIP.
- 1969 BATTERMAN VOL 4 PG 390 SET PIPE AT CORNER AND REFERENCED SAME. SHOWS 81.80' TO THE NW CORNER OF SECTION 3 BELOIT TOWNSHIP.
- 1981 BARNES VOL 6 PG 143. SHOWS BATTERMAN 1952 DISTANCE OF 2701 TO THE S 1/4 CORNER OF SECTION 33 AND RUGER'S 1874 DISTANCE OF 81.84' TO THE NE CORNER OF SECTION 4.
- 1990 BARNES FOUND 1X24" IRON PIPE AND REPLACED WITH ALUMINUM MONUMENT.

FOUND ALUM. MON. MONUMENT WILL BE DISTURBED BY ROAD CONSTRUCTION.

- C) Was the corner restored through acceptance of (1) an obliterated evidence location, or, (2) a found perpetuated location?
 ACCEPTED FOUND MONUMENT.
- D) Describe any material discrepancy between the location of the corner as restored or reestablished and the location of that corner as previously restored or reestablished by distance and direction. Show the discrepancy on the plan view drawing under (a), above. Show the distances between the corner as previously restored or reestablished and (1) the corner as restored or reestablished, and (2) to at least 4 of the witness monuments shown on the drawing in (a), above.
- (E) Was the corner reestablished through lost corner proportionate methods? If so, show the method, including the directions and distances to other public land survey corners used as evidence or used for proportioning the corner location.
- I, Donald Barnes, hereby certify that the corner points as identified by the corner code index were, in a field survey on, MARCH 25, 1998, established, re-established, monumented, remonumented, recovered or restored as expressed below and in conformance with the regulations and rules as required in the current manual of survey instructions of the United States Department of Interior, Bureau of Land Management.

sea)	COUNTY SURVEYOR FILING DATA
	Date of computer entry
Ond Stanes	Date microfilmed
March 27, 1998	Number of included sheets
	CORNER CODE AFFIX YOUR LAND SURVEYOR SEAL

