


U.S. PUBLIC LAND SURVEY MONUMENT RECORD

For Public Land Survey Corners in the
T. 2 N., R. 12 E.

CORNER CODE INDEX

	1	2	3	4	5	6	7	8	9	10	11	12	13	14	15	16	17	18	19	20	21	22	23	24	25
A																									
B																									
C	6																								
D		5																							
E			4																						
F				3																					
G					2																				
H						1																			
I																									
J	7																								
K		8																							
L			9																						
M				10																					
N					11																				
O						12																			
P							13																		
Q								14																	
R									15																
S										16															
T											17														
U												18													
V													19												
W														20											
X															21										
Y																22									
Z																	23								
																		24							
																			25						
																				26					
																					27				
																						28			
																							29		
																								30	
																									31
																									32
																									33
																									34
																									35
																									36

EXAMPLE

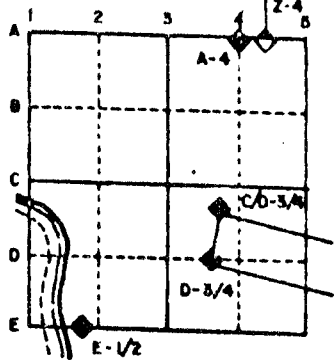

ROCK TWP
ROCK COUNTY WI

IF AVAILABLE
STATE PLANE COORDINATES


NAD 27 North (Y) 246,256.24 Elev. (Z) _____
East (X) 2,249,826.62 Zone _____

Hor. Datum SCHNEEBERGER Vert. Datum _____
246,255.04 JANESVILLE TWP
2,249,826.67 246,256.33
2,249,826.70

PLACE MONUMENT SYMBOL (◆) AT PROPER LOCATION ON ABOVE INDEX

◆ CORNER MONUMENT ○ WITNESS MONUMENT

BEARINGS ARE BASED ON: ASSUMED

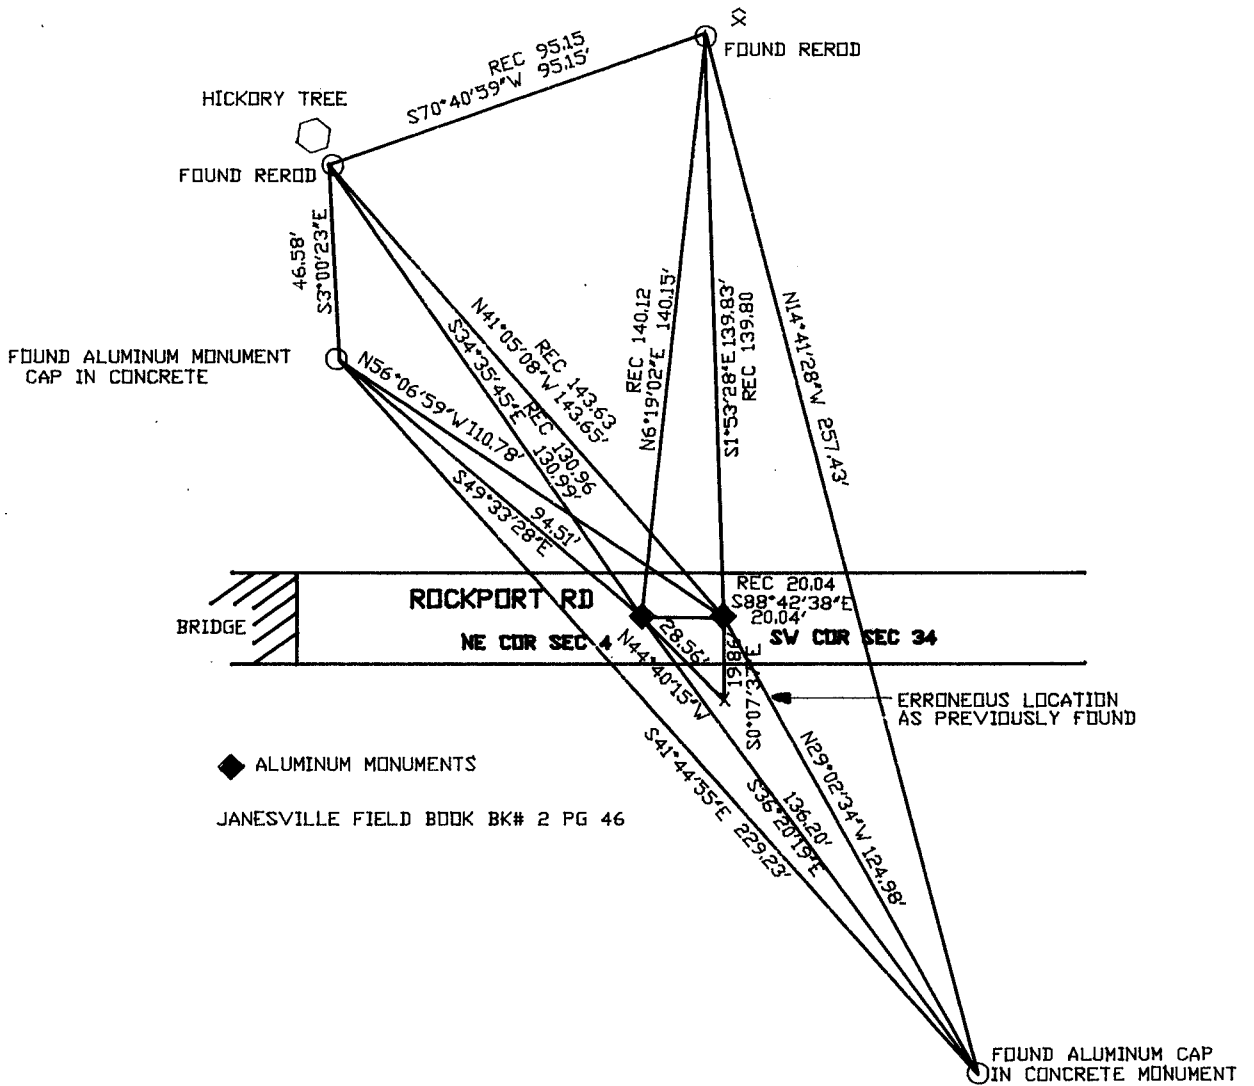

(B) Describe any record evidence, monument evidence, occupational evidence, testimonial evidence or any other material evidence you considered, and whether the monument was found or placed.



- 1834 HARRISON ORIGINAL GOVERNMENT SURVEYOR. FIELD NOTES - INTERSECTED NORTH BOUNDARY 36.96 WEST OF POST.
 BURR OAK 20 S55E 164
 BURR OAK 12 S57W 191
 MEASURED 2698.08 TO W 1/4 CORNER OF SECTION 3.
- 1860 RUGER VOL 1 PG 126 SHOWS CORNER AS 19.8' WEST OF SE CORNER OF SECTION 33 JANESVILLE TOWNSHIP. SHOWS A DISTANCE OF 2626.8' TO THE N 1/4 CORNER OF SECTION 4.
- 1866 LOCKE VOL 1 PG 267 SHOWS THE CORNER AS 19.8' WEST OF THE SE CORNER OF SECTION 33 JANESVILLE TOWNSHIP CORNER. SHOWS A DISTANCE OF 2661.12' TO THE N 1/4 CORNER OF SECTION 3.
- 1981 BARNES VOL 6 PG 186 SHOWS THE FOLLOWING DISTANCES:
 TO N 1/4 COR SEC 3 BARNES N89-29-33E 2663.10
 RUGER 2661.45
 WPL N89-03-14E 2663.18
 W 1/4 COR SEC 3 BARNES S0-15-18E 2739.83
 WPL S0-15-01E 2719.34
- NW 1/4 OF NW 1/4 LOCKE 1865 1378.08
 RUGER 1383.23
- BARNES COORDINATES N/S 246,236.33; E/W 2,249,826.70
 WPL COORDINATES N/S 246,234.56; E/W 2,249,826.98
- 1981 BARNES VOL 6 PG 189
 DUG 1' DEEP & FOUND PIECES OF STAKE SURROUNDED BY 5 LIMESTONES. SET ALUMINUM MONUMENT. COORDINATES OF N/S 246,255.04; E/W 2,249,826.67. SHOWS A DISTANCE OF 20.03' TO SE CORNER OF SECTION 33 JANESVILLE TOWNSHIP. SHOWS TIES TO CORNER THAT WAS PLACED BY D. KNOERR.
- 1981 BARNES JANESVILLE REMONUMENTATION PROJECT. PLACED ALUMINUM MONUMENT FROM TIES.
 FOUND ALUMINUM MONUMENT.

C) Was the corner restored through acceptance of (1) an obliterated evidence location, or, (2) a found perpetuated location?

ACCEPTED FOUND ALUMINUM MONUMENT.

(E) Was the corner reestablished through lost corner proportionate methods? If so, show the method, including the directions and distances to other public land survey corners used as evidence or used for proportioning the corner location.

I, Donald Barnes, hereby certify that the corner points as identified by the corner code index were, in a field survey on, July 18, 1990, established, re-established, monumented, re-monumented, recovered or restored as expressed below and in conformance with the regulations and rules as required in the current manual of survey instructions of the United States Department of Interior, Bureau of Land Management.

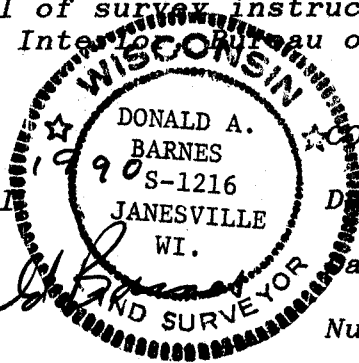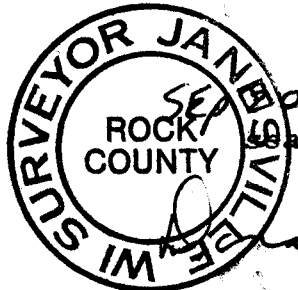

COUNTY SURVEYOR FILING DATA

Date of computer entry _____

Date microfilmed _____

Number of included sheets _____

CORNER CODE

AFFIX YOUR LAND SURVEYOR SEAL

A13 (1)