U.S.


PUBLIC LAND SURVEY MONUMENT RECORD

For Public Land Survey Corners in:

WI ADMINISTRATIVE CODE A-E 7.08 REQUIREMENT

T. 2 N., R. 12 E

CORNER CODE INDEX

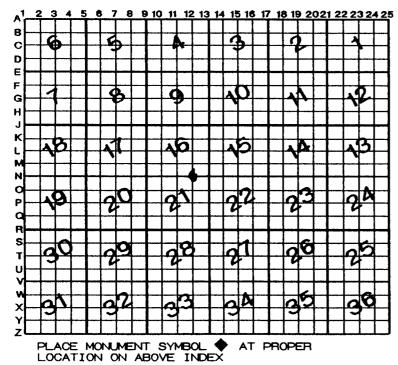

Roc	K	TWP
ROCK	COUNTY	WI

IF AVAILABLE ROCK COUNTY COORDINATES PERFERRED

North	Elev
East	·····
Hor. Datum	Vert. Datum
LATITUDE	ELLIPS. H
LONGITUTE	
GPS (X)	TRAVERSE (X)
BASED ON THE	FOLLOWING CONTROL:

♦CORNER MONUMENT

O WITNESS MONUMENT

BEARINGS ARE BASED ON:

(a)

	/ -	,
FIELD BOOKPAGE #	SHEET OF Z	
SHOW A PLAN VIEW DRAWING DEPICTING THE CORNER MONUMENT AND	SURROUNDING	
PHYSICAL FEATURES, INCLUDING THE EXCAVATION AREA AND DEPTH.		
PLANNING & ZONING COMMITTEE ADOPTED THE ABOVE FORM ON 12/2/1982		

(B) Describe any record evidence, monument evidence, occupational evidence, testimonial evidence or any other material evidence you considered, and whether the monument was found or placed.

1834 HARRISON ORIGINAL GOVERNMENT SURVEYOR. FIELD NOTES. CORNER TO SECTIONS 15,16,21,22. BUR OAK 18 N54 E 150, BURR OAK 12 S75E 200, BURR OAK 10 S15W 3.05, AND BURR OAK 10 N74W 2.80

- 1853 McVEAN VOL 1 PG 16. SHOWS 2616.90 TO E 1/4 CORNER OF SECTION 16.
- 1958 BATTERMAN JR. VOL 3 PG 561. STATES NOTHING ABOUT CORNER BUT REFERENCED CORNER.
- 1978 BARNES VOL 5 PG 455 DUG AND FOUND OLD ASPHALT ROAD AND R/R SPIKE 5' DEEP. PLACED ALUMINUM MONUMENT.
- 19?? HURD VOL 5 PG 517 N/S 230,297.85; E/W 2,250,197.35 1990 BARNES N-13

FOUND ALUM. MON. MONUMENT WAS VERY CORRODED. MONUMENT WILL BE DISTURBED BY ROAD CONSTRUCTION.

- C) Was the corner restored through acceptance of (1) an obliterated evidence location, or, (2) a found perpetuated location?
 ACCEPTED FOUND PERPETUATED LOCATION
- D) Describe any material discrepancy between the location of the corner as restored or reestablished and the location of that corner as previously restored or reestablished by distance and direction. Show the discrepancy on the plan view drawing under (a), above. Show the distances between the corner as previously restored or reestablished and (1) the corner as restored or reestablished, and (2) to at least 4 of the witness monuments shown on the drawing in (a), above.
- (E) Was the corner reestablished through lost corner proportionate methods? If so, show the method, including the directions and distances to other public land survey corners used as evidence or used for proportioning the corner location.

I, Donald Barnes, hereby certify that the corner points as identified by the corner code index were, in a field survey on, MARCH 1998, established, re-established, monumented, remonumented, recovered or restored as expressed below and in conformance with the regulations and rules as required in the current manual of survey instructions of the United States Department of Interior, Bureau of Land Management.

	COUNTY SURVEYOR FILING DATA
O seal	Date of computer entry
Donald Barres	Date microfilmed
March 27,1998	Number of included sheets
maken - 1/11/10	AFFIX YOUR LAND SURVEYOR SEAL

