Paper weight-110# (minimum)

Black nonfading ink required

U.S. PUBLIC LAND SURVEY MONUMENT RECORD


For Public Land Survey Corners In:

WI ADMINISTRATIVE CODE A-E 7.08 REQUIREMENT

REV 10/23/2004 USMONREC.DWG

T. $\frac{4}{N}$ N. R. $\frac{10}{E}$ 4th P.M.

CORNER CODE INDEX

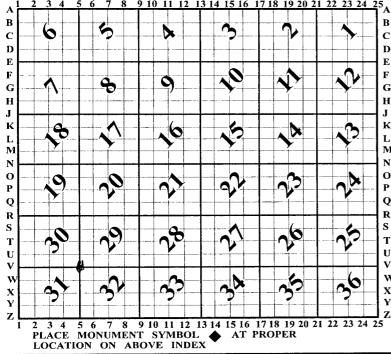

UNION TWP

IF AVAILABLE ROCK COUNTY COORDINATES PERFERRED

North	Elev.
East	
Hor. Datum	Vert. Datum
LATITUDE _	ELLIPS. HT
LONGITUDE	
NAD83(91)	NETWORK ADJ. YR 2010
GPS (X)	TRAVERSE (X) X
BASED ON TH	E FOLLOWING CONTROL:

♦ CORNER MONUMENT

WITNESS MONUMENT

BEARINGS ARE BASED ON: ______ BOCK COUNTY PROJECTION BOCK COUNTY PRO

FIELD BOOK ____ PAGE # ____ OF ____ OF OBSERVATION SHEET ____ OF ____ OF SHOW A PLAN VIEW DRAWING DEPICTING THE CORNER MONUMENT AND SURROUNDING PHYSICAL FEATURES, INCLUDING THE EXCAVATION AREA AND DEPTH.

PLANNING & ZONING COMMITTEE ADOPTED THIS FORM ON 12/2/1982

CORNER CODE _

V-05(1)

UN603 NECORSEC31

(B) Describe any record evidence, monument evidence, occupational evidence, testimonial evidence or any other material evidence you considered, and whether the monument was found or placed.

- 1833 HARRISON T4N T1 DE 4TH MER NORTH BET SECS 31 & 32
 - 1980.00 LEAVE TIMBER & ENTER PRIAIRE
 - 2640.00 QUARTER SEC COR. {SET POST & RAISED A MOUND OF EARTH & SODS
 - 5280.00 COR TO SECS 29,30,31,32 SET A POST & RAISED A MOUND OF EARTH & SODS LAND 1ST 1/2 ROLLING 2ND RATE TIMBER W.O. & BURR O.
 - GROWTH GRUBS, GRASS, & WEEDS LAST

1/2 ROLLING 1ST RATE PRAIRIE WITH GROWTH OF GRASS & WEEDS

- 1833 HARRISON TAN RIDE 4TH MER EAST BET. SECS 29 & 32
 1980.0 LEAVE PRAIRIE & ENTER TIMBER
 - 2640.00 TEMPY 1/4 SEC COR
 - 5243.70 INT. E BDY 9.9'S OF P LAND 1ST 1/2 MILE ROLLING 1ST RATE PRAIRIE 2ND 1/4 LEVEL 2ND RATE WITH TIMBER OF BURR O. & GROWTH OF SCRUBS GRASS & WEEDS

WEST COR WEST BET SECS 29 & 32

- 2621.85 QUARTER SEC COR {WO 12 N23E 50.82'; BURR O 14 N64W 122.76' WO 12 & BURR}MARKED
- 5243.70 INT SEC COR.
- 1833 HARRISON TAN TIDE 4TH MER WEST BETWEEN 30 & 31
 2640.00 QUARTER SEC COR. SET A POST & RAISED
 MOUND
 - 5665.44 INT. RANGE LINE 9E 995.28' N OF COR OF RANGE 9 & 10 TOWN 3 & 4 SET POST & RAISED MOUND LAND ROLLING 1ST RATE PRAIRIE GROWTH GRASS & WEEDS.
- 1833 HARRISON T4N T10E 4TH MER NORTH BET SECS 29 & 30
 2640.00 QUARTER SEC COR SET POST & RAISED MOUND
 5280.00 SET COR TO SECS 19,20,29,30 POST & RAISED
 MOUND LAND ROLLING 1ST RATE PRAIRIE
- 1860 RUGER VOL1-148 SET HH 15X8X5 VAR 8-20 2643.96 TO E 1/4 COR SEC 30, VAR 8-06 2664.42 TO S 1/4 COR SEC 30, & VAR 8-06 5718.24 TO SW COR SEC 30
- 1870 RUGER AUG REMON-79 SOUTH ON WEST LINE OF NW 1/4 SEC 32 ON A VAR 7-15 AT
 - 2644.62 INTERSECTED QUARTER LINE 2.64' EAST OF QUARTER CORNER. FOUND STAKE SURROUNDED BY 4 LIMESTONES. COR VAR 7-11

SOUTH ON WEST LINE OF SW 1/4 SEC 32 ON A VAR 6-16' OFFSET WEST 5.44' OFFSET WEST 5.94' OFFSET EAST 9.57' AT

- 2644.62 INTERSECTED SOUTH BOUNDARY LINE 11.88 WEST OF CORNER. FOUND STUMPS OF BOTH BEARING TREES AND ESTABLISHED CORNER FROM THEM. COR VAR 6-29
- 1870 RUGER AUG REMON-78 WEST ON NORTH LINE OF NE 1/4 SEC 32 ON A VAR 6-40' OFFSET NORTH 16.5' AT
 - 2621.85 INTERSECTED QUARTER LINE 31.68 NORTH OF QUARTER CORNER. FOUND REMAINS OF OLD STAKE AT CORNER. ALSO FOUND REMAINS OF BOTH STUMPS OF BEARING TREES. COR VAR 7-00

WEST ON NORTH LINE OF NW 1/4 SEC 32 ON A VAR 7-05 OFFSET NORTH 8.74' OFFSET SOUTH 37.95'AT

2625.15 INTERSECTED WEST BOUNDARY LINE 11.72'
NORTH OF CORNER. FOUND HARD HEAD STONE
AT CORNER SET BY SELF IN A PREVIOUS
SURVEY. COR VAR 7-58

SHEET 1 OF 2 CORNER CODER V-05(1)

0 ct = 0, 2011

UN603 NECORSEC31

1870 RUGER AUG REMON-84 EAST ON SOUTH LINE OF SW 1/4
SEC 30 ON A VAR 7-15; AT

3054.48 INTERSECTED QUARTER LINE AT QUARTER CORNER. FOUND HARD HEAD STONE SET BY SELF AT CORNER.

EAST ON SOUTH LINE OF SE 1/4 SEC 30 ON A VAR 7-15 AT

2628.45 INTERSECTED EAST BOUNDARY LINE AT CORNER 1870 RUGER AUG REMON-85 NORTH ON EAST LINE OF SE 1/4 SEC 30 ON A VAR 7-23; AT

2641.67 INTERSECTED QUARTER LINE AT QUARTER CORNER. FOUND HARD HEAD STONE AT CORNER SET BY SELF IN PREVIOUS SURVEY.

NORTH ON EAST LINE OF NE 1/4 SEC 30 ON A VAR 7-23; AT

2648.58 INTERSECTED NORTH BOUNDARY LINE AT CORNER. FOUND LIMESTONE AT CORNER SET BY SELF IN PREVIOUS SURVEY.

- 1890 BLEEDORN VOL 2-440 FD MONUMENT. 2635.38 TO N 1/4 COR SEC 31 & 2649.90 TO E 1/4 COR SEC 31
- 1974 BATTERMAN JR. VOL 4 PG 265 FD CUT STONE & REFERENCED SAME.
- 1981 GRENLIE CSM VOL 10 PG 226 ALUM. 2647.14 TO FD PK @ W 1/4 COR SEC 29
- 1994 BARNES V-05 FD ALUM. MON. & REFERENCED SAME. 3.5'
 WEST OF N/S PVMT CENTER. ON LINE WITH E/W FENCE ON
 WEST SIDE OF ROAD. FB#2 PG 53

FD ALUM MON 2.8 WEST OF CENTER OF PVMT & ON LINE WITH E/W FENCE LINE TO THE WEST. FD REFERENCE TIES.

C) Was the corner restored through acceptance of (1) an obliterated evidence location, or, (2) a found perpetuated location?

. ACCEPTED FD ALUM. MON.

D) Describe any material discrepancy between the location of the corner as restored or reestablished and the location of that corner as previously restored or reestablished by distance and direction. Show the discrepancy on the plan view drawing under (a), above. Show the distances between the corner as previously restored or reestablished and (1) the corner as restored or reestablished, and (2) to at least 4 of the witness monuments shown on the drawing in (a), above.

NONE

- (E) Was the corner reestablished through lost corner proportionate methods? If so, show the method, including the directions and distances to other public land survey corners used as evidence or used for proportioning the corner location.
- I, **Donald Barnes**, hereby certify that the corner location as identified by the corner code index was determined by me under my direction and control and that this U.S. Public Land Survey Monument Record is correct and complete to the best of my knowledge and belief.

SHEET 2 OF 2

CORNER CODE V-05(1)

Davies Dit 20,2011

A.E. 7.08 REQUIREMENT