Paper weight-110# (minimum) Black nonfading ink required LAND SUI U.S. SURVEY PUBLIC MONUMENT RECORD


For Public Land Survey Corners In:

WI ADMINISTRATIVE CODE A-E 7.08 REQUIREMENT

REV 10/23/2004 USMONREC.DWG

T. 4 N. R. 10 E. 4th P.M.

CORNER CODE INDEX

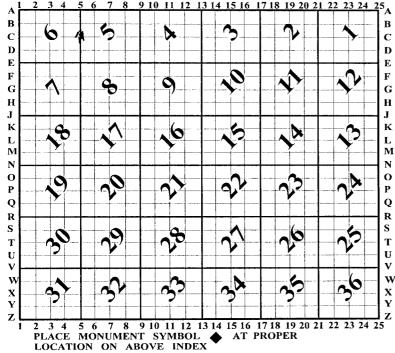

UNION TWP **ROCK COUNTY WI**

IF AVAILABLE ROCK COUNTY COORDINATES PERFERRED

Elev. North Hor. Datum _____ Vert. Datum **LATITUDE** ELLIPS. HT. LONGITUDE NAD83(91) _____NETWORK ADJ. YR 2010 GPS (X) ____ TRAVERSE (X) XBASED ON THE FOLLOWING CONTROL:

◆ CORNER MONUMENT

WITNESS MONUMENT \bigcirc

(a) ROCK COUNTY PROJECTION BEARINGS ARE BASED ON:

FIELD BOOK PAGE #		/	7
OR OBSERVATION SHEET	SHEET _		<u> </u>
SHOW A PLAN VIEW DRAWING DEPICTING THE CORNER MONUMENT AND	SURROUNDI	NG	
PHYSICAL FEATURES, INCLUDING THE EXCAVATION AREA AND DEPTH.			
PLANNING & ZONING COMMITTEE ADOPTED THIS FORM ON 12/2/1982		_	_ / %

UN515 W1/4CORSEC5

(B) Describe any record evidence, monument evidence, occupational evidence, testimonial evidence or any other material evidence you considered, and whether the monument was found or placed.

- 1833 HARRISON (NOV 10TH) T4N T10E 4TH MER NORTH BET SECS 5 & 6
 - 1582.02 BURR 0 12
 - 2640.00 QUARTER SEC. CO {BURR O 10 S74W 9.24';
 BURR O 12 N53E 23.76' BURR O 10 & BURR O
 12}MARKED
 - 5205.42 INT. N. BDY 184.80 W OF P BURR O 12 S68W 39.60'; BURR O 14 S40E 59.40' LAND SAME AS BEFORE
- 1856 CHURCH VOL 1 PG 61 STATES NOTHING ABOUT MON. VAR 7-30 2755.50? TO CENTER OF SEC 5 & VAR 7-30 5481.96 TO E 1/4 COR SEC 5.
- 1856 CHURCH VOL 1 PG 83 STATES NOTHING ABOUT MON. 2640.00 TO CENTER OF SEC 6 & 5392.20 TO W 1/4 COR SEC 6.
- 1870 RUGER AUG REMON-119 SOUTH ON WEST LINE OF NW
 1/4 SEC 5 ON A VAR 6-45; OFFSET EAST
 11.22' AT
 - 2544.46 INTERSECTED QUARTER LINE 20.13' EAST OF QUARTER CORNER. FOUND EAST BEARING TREE AND REMAINS OF STUMP OF WEST BEARING TREE. ESTABLISHED CORNER FROM THEM. COR VAR 6-34'

SOUTH ON WEST LINE OF SW 1/4 SEC 5 ON A VAR 6-30; OFFSET WEST 8.58' AT

- 2665.74 INTERSECTED SOUTH BOUNDARY LINE 27.72 WEST OF CORNER. FOUND OLD STAKE AT CORNER. COR VAR 6-55
- 1976 BARNES VOL5 PG 137 DUG 2.0' DEEP FD CUT STONE 8
 1/2X6X18. SET 24" BERNSTSEN W-1-B MON. & REF SAME.
 CORNER ON EAST PVMT EDGE OF CROCKER RD & SOUTH
 SIDE OF HOLT RD.
- 1978 BARNES VOL 5 PG 407 REPLACED BROKE ALUM. MON. WITH 10" ALUM MON.
- 1978 SCHNEEBERGER CSM VOL 8 PG 23 ALUM. MON. 2672.46
 TO ALUM @ SW COR SEC 5
- 1996 COMBS CSM VOL 19 PG 470 & 473 ALUM MON 2672.55 TO SE COR SEC 6
- 2001 COMBS CSM VOL 24 PG 377 ALUM MON 2672.55 TO FD ALUM @ SE COR SEC 6
- 2002 LATHROP CSM VOL 25 PG 355 ALUM 2672.21 TO ALUM @ SE COR SEC 6.
- 2008 COMBS BK32 PG 846 "DREAMVIEW LE RISCH ESTATES" ALUM. MON. 2672.53 TO ALUM @ SE COR SEC 6
- 2009 COMBS CSM VOL 33 PG 163 ALUM MON.
- 2011 DALSING CSM PRELIM FD ALUM. MON NO1-49-29E 2551.59
 TO CUT STONE @ NW COR SEC 5, N88-55-14E 2711.23 TO
 CENTER OF SEC 5; N88-55-14E 5523.93 TO CUT STONE @ E
 1/4 COR SEC 5.
- 2011 COMBS CSM ? PG ? FD ALUM. MON. 2551.59 TO CUT STONE @ NE COR SEC 6

FD ALUM. D.2' DEEP; 1.6' NORTH OF SOUTH PVMT EDGE PROJECTED FROM EAST; 5.7 EAST OF N/S POLE LINES PROJECTED FROM SOUTH; ON LINE WITH N/S FENCE TO THE NORTH. I ALSO FOUND THE SOUTHEASTERLY AND NORTH EAST REFERENCE PIPES.

SHEET 1 OF 3

Insld facros OCT 20, 2011

CORNER CODE C-5

UN515 W1/4CORSEC5

C) Was the corner restored through acceptance of (1) an obliterated evidence location, or, (2) a found perpetuated location?

ACCEPTED FD ALUM. MON.

D) Describe any material discrepancy between the location of the corner as restored or reestablished and the location of that corner as previously restored or reestablished by distance and direction. Show the discrepancy on the plan view drawing under (a), above. Show the distances between the corner as previously restored or reestablished and (1) the corner as restored or reestablished, and (2) to at least 4 of the witness monuments shown on the drawing in (a), above.

NONE

(E) Was the corner reestablished through lost corner proportionate methods? If so, show the method, including the directions and distances to other public land survey corners used as evidence or used for proportioning the corner location.

NO

I, **Donald Barnes**, hereby certify that the corner location as identified by the corner code index was determined by me under my direction and control and that this U.S. Public Land Survey Monument Record is correct and complete to the best of my knowledge and belief.

Duld Edenos Oct 20,2011

SHEET 2 OF 3

GORNER GODE C-5

A.E. 7.08 REQUIREMENT

