Paper weight-110# (minimum)

Black nonfading ink required

U.S. PUBLIC LAND SURVEY MONUMENT RECORD


For Public Land Survey Corners In:

WI ADMINISTRATIVE CODE A-E 7.08 REQUIREMENT

REV 10/23/2004 USMONREC.DWG

T. $\frac{4}{N}$ N. R. $\frac{10}{E}$ 4th P.M.

CORNER CODE INDEX

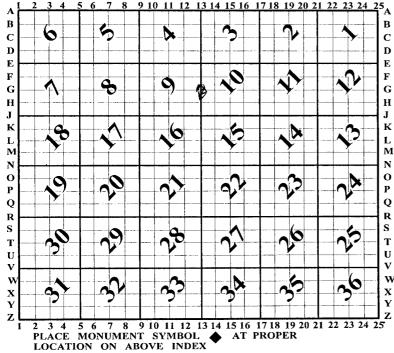

UNION TWP

IF AVAILABLE ROCK COUNTY COORDINATES PERFERRED

North _	Elev
East _	
Hor. Date	ım Vert. Datum
LATITUE	DE ELLIPS. HT
LONGITU	JDE
NAD83(91)NETWORK ADJ. YR 2010
GPS (X)	TRAVERSE (X) X
BASED (ON THE FOLLOWING CONTROL:

♦ CORNER MONUMENT

WITNESS MONUMENT

BEARINGS ARE BASED ON: ______ ®

FIELD BOOK PAGE #	/	2	
	CET OF		
SHOW A PLAN VIEW DRAWING DEPICTING THE CORNER MONUMENT AND SURROUNDING			
PHYSICAL FEATURES, INCLUDING THE EXCAVATION AREA AND DEPTH.			
PLANNING & ZONING COMMITTEE ADOPTED THIS FORM ON 12/2/1982	1	1 -	

- (B) Describe any record evidence, monument evidence, occupational evidence, testimonial evidence or any other material evidence you considered, and whether the monument was found or placed.
- 1833 HARRISON (NOV 8) NORTH BETWEEN SECS 9 & 10

1782.00 LEAVE MARSH

- 2640.00 QUARTER SEC COR. {BURR 0 12 S72W 52.80'; BURR 0 12 N81W 52.14' BURR 0 12 & BURR 0 12}MARKED
- 5280.00 COR TO SEC 3,4,9,10 {BURR O 18 N47E 7.92'; BURR O 18 S41W 66.66'; BURR O 12 N25W 60.06'; BURR O 12 S27E 73.92' LAND LEVEL 2ND RATE TIMBER BURR & RED O UNDERGROWTH GRUBS, GRASS & WEEDS
- 1859 RUGER VOL 1 PG 116 & #5108 POPLAR 6 N42-08?; BURR
 OAK 13 S54-30E ?? {SEE BELOIT REC} VAR 8-05
 SURROUNDED POST BY 4 HH. VAR 8-30 2655.84 TO SE COR
 SEC 9. USED TO SUBDIVIDE SEC 9 VAR 8-23 2673.66 FROM
 W 1/4 COR TO CENTER OF SEC 9
- 1870 RUGER AUG REMON-111 NORTH ON WEST LINE OF SW
 1/4 SEC 10 ON A VAR 7-00'; OFFSET EAST 5.28'
 OFFSET EAST 88.11' AT
 - 2657.82 INTERSECTED QUARTER LINE 116.82' EAST OF QUARTER CORNER. FOUND STAKE SURROUNDED BY 4 HARD HEAD STONES SET BY SELF AT CORNER IN A PREVIOUS SURVEY. COR VAR 7-30 REMON-113 SOUTH OF WEST LINE OF NW 1/4 SEC 10 ON A VAR 7-10'; OFFSET WEST 8.58' OFFSET EAST 6.6' AT

2653.86 INTERSECTED QUARTER LINE 11.55' WEST OF QUARTER CORNER. COR VAR 7-22

- 1942 SUNNY #5115 CORNER STONE SET IP N86-14E 1780.9 TO IP IN CENTERLINE OF USH 14 & E/W RD.
- 1957 BATTERMAN VOL 3 PG 516. DUG 5X5X2 DEEP FOUND 6X6X36 MON SURROUNDED BY 4 HH. SET 2" PIPE 2' SOUTH OF CENTER OF RD. BELOIT SET HAS PENCILED IN 45.28 (REC 45.36) FOR THE DISTANCE TO THE NW REFERENCE PIPE, 42.29 [REC 42.42] TO THE NE REFERENCE PIPE, & 43.31 [REC 43.24] TO THE SW REFERENCE PIPE.
- 1959 BATTERMAN VOL 4 PG 26 DUG HOLE 12X6X3 & FD NOTHING. RE-SET ACCORDING TO RE-SURVEY BY EDWARD RUGER IN 1871. REFERENECED SAME. ON LINE WITH N/S FENCE LINES. [FD CUT STONE MON REFERENCE 12-10-63] NOTE ON BOTTOM OF PAGE "SEE VOL 3 PAGE 516" IS NOT IN THE JANESVILLE SET.
- 1962 SHIMELL #5126 PIPE @ W 1/4 COR SEC 10. EAST 5245.20 TO STONE MON @ E 1/4 COR SEC 10
- 1963 BATTERMAN VOL 4 PG 26 FD CUT STONE MON REFERENCE 12-10-63. REFERENCED SAME. BELOIT SET IS DIFFERENT. THAT SET CALLS FOR FD CUT STONE FOR THE REFERENCE TIES THAT SHOWS THE ROAD. THE LOWER REFERENCE TIE IS FOR THE ERRONEOUS PIPE.
- 1964 LEE #5109 DUG & FD 6X6 CUT STONE MON. WEST 659.03 TO POB.
- 1970 COMBS #5118 FD REFERENCE PIPES. SET 1" PIPE. S89-15-55E TO CUT STONE @ E 1/4 COR SEC 10 & NORTH TO CUT STONE @ NW COR SEC 10. SET 1' PIPE NORTH 33.00 ON SEC LINE TO NW COR SEC 10
- 1971 THOM CSM VOL 2 PG 14 FD MON USED FOR LINE FD MON @ E 1/4 COR SEC 10.
- 1971 COMBS CSM VOL 2 PG 178 FD MON USED FOR LINE FD MON @ E 1/4 COR SEC 10.
- 1972 COMBS #5121 FD 1" PIPE S89-15-55E 1960.18 TO POB. SHEET 1 OF 3

Contable Baines
Oct 24, 2011

CORNER CODE G-13

UN537W1/4CORSEC1O

- 1972 COMBS CSM VOL 2 PG 240 FD 1" PIPE S89-15-55E 2684.63
 TO PIPE
- 1974 GRENLIE CSM VOL 4 PG 148 FD CUT STONE @ E 1/4 COR SEC 9 & W 1/4 COR SEC 9
- 1974 GRENLIE CSM VOL 4 PG 195 FD CUT STONE @ E 1/4 COR SEC 9 & W 1/4 COR SEC 9
- 1974 GRENLIE CSM VOL 4 PG 194 FD CUT STONE @ E 1/4 COR SEC 9 & W 1/4 COR SEC 9
- 1975 GRENLIE CSM VOL 4 PG 360 FD STONE
- 1978 SCHROEDER CSM VOL 8 PG 3 STATES NOTHING ABOUT MONUMENTS.
- 1979 WIDOT PROJ 5155-00-21 SHEET 4.2 #11781 1" PIPE 301,168.36; 2,185,425.96 ??? N74-40-51E 8.44 TO 1" PIPE
- 1981 GREENLIE CSM VOL 10 PG 318 FD CUT STONE. USED W1/4 COR SEC 9 FOR LINE
- 1981 GRENLIE CSM VOL 10 PG 454 FD CUT STONE. USED W1/4 COR SEC 9 FOR LINE
- 1985 SCHROEDER CSM VOL 12 PG 153 FD ALUM. USED FD ALUM @ CENTER OF SEC 9 FOR LINE.
- 1987 SCHROEDER CSM VOL 13 PG 126 FD ALUM.
- 1992 COMBS CSM VOL 15 PG 451 FD 1" PIPE 2663.88 TO FD CUT STONE @ NW COR SEC 10.
- 1993 GRENLIE CSM VOL 17 PG 125 FD CUT STONE. 2665.66 TO NE COR SEC 9. STATES NOTHING ABOUT NE COR SEC 9
- 1996 SCHROEDER CSM VOL 19 PG 37 STATES NOTHING ABOUT MON.
- 2007 LATHROP CSM VOL 32 PG 25 FD PIPE 2663.92 TO DISTURBED STONE MON/SET PIN @ NW COR SEC 10
- 2008 LATHROP #15968 & #15967 FD PIPE, NORTH 2663.92 TO FD PIN @ NW COR SEC 10

TIM MOORE CALL FOR METAL SOUND & 320,724.51; 416,484.75. HE FOUND NE & SE REFERENCE PIPES. FROM METAL SOUND TO NE REFERENCE PIPE HE MEASURED 31.80 [REC 31.85]. FROM METAL SOUND TO SE REFERENCE PIPE HE MEASURED 28.30 [REC 28.35]. THE BELOIT SET SHOWS THE SE REFERENCE PIPE AS BEING FARTHER EAST.

FD PIPE 0.3' DEEP

C) Was the corner restored through acceptance of (1) an obliterated evidence location, or, (2) a found perpetuated location?

FD PIPE IS IN HARMONY WITH BATTERMAN'S 1963 TIES TO THE FD CUT LIMESTONE.

D) Describe any material discrepancy between the location of the corner as restored or reestablished and the location of that corner as previously restored or reestablished by distance and direction. Show the discrepancy on the plan view drawing under (a), above. Show the distances between the corner as previously restored or reestablished and (1) the corner as restored or reestablished, and (2) to at least 4 of the witness monuments shown on the drawing in (a), above.

AS SHOWN

- (E) Was the corner reestablished through lost corner proportionate methods? If so, show the method, including the directions and distances to other public land survey corners used as evidence or used for proportioning the corner location. $N \square$
- I, **Donald Barnes**, hereby certify that the corner location as identified by the corner code index was determined by me under my direction and control and that this U.S. Public Land Survey Monument Record is correct and complete to the best of my knowledge and belief.

SHEET 2 OF 3

Dorald Barres Oct 24,2011

CORNER CODE G-13

A.E. 7.08 REQUIREMENT

