Paper weight-110# (minimum)

Black nonfading ink required

U.S. PUBLIC LAND SURVEY MONUMENT RECORD


For Public Land Survey Corners In:

WI ADMINISTRATIVE CODE A-E 7.08 REQUIREMENT

REV 10/23/2004 USMONREC.DWG

T. $\frac{4}{N}$ N. R. $\frac{10}{E}$ E. 4th P.M.

CORNER CODE INDEX

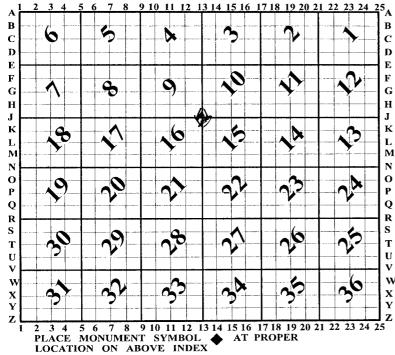

UNION TWI

IF AVAILABLE ROCK COUNTY COORDINATES PERFERRED

North	Elev.
East	
Hor. Datum	Vert. Datum
LATITUDE	ELLIPS. HT
LONGITUDE _	
NAD83(91)	NETWORK ADJ. YR 2010
GPS (X)	TRAVERSE (X) X
BASED ON THE	FOLLOWING CONTROL:

◆ CORNER MONUMENT

WITNESS MONUMENT

FIELD BOOK PAGE #		OF	4
OR OBSERVATION SHEET			
SHOW A PLAN VIEW DRAWING DEPICTING THE CORNER MONUMENT AND S	URROUN	DING	
PHYSICAL FEATURES, INCLUDING THE EXCAVATION AREA AND DEPTH.			
PLANNING & ZONING COMMITTEE ADOPTED THIS FORM ON 12/2/1982			2

UN547 NECORSEC16

(B) Describe any record evidence, monument evidence, occupational evidence, testimonial evidence or any other material evidence you considered, and whether the monument was found or placed.

1833 HARRISON NORTH BETWEEN SECS 15 & 16

1633.50 BURR 0 14

2640.00 QUARTER SEC COR {BURR 0 12 S24W 30.36'; BURR 0 12 N35E 56.76 BURR 0 12 & BURR 0 12}MARKED

5082.00 ROAD E & W

5280.00 COR TO SECS 9,10,15,16 IN THE SOUTHERN EDGE OF MARSH {BURR 0 12 N52W 308.22'; BURR 0 12 N78E 472.56'; BURR 0 12 S35E 199.98'; BURR 0 12 S63W 214.50' LAND ROLLING 2ND RATE TIMBER GENERLY BURR, UNDERGROWTH GRUB, GRASS & WEEDS

1833 HARRISON EAST ON RAND. BET SECS 10 & 15

2640.00 TEMPY 1/4 SEC COR

5215.98 INT E BDY 15.84' N OF P
LAND ROLLING 2ND RATE TIMBER MOSTLY BURR
O & W.O. ??? GRUBS GRASS & WEEDS

WEST COR WEST BET SECS 16 & 15

2607.99 QUARTER SEC COR {BURR 0 S39E 26.4'; BURR 0 12 & BURR 0 12 MARKED

5215.98 SEC COR NOV 8 TH 1833

1833 HARRISON EAST ON RAND. BET SECS 9 & 16

2640.00 TEMPY 1/4 SEC COR.

4884.00 ROAD N.W.

5299.80 INT E BDY 26.4 S OF P LAND SAME WEST COR WEST

2649.90 QUARTER SEC COR. {BURR 0 12 S46E 15.18'; BURR 0 12 N78E 17.82' BURR 0 12 & BURR 0 12}MARKED

5299.80 SEC COR.

1833 HARRISON (NOV 8) NORTH BETWEEN SECS 9 & 10

1782.00 LEAVE MARSH

2640.00 QUARTER SEC COR. {BURR 0 12 S72W 52.80'; BURR 0 12 N81W 52.14' BURR 0 12 & BURR 0 12}MARKED

5280.00 COR TO SEC 3,4,9,10 {BURR 0 18 N47E 7.92';
BURR 0 18 S41W 66.66'; BURR 0 12 N25W
60.06'; BURR 0 12 S27E 73.92' LAND LEVEL
2ND RATE TIMBER BURR & RED 0
UNDERGROWTH GRUBS, GRASS & WEEDS

1856 CHURCH VOL 1 PG 60 STATES NOTHING ABOUT MON. 2663.10 TO N 1/4 COR SEC 16

1859 RUGER VOL 1 PG116 # 5108 SURROUNDED POST BY 4 HH VAR 8-3 2655.84 TO E 1/4 COR SEC 9

1870 RUGER AUG REMON-93 SOUTH ON EAST LINE OF NE 1/4
SEC 16 ON A VAR 6-20; OFFSET WEST
8.91' OFFSET WEST 1.65' OFFSET WEST 6.27' AT

2650.23 INTERSECTED QUARTER LINE 8.14' WEST OF QUARTER CORNER FOUND STAKE AT CORNER. COR VAR 6-09

SOUTH ON EAST LINE OF SE 1/4 SEC 16 ON A VAR 6-15; OFFST EAST 3.96'AT

2656.17 INTERSECTED SOUTH BOUNDARY LINE 7.26'
EAST OF CORNER. FOUND OLD STAKE AT
CORNER. COR VAR 6-11

1870 RUGER AUG REMON-99 EAST ON NORTH LINE OF NW 1/4

SEC 15 ON A VAR 6-54; OFFSET SOUTH

11.88' OFFSET SOUTH 7.26' AT

SHEET 1 OF 4

CORNER CODE J-13

Pares 0 IT 24, 2011

UN547 NECORSEC16

2614.26

INTERSECTED QUARTER LINE 23.76' SOUTH OF QUARTER CORNER. FOUND REMAINS OF STUMPS OF BOTH BEARING TREES. ESTABLISHED QUARTER CORNER FROM THEM. COR VAR 6-52 EAST ON NORTH LINE OF NE 1/4 SEC 15

ON A VAR 7-55; OFFSET NORTH 12.54'
OFFSET NORTH 11.22'AT

2610.30 INTERSECTED EAST BOUNARY LINE 78.54 NORTH OF CORNER. FOUND REMAINS OF OLD STAKE AT CORNER. COR VAR 6-44

1870 RUGER AUG 27 REMON-92 EAST ON NORTH LINE OF NW
1/4 SEC 16 ON A VAR 8-15, AT

2706.66 INTERSECTED QUARTER LINE AT QUARTER CORNER. FOUND STAKE SURROUNDED BY 4 HARD HEAD STONES SET BY SELF IN A PREVIOUS SURVEY AT CORNER.

EAST ON NORTH LINE OF NE 1/4 SEC 16 ON A VAR 8-05; AT

2678.28 INTERSECTED EAST BOUNDARY LINE 8.08 SOUTH OF CORNER. FOUND STAKE SURROUNDED BY 4 HARD HEAD STONES SET BY SELF AT CORNER IN A PREVIOUS SURVEY.

COR VAR 8-15

1870 RUGER AUG REMON-111 NORTH ON WEST LINE OF SW
1/4 SEC 10 ON A VAR 7-00'; OFFSET EAST 5.28'
OFFSET EAST 88.11' AT

2657.82 INTERSECTED QUARTER LINE 116.82' EAST OF QUARTER CORNER. FOUND STAKE SURROUNDED BY 4 HARD HEAD STONES SET BY SELF AT CORNER IN A PREVIOUS SURVEY. COR VAR 7-30 REMON-113 SOUTH OF WEST LINE OF NW 1/4 SEC 10 ON A VAR 7-10'; OFFSET WEST 8.58' OFFSET EAST 6.6' AT

2653.86 INTERSECTED QUARTER LINE 11.55' WEST OF QUARTER CORNER. COR VAR 7-22

- 1890 BLEEDORN VOL 2 PG 430 MON.
- 1957 BATTERMAN VOL 3 PG 516 DUG HOLE 15'X18'X3' DEEP. FD 6X6X36 MON SURROUNDED 3 LARGE HH. SET 2" IP CENTER RD 3 SOUTH. REFERENCED SAME. 2658.98 TO CUT STONE @ E 1/4 COR SEC 16
- 1976 WOODMAN CSM VOL 6 PG 150 FD 2" PIPE N88-06-40E TO SET PK @ N 1/4 COR SEC 15
- 1993 SCHROEDER #10277 SEC COR MON. EAST TO NE COR SEC 16 & FROM NE COR SEC 16 TO E 1/4 COR SEC 16 IT IS SO1-31W
- 2001 COMBS #14246 FD IRON PIPE WEST 2684.94 TO FD PK @ N

FD PIPE 0.3' DEEP. IN HARMONY WITH RECORD DISTANCES TO FD NW, SW, & SE REFERENCE PIPES.

SEA

SHEET 2 OF 4

CORNER CODE **J-13**

(Fintoss / Baires 0 t 24, 2011 UN547 NECORSEC16

C) Was the corner restored through acceptance of (1) an obliterated evidence location, or, (2) a found perpetuated location?

ACCEPTED FD PIPE WHICH PERPETUATES CUT LIMESTONE THAT BATTERMAN FOUND IN 1957.

D) Describe any material discrepancy between the location of the corner as restored or reestablished and the location of that corner as previously restored or reestablished by distance and direction. Show the discrepancy on the plan view drawing under (a), above. Show the distances between the corner as previously restored or reestablished and (1) the corner as restored or reestablished, and (2) to at least 4 of the witness monuments shown on the drawing in (a), above.

NONE

(E) Was the corner reestablished through lost corner proportionate methods? If so, show the method, including the directions and distances to other public land survey corners used as evidence or used for proportioning the corner location.

 $N\Box$

I, **Donald Barnes**, hereby certify that the corner location as identified by the corner code index was determined by me under my direction and control and that this U.S. Public Land Survey Monument Record is correct and complete to the best of my knowledge and belief.

SHEET 3 OF 4

CORNER CODE J-13

Miless

Mures

July

A.E. 7.08 REQUIREMENT

