
U.S. PUBLIC LAND SURVEY MONUMENT RECORD


For Public Land Survey Corners in UNION TWP. T. 4 N., R. 10 E.

CORNER CODE INDEX

For Miscellaneous Corners within Sec. 20 ,T. 4N., R. 10E.

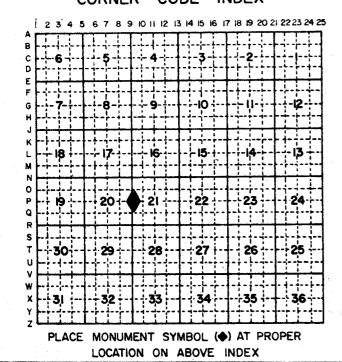

- Above code numbers are positioned Meander, Claim, or Fractional corners of the section.
- Township corner code numbers shall be applied to the corners of above typical section.

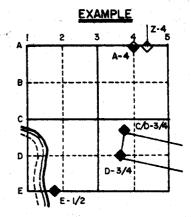

IF AVAILABLE
STATE PLANE COORDINATES

North (Y) Eleve. (Z)

East (X) Zone

Hor. Datum _____ Vert. Datum

CORNER MONUMENT

No 1/4

NE COR SEC 20

NE COR SEC 20

NE COR SEC 20

SEC 21

NO 0388

NEC 2669.04

REC 2669.04

NECROFILMED

SEC 20

SEC 20

SEC 21

NECROFILMED

SEC 20

SEC

SHOW A PLAN VIEW DRAWING DEPICTING THE CORNER MONUMENT AND SURROUNDING PHYSICAL FEATURES, INCLUDING THE EXCAVATION AREA AND DEPTH. THE CORNER MONUMENT SHALL HAVE THE FOLLOWING CHARACTERISTICS: 1) HAVE AT LEAST TWO PREDETERMINED BREAK-OFF POINTS. 2) IF BROKEN, LEAVE A PERMANENTLY MAGNETIZED REMNANT AT THE ORIGINAL POINT. 3) MUST BE EXTENDABLE. 4) THE CAP IS INSCRIBED: ROCK COUNTY SURVEY MONUMENT - PENALTY FOR DISTURBING MARKER. 5) OR AN EXISTING CUT LIMESTONE. AN IRON PIPE 1 × 4'0" (MINIMUM) MAY BE USED IN AREAS WHERE GROUND WATER IS WITHIN ONE FOOT OF THE SURFACE. IF THE CORNER IS OCCUPIED BY AN IMPROVEMENT (MANHOLE, BURIED CABLE, ETC.) ANY DURABLE, DISTINCT MONUMENT MAY BE USED. CORNERS SHALL BE REFERENCED WITH AT LEAST 4 DURABLE WITNESS MONUMENTS. WITNESS MONUMENTS SHALL BE MADE OF CONCRETE, NATURAL STONE, IRON OR OTHER EQUALLY DURABLE MATERIAL, EXCEPT WOOD. DESCRIBE THE CORNER AND THE WITNESS MONUMENTS.

CORNER CODE: P9

(b.) Describe any record evidence, monument evidence, occupational evidence, testimonial evidence or any other material evidence you considered, and whether the monument was found or placed.
DUE & FOUND POSSIBLE SMALL PIECES OF THE CUT LIMESTONE SCATTERED AROUND. USED

RUGER'S 1870 REMONUMENTATION DISTANCES FOR PRORATION TO CONTROL THE N/S LOCATION.
THIS WAS IN HARMONY WITH THE E/W FENCE. RUGER SHOWS A VAR ON THE EAST LINE OF THE
NE% & THE SE% OF SEC 20. THEREFORE I DID NOT SET THE CORNER ON LINE WITH THE NE&SE
OF SEC 20. I USED BROWN'S (1899) RECORD DISTANCE TO THE CENTER OF THE ROAD TO CONTROL
THE E/W LOCATION OF THE CORNER. THE DISTANCE TO THE N/S % LINE OF SEC 21 IS
2669.05 WHICH IS IN HARMONY WITH BLEEDHORN'S (1893) RECORD DISTANCE OF 2669.04.

GET Poly MONUMENT WITH CARSONITE POST.

(c.) Was the corner restored through acceptance of (1) an obliterated evidence location, or, (2) a found perpetuated location?


THE CORNER WAS RESTORED THROUGH ACCEPTANCE OF OBLITERATED EVIDENCE CORNER DISTANCES.

(d.) Describe any material discrepancy between the location of the corner as restored or reestablished and the location of that corner as previously restored or reestablished by distance and direction. Show the discrepancy on the plan view drawing under (a), above. Show the distances between the corner as previously restored or reestablished and (1) the corner as restored or reestablished, and (2) to at least 4 of the witness monuments shown on the drawing in (a), above.

(e) Was the corner reestablished through lost corner proportionate methods? If so, show the method, including the directions and distances to other public land survey corners used as evidence or used for proportioning in determining the corner location.

NO

I, found fours , hereby certify that the corner points as identified by the corner code index were, in a field survey on DEC 14, 1982 , established, re-established, monumented, re-monumented, recovered or restored as expressed below and in conformance with the regulations and rules as required in the current manual of survey instructions of the United States Department of Interior, Bureau of Land Management.

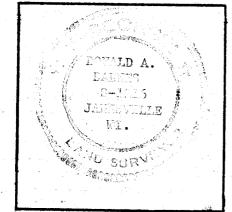

COUNTY SURVEYOR FILING DAY	ra
Date of Computer Entry	·
Date Received	
Date Microfilmed	
Treasurer's Receipt No	
Number of Included Sheets	

AFFIX YOUR LAND SURVEYOR SEAL.