## Paper weight-110# (minimum) Black nonfading ink required LAND SUI SURVEY U.S. **PUBLIC** MONUMENT RECORD


For Public Land Survey Corners In:

WI ADMINISTRATIVE CODE A-E 7.08 REQUIREMENT

REV 10/23/2004 USMONREC.DWG

T.  $\frac{4}{N}$  N. R.  $\frac{10}{E}$  E. 4th P.M.

CORNER CODE INDEX

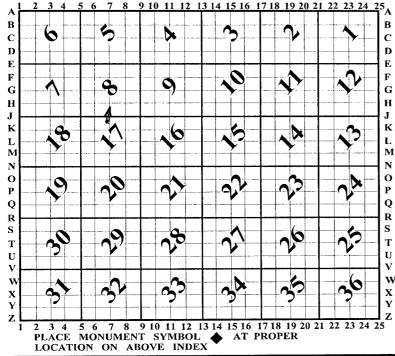

# UNION TWP **ROCK COUNTY WI**

IF AVAILABLE ROCK COUNTY COORDINATES PERFERRED

Elev. North East Hor. Datum \_\_\_\_\_ Vert. Datum LATITUDE ELLIPS. HT. LONGITUDE \_\_\_\_ NAD83(91) \_\_\_\_\_NETWORK ADJ. YR 2010 GPS (X) \_\_\_\_ TRAVERSE (X) X BASED ON THE FOLLOWING CONTROL:

**◆ CORNER MONUMENT** 

O WITNESS MONUMENT

1	2 PI L(
(a)	)
ROCK COUNTY PROJECTION	
,	
	BASED
	ARE
	BEARINGS

FIELD BOOK PAGE #	1		7	
OR OBSERVATION SHEET SHEET		OF		
SHOW A PLAN VIEW DRAWING DEPICTING THE CORNER MONUMENT AND SURROUN	DING			
PHYSICAL FEATURES, INCLUDING THE EXCAVATION AREA AND DEPTH.				
PLANNING & ZONING COMMITTEE ADOPTED THIS FORM ON 12/2/1982	-			

#### UN544 N1/4CORSEC17

(B) Describe any record evidence, monument evidence, occupational evidence, testimonial evidence or any other material evidence you considered, and whether the monument was found or placed.

- 1833 HARRISON (NOV 10) EAST ON RAND. BET SECS 8 & 17
  - 1026.96 ROAD S.E.
  - 2640.00 TEMPY 1/4 SEC COR.
  - 3960.00 BROOK 5.28' CRS S.E.
  - 5286.60 ROAD S.W
  - 5330.16 E BDY 19.8'S OF P LAND ROLLING 2ND RATE TIMBER RED BURR & W.O. GROWTH GRASS & WEEDS

## WEST COR WEST BET 8 & 17

- 2663.43 QUARTER SEC COR {BURR O 20 N40W 13.2'; BURR O 12 S72E 19.8' BURR O 20 & BURR O 12}MARKED
- 5330.16 SEC COR NOV 10TH 1833
- 1856 CHURCH VOL 1 PG 58 STATES NOTHING ABOUT MON 2682.24 TO SW COR SEC 8, 2642.64 TO CENTER OF SEC 8, 5285.28 TO N 1/4 COR SEC 8. TO SUBDIVIDE SEC 8.
- 1856 CHURCH VOL 1 PG 59 STATES NOTHING ABOUT MON. USED TO SUBDIVIDE SEC 17. VAR 8 2649.24 TO CENTER OF SEC 17 & VAR 8 5298.48 TO S 1/4 COR SEC 17.
- 1870 RUGER AUG REMON-90 EAST ON NORTH LINE OF NW 1/4

  SEC 17 ON A VAR 7-10; OFFSET NORTH 20.46'

  OFFSET NORTH 18.15' OFFSET SOUTH 15.84'

  COULD FIND NO TRACE OF QUARTER CORNER.

  CONTINUED EAST ON SAME VARIATION AT
  - 5379.00 INTERSECTED EAST BOUNDARY LINE AT CORNER ESTABLISHED NORTH QUARTER CORNER IN A TRUE LINE BETWEEN AND EQUI-DISTANT FROM THE NE AND NW CORNERS OF SAID SECTION, IT BEING 2689.50 DISTANT FROM EACH. COR VAR 7-40
- 1890 BLEEDORN VOL 2 PG 430 MON USED TO SUBDIVIDE SEC 17
- 1892 BLEEDORN VOL 2 PG 429 MON. USED TO SUBDIVIDE SEC 8
- 1938 SUNNY VOL 3 PG 403 DUG AT BOTH PLACED FD NOTHING.
  {THE N. LINE OF SEC 17 IS ABOUT 20' SOUTH OF CENTER OF
  RD} SHOWS BUTTS CORNER SCHOOL WITH WEST FACE OF
  SCHOOL ON N/S 1/4 LINE & NORTH FACE OF SCHOOL @
  SOUTH LINE OF RD.
- 1979 BARNES VOL 5 PG 527 FD CUT LIMESTONE. SET IP HORIZONTALLY ON S. SIDE & REFERENCES SAME. 30' SOUTH OF PVMT CENTER, ON LINE WITH N/S FENCE, & 24.81 NW FOR NW COR OF HOUSE
- 1979 BARNES VOL 5 PG 528 S88-55-09W 2694.14 TO NW COR SEC 7. N88-56-07E 2694.14 TO NE COR SEC 17, & SO-41-12E 5311.26 TO S 1/4 COR SEC 17
- 1980 DOT #332 RDS B-E
- 1988 BARNES #12708 FD LS. N1-17-02E 2651.72 TO INT OF 1/4 LINES & N1-17-02E 5320.50 TO LS @ N 1/4 COR SEC 8
- 2000 KARNS CSM VOL 23 PG 67 ROCK COUNTY SEC. COR. STATED NOTHING ABOUT MON. 5321.44 TO ROCK COUNTY SEC. COR @ N1/4 COR SEC 8
- 2000 KARNS CSM VOL 23 PG 116 ROCK COUNTY SECTION CORNER. 2691.76 TO ROCK COUNTY SECTION CORNER @ NW COR SEC 17
- 2000 KARNS CSM VOL 23 PG 117 ROCK COUNTY SECTION CORNER. S1-02-07W 5310.87 TO ROCK COUNTY SECTION CORNER @ S 1/4 COR SEC 17

SHEET 1 OF 2

CORNER CODE J-7

Dans 07 25,2011 UN544 5 1/4 8

## FD CUT LIMESTONE & REFERENCE MONUMENTS

C) Was the corner restored through acceptance of (1) an obliterated evidence location, or, (2) a found perpetuated location?

## ACCEPTED FD GUT LIMESTONE

D) Describe any material discrepancy between the location of the corner as restored or reestablished and the location of that corner as previously restored or reestablished by distance and direction. Show the discrepancy on the plan view drawing under (a), above. Show the distances between the corner as previously restored or reestablished and (1) the corner as restored or reestablished, and (2) to at least 4 of the witness monuments shown on the drawing in (a), above.

NONE

(E) Was the corner reestablished through lost corner proportionate methods? If so, show the method, including the directions and distances to other public land survey corners used as evidence or used for proportioning the corner location.

RUGER ESTABLISHED BY THE LOST CORNER PROPORTIONATE METHOD. THE FD STONE IS 0.22 OFF A LINE BETWEEN THE SW & SE CORNERS OF SEC 8. IT IS ALSO WITHIN 0.09 OF THE MID POINT.

I, **Donald Barnes**, hereby certify that the corner location as identified by the corner code index was determined by me under my direction and control and that this U.S. Public Land Survey Monument Record is correct and complete to the best of my knowledge and belief.

SHEET 2 OF 2

OLTZ0,2011

CORNER CODE J-7

A.E. 7.08 REQUIREMENT