Paper weight-110# (minimum)

Black nonfading ink required

U.S. PUBLIC LAND SURVEY MONUMENT RECORD


For Public Land Survey Corners In:

WI ADMINISTRATIVE CODE A-E 7.08 REQUIREMENT

EV 10/23/2004 USMONREC.DWG

T. 4 N. R. 10 E. 4th P.M.

CORNER CODE INDEX

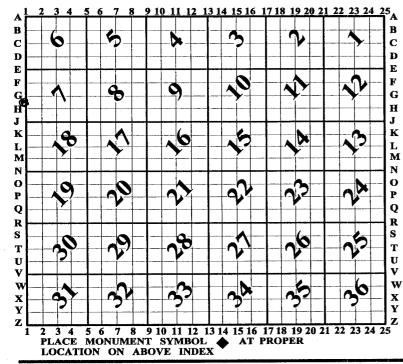

UNION TWP

IF AVAILABLE ROCK COUNTY COORDINATES PERFERRED

North	Elev
East	
Hor. Datum	Vert. Datum
LATITUDE	ELLIPS. HT.
LONGITUDE	
NAD83(91)	NETWORK ADJ. YR 2010
GPS (X)	TRAVERSE (X) X
BASED ON THE	FOLLOWING CONTROL:

♦ CORNER MONUMENT

WITNESS MONUMENT

ROCK COUNTY PROJECTION

BEARINGS ARE BASED ON:_

(a)

EYA COR SEC 13 THN R 9E GREEN COUNTY

FIELD BOOK ____ PAGE # ____ OR OBSERVATION SHEET ___ SHEET ___ OF ___ SHOW A PLAN VIEW DRAWING DEPICTING THE CORNER MONUMENT AND SURROUNDING PHYSICAL FEATURES, INCLUDING THE EXCAVATION AREA AND DEPTH.

PLANNING & ZONING COMMITTEE ADOPTED THIS FORM ON 12/2/1982 ____ /// ft

CORNER CODE 6

UN 6560 E1/4COR SEC 13 T4N R9E GREEN COUNTY

(B) Describe any record evidence, monument evidence, occupational evidence, testimonial evidence or any other material evidence you considered, and whether the monument was found or placed.

1833 MULLETT (SEP) NORTH ON EAST SIDE SEC 13

2640 SET 1/4 SECTION POST IN PRAIRIE MADE A MOUND

2937 ROAD FROM MINERAL POINT TO KOSCONONG EBW

4620 LEAVE PRAIRIE

5280 SET POST FOR CORNER TO SECTIONS 12 & 13

BUR DAK 24 S17E 80.52'; BUR DAK 12 N43E 89.76'

LAND ROLLING RICH DRY PRAIRIE NORTH OF

PRAIRIE THINLY TIMBERED WITH BUR OAK
NEEDLE ATTACTED 100' WEST

1870 RUGER AUG REMON-122 NORTH ON WEST LINE OF SW 1/4 SEC 7 ON A VAR 5-O5; AT

2640.00 INTERSECTED QUARTER LINE AT QUARTER CORNER. FOUND STONE AT CORNER AND OLD STAKE UNDER STONE.

NORTH ON WEST LINE OF NW 1/4 SEC 7 ON A VAR 4-55; AT

2630.76 INTERSECTED NORTH BOUNDARY LINE AT CORNER FOUND STONE AT CORNER AND OLD STAKE UNDER STONE. ALSO FOUND STUMPS OF BEARING TREES.

- 1977 BARNES VOL 5 PG 366 SET ON LINE WITH E 1/4 SEC 13
 (GREEN CO.) & THE NE COR SEC 13 @ SINGLE
 PROPORTIONATE DIS. SET ALUM MON. REFERENCED SAME.
 1' SOUTH OF E/W FENCE LINE ON EAST SIDE OF RD. W 1/16TH
 COR OF NW 1/4 SEC 7 DUG & FD 4' DEEP ASPHALT RD. DUG
 3' MORE & FD NOTHING.
- 1977 BARNES VOL 5 PG 369 2646.63 TO SW COR SEC 7, 2637.37 TO NW COR SEC 7, & 894.36 NORTHERLY FROM E 1/4 COR SEC 13 COR
- 1979 TALARCZYK #7000 ALUMINUM MON. SET IN PLACE OF STONE FOUND. REFERENCED SAME.

ON 6/1/11 I FD ALUM. MON. & SW & NW REFERENCE PINS.

C) Was the corner restored through acceptance of (1) an obliterated evidence location, or, (2) a found perpetuated location?

ACCEPTED ALUM, WHICH PERPETUATES STONE.

D) Describe any material discrepancy between the location of the corner as restored or reestablished and the location of that corner as previously restored or reestablished by distance and direction. Show the discrepancy on the plan view drawing under (a), above. Show the distances between the corner as previously restored or reestablished and (1) the corner as restored or reestablished, and (2) to at least 4 of the witness monuments shown on the drawing in (a), above.

$N\Box$

(E) Was the corner reestablished through lost corner proportionate methods? If so, show the method, including the directions and distances to other public land survey corners used as evidence or used for proportioning the corner location.

I, **Donald Barnes**, hereby certify that the corner location as identified by the corner code index was determined by me under my direction and control and that this U.S. Public Land Survey Monument Record is correct and complete to the best of my knowledge and belief.

SHEET 1 OF \$

CORNER CODE G/H 1

A.E. 7.08 REQUIREMENT

Emicas Aug 16, 20// DBSERVATION SHEET #141
1977 TALARCZYK #7000

E 1/4 COR

SEC 13

T4N R9E

