

U.S. PUBLIC LAND SURVEY MONUMENT RECORD

For Public Land Survey Corners In:

WI ADMINISTRATIVE CODE A-E 7.08 REQUIREMENT

T. 4 N. R. 10 E. 4th P.M.

REV 10/23/2004

USMONREC.DWG

CORNER CODE INDEX

1	2	3	4	5	6	7	8	9	10	11	12	13	14	15	16	17	18	19	20	21	22	23	24	25	
A																									A
B																									B
C	6																								C
D																									D
E																									E
F																									F
G	7																								G
H																									H
I																									I
J																									J
K	18																								K
L																									L
M																									M
N																									N
O																									O
P	19																								P
Q																									Q
R																									R
S																									S
T	30																								T
U																									U
V																									V
W																									W
X	31																								X
Y																									Y
Z																									Z

UNION TWP

ROCK COUNTY WI

IF AVAILABLE
ROCK COUNTY COORDINATES PREFERRED

North _____ Elev. _____

East _____

Hor. Datum _____ Vert. Datum _____

LATITUDE _____ ELLIPS. HT. _____

LONGITUDE _____

NAD83(91) _____ NETWORK ADJ. YR 2010

GPS (X) _____ TRAVERSE (X) X

BASED ON THE FOLLOWING CONTROL:

PLACE MONUMENT SYMBOL AT PROPER LOCATION ON ABOVE INDEX

CORNER MONUMENT

WITNESS MONUMENT

(a)

ROCK COUNTY PROJECTION

BEARINGS ARE BASED ON:

NE 36
TAN
R 9E

BROOKLYN TWP

FIELD BOOK _____ PAGE # _____

OR OBSERVATION SHEET _____

SHEET 1 OF 3

SHOW A PLAN VIEW DRAWING DEPICTING THE CORNER MONUMENT AND SURROUNDING PHYSICAL FEATURES, INCLUDING THE EXCAVATION AREA AND DEPTH.

PLANNING & ZONING COMMITTEE ADOPTED THIS FORM ON 12/2/1982

CORNER CODE R/S-1

UN 6613 NE COR SEC 36 T4 N9E GREEN COUNTY

(B) Describe any record evidence, monument evidence, occupational evidence, testimonial evidence or any other material evidence you considered, and whether the monument was found or placed.

- 1833 MULLETT (SEP) VAR 8-10E VAR 8-10E NORTH ON EAST SIDE OF SEC 36
- 2640 SET 1/4 SEC POST IN PRAIRIE MADE MOUND OF EARTH & ??
- 5280 SET POST FOR CORNER TO SECTIONS 25 & 36 IN PRAIRIE. MADE A MOUND.
LAND ROLLING DRY PRAIRIE SECOND RATE COVERED WITH A SHORT GRASS
- 1833 MULLETT T4N R9E (SEP) VAR 8-10E NORTH ON EAST SIDE OF SEC 25
- 2640 SET 1/4 SEC POST IN PRAIRIE AND MADE MOUND
- 5280 SET POST TO SECTIONS 24 & 25 IN PRAIRIE & MADE MOUND.
LAND & C SAME AS LAST MILE NOTE NEEDLE ATTRACTED 30' WEST
- 1833 HARRISON T4N R10E 4TH MER WEST BETWEEN SECS 19 & 30
- 2640.00 QUARTER SEC COR. SET POST & RAISED MOUND
- 5570.40 INT. RANGE LINE SET POST & RAISED MOUND
LAND ROLLING 1ST RATE PRAIRIE GROWTH GRASS & WEEDS
- 1833 HARRISON T4N R9E EAST ON RANDOM BET SECS 25 & 36
- 2640.00 TEMPORARY 1/4 SEC COR.
- 5206.08 INT. E BNDY 125.4' N OF P. LAND ROLLING 1ST RATE PRAIRIE RATHER BROKEN GROWTH PRAIRIE GRASS & WEEDS
WEST COR WEST BET SECS 25 & 36
- 2603.04 QUARTER SEC CORNER MARKED POST & RAISED MOUND
- 1860 RUGER VOL 1 PG 148 @ SW COR SEC 19 T4N R10E SET LIMESTONE 20X10X7 & SET SAND STONE ON SOUTH & LIMESTONE ON NORTH SIDES. VAR 7-55 2931.72, VAR 7-55 5579.64 TO SET LS 18X9X6 @ NE COR SEC 30, 2636.70 TO W 1/4 COR SEC 30, 5273.40 TO SW COR SEC 30, & SOUTHERLY TO SET LS 15X9X3 LIMESTONE & SET LS ON WEST & SAND STONE ON EAST SIDE OF SE COR SEC 25.
- 1870 RUGER AUG REMON-85 WEST ON NORTH LINE OF NE 1/4 SEC 30 ON A VAR 7-11; AT
- 2647.48 INTERSECTED QUARTER LINE AT QUARTER CORNER. FOUND HARD HEAD STONE ON CORNER SET BY SELF IN PREVIOUS SURVEY.
WEST ON NORTH LINE OF NW 1/4 SEC 30 ON A VAR 7-30; AT
- 2931.28 INTERSECTED WEST BOUNDARY LINE AT CORNER. FOUND LIMESTONE AT CORNER SET BY SELF IN PREVIOUS SURVEY.
- 1978 TALARCZYK #5234 ALUMINUM MON. CORNER SET BY PROPORTIONATE MEASUREMENT & EXISTING PHYSICAL EVIDENCE. REFERENCED SAME.

FD ALUM MON 6" DEEP & NW REF PIN. FD NE REF 1 1/4" PIN LAYING HORIZONTALLY .3' DEEP. RESET PIN. MON IS 3.44' EAST OF LINE BETWEEN W 1/4 & NW CORNERS OF SEC 30. SO-07-03W 2640.37 TO E 1/4 COR SEC 36 & NO-10-22E 2609.97 TO E 1/4 COR SEC 25. NO 15-39W 908.34 TO NW COR SEC 30.

SEAL

Emboss

Ronald Roney
4/09/2012

SHEET 1 OF 3
CORNER CODE R/S-1

UN 6613 NE COR SEC 36 T4 N9E GREEN COUNTY

C) Was the corner restored through acceptance of (1) an obliterated evidence location, or, (2) a found perpetuated location?

DID NOT ACCEPT NOR REJECT MONUMENT. TALARCZYK DID NOT FIND RUGER'S LIMESTONE.

D) Describe any material discrepancy between the location of the corner as restored or reestablished and the location of that corner as previously restored or reestablished by distance and direction. Show the discrepancy on the plan view drawing under (a), above. Show the distances between the corner as previously restored or reestablished and (1) the corner as restored or reestablished, and (2) to at least 4 of the witness monuments shown on the drawing in (a), above.

(E) Was the corner reestablished through lost corner proportionate methods? If so, show the method, including the directions and distances to other public land survey corners used as evidence or used for proportioning the corner location.


I, **Donald Barnes**, hereby certify that the corner location as identified by the corner code index was determined by me under my direction and control and that this U.S. Public Land Survey Monument Record is correct and complete to the best of my knowledge and belief.



SHEET 2 OF 3

4/9/2012

CORNER CODE R/S-1
A.E. 7.08 REQUIREMENT

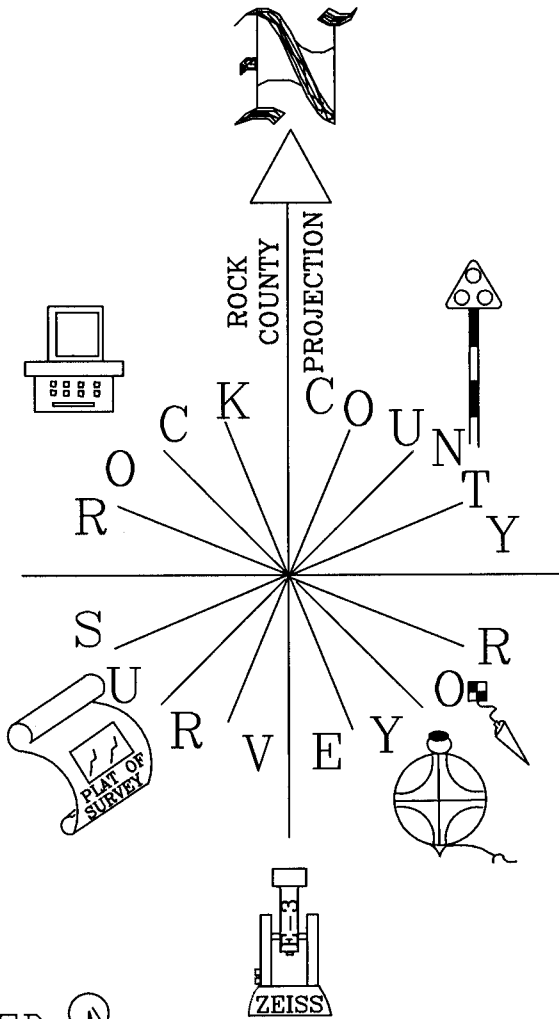

SET 5/8X24 REROD

NOT TO SCALE

BROOKLYN TWP

OBSERVATION SHEET #254
1976 TALARCZYK #5234

NE COR
SEC 36
T4N R9E

FD 1 1/4 PIN
/ CARSONITE

N00-45-15E 144.91

S16-31-08E 103.535

S32-26-56E 105.11

N00-15-39W
908.34
TO NW COR
SEC 30

NEW UP
4-5'

1977 107.35

FD ALUM
6" DEEP

29.19
N64-39-31E
1976 30.39

FD 1 1/4 PIN
HORIZONTALLY
RESET PIN

CTH C

IREC
110
1976 53.62
N36-08-32E 54.12
N46-03-10E 80.98

STH 104

SHEET 3 OF 3

EMBOSSSED SEAL
SEARCHED &
FD NOTHING
SET 5/8X24 REROD

R/S-1

Handwritten signature
4/9/2012