

U.S. PUBLIC LAND SURVEY MONUMENT RECORD


For Public Land Survey Corners in the
T. 2 N., R. 12 E.

CORNER CODE INDEX

	1	2	3	4	5	6	7	8	9	10	11	12	13	14	15	16	17	18	19	20	21	22	23	24	25
A																									
B																									
C	6																								
D		5																							
E			4																						
F				3																					
G					2																				
H																									
I																									
J	7																								
K		8																							
L			9																						
M				10																					
N					11																				
O						12																			
P	13																								
Q		14																							
R			15																						
S				16																					
T					17																				
U						18																			
V							19																		
W								20																	
X									21																
Y										22															
Z											23														
												24													
													25												
														26											
															27										
																28									
																	29								
																		30							
																			31						
																				32					
																					33				
																						34			
																							35		
																								36	

PLACE MONUMENT SYMBOL (◆) AT PROPER LOCATION ON ABOVE INDEX

EXAMPLE

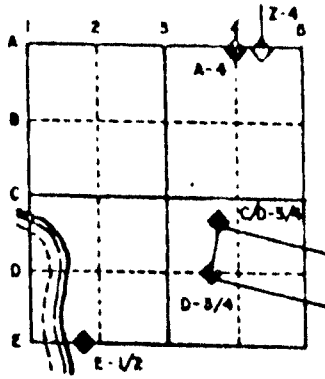


ROCK TWP
ROCK COUNTY WI

IF AVAILABLE STATE PLANE COORDINATES

North (Y) _____ Elev. (Z) _____
 East (X) _____ Zone _____
 Hor. Datum _____ Vert. Datum _____

◆ CORNER MONUMENT ○ WITNESS MONUMENT

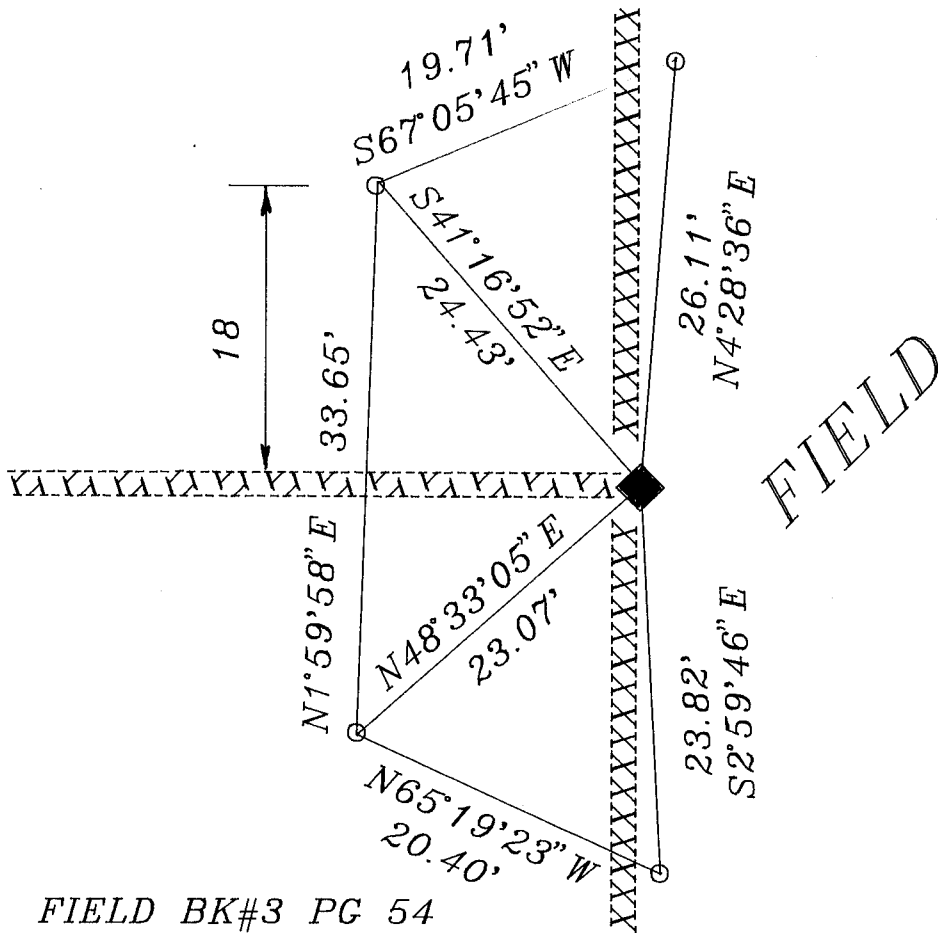

FIELD BK#3 PG 54

○ 3/4X24 REROD WITH YELLOW PLASTIC CAP.

◆ REPLACED 2 1/2X3' IRON PIPE WITH POLY MONUMENT. PLACED PIPE HORIZONTALLY ON TOP OF MONUMENT AND CARSONITE ON SE SIDE

BEARINGS ARE BASED ON: ASSUMED

MICROFILMED

SHEET _____ OF _____

CORNER CODE: P17

(B) Describe any record evidence, monument evidence, occupational evidence, testimonial evidence or any other material evidence you considered, and whether the monument was found or placed.

- 1836 LYON ORIGINAL GOVERNMENT SURVEYOR. FIELD NOTES - SET QUARTER SECTION POST AND MADE MOUND OF EARTH AND SOD.
- 1876 RUGER VOL 2 PG 217 FOUND OLD STAKE AND PUT IN ITS PLACE NEW STAKE WITH LIMESTONES ON EAST AND WEST SIDES. SHOWS 2637.36 TO CENTER OF SECTION 23.
- 1881 HOLMES VOL 2 PG 340 STAKE AND STONES. SHOWS 2647.26 TO SW CORNER OF SECTION 23.
- 1941 SUNNY VOL 3 PG 469. DUG AND FOUND NOTHING ESTABLISHED 1/4 CORNER AT CROSS FENCE. SET 2"X36" IRON PIPE MONUMENT FOR CORNER. SHOWS 2652.4 TO NW COR SEC 23, 2642.1 TO CENTER SEC 23, AND 2645.3 TO SW COR SEC 23.
- 1989 BARNES VOL 6 PG 396 SHOWS THE FOLLOWING DISTANCES:
- | | | |
|-----------------------------------|----------------|---------|
| TO: NW COR SEC 23 | S1-31-15E | 2651.52 |
| | BATTERMAN 1958 | 2651.94 |
| CEN 23 | N89-23-07E | 2641.32 |
| SW COR SEC 23 | S1-33-48E | 2643.26 |
| | BATTERMAN 1958 | 2644.74 |
| SW COR OF NW 1/4 OF SW 1/4 SEC 23 | S1-33-45E | 1321.50 |

FOUND 2 1/2" PIPE. REPLACED WITH POLY MONUMENT.



C) Was the corner restored through acceptance of (1) an obliterated evidence location, or, (2) a found perpetuated location?

ACCEPTED FOUND MONUMENT.

D) Describe any material discrepancy between the location of the corner as restored or reestablished and the location of that corner as previously restored or reestablished by distance and direction. Show the discrepancy on the plan view drawing under (a), above. Show the distances between the corner as previously restored or reestablished and (1) the corner as restored or reestablished, and (2) to at least 4 of the witness monuments shown on the drawing in (a), above.

(E) Was the corner reestablished through lost corner proportionate methods? If so, show the method, including the directions and distances to other public land survey corners used as evidence or used for proportioning the corner location.

I, Donald Barnes, hereby certify that the corner points as identified by the corner code index were, in a field survey on, November 20, 1991, established, re-established, monumented, re-monumented, recovered or restored as expressed below and in conformance with the regulations and rules as required in the current manual of survey instructions of the United States Department of Interior, Bureau of Land Management.

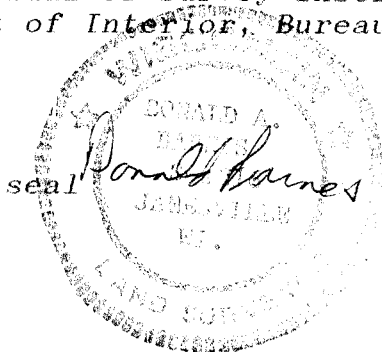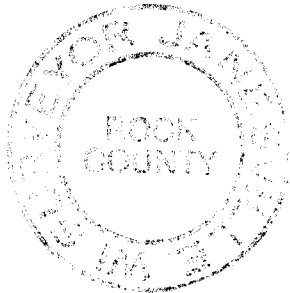

COUNTY SURVEYOR FILING DATA

Date of computer entry _____

Date microfilmed _____

Number of included sheets _____

CORNER CODE

AFFIX YOUR LAND SURVEYOR SEAL