

U.S. PUBLIC LAND SURVEY MONUMENT RECORD


For Public Land Survey Corners in the
T. 2 N., R. 12 E.

CORNER CODE INDEX

	1	2	3	4	5	6	7	8	9	10	11	12	13	14	15	16	17	18	19	20	21	22	23	24	25
A																									
B																									
C	6																								
D		5																							
E			4																						
F				3																					
G					2																				
H	7																								
I		6																							
J			5																						
K				4																					
L	18				3																				
M		17				2																			
N			16				1																		
O				15																					
P	19																								
Q		20																							
R			21																						
S				22																					
T					23																				
U						24																			
V							25																		
W								26																	
X	31								27																
Y		32								28															
Z			33								29														
				34								30													
					35								31												
						36								32											

PLACE MONUMENT SYMBOL (◆) AT PROPER LOCATION ON ABOVE INDEX

EXAMPLE

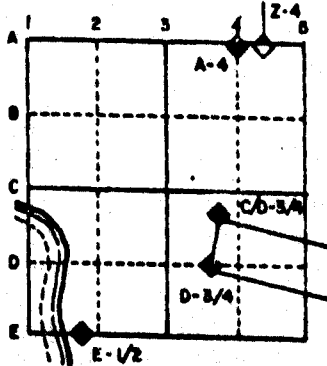


ROCK TWP
ROCK COUNTY WI

IF AVAILABLE
STATE PLANE COORDINATES

North (Y) _____ Eleve. (Z) _____
 East (X) _____ Zone _____
 Hor. Datum _____ Vert. Datum _____

e) ◆ CORNER MONUMENT ○ WITNESS MONUMENT

BEARINGS ARE BASED ON: ASSUMED

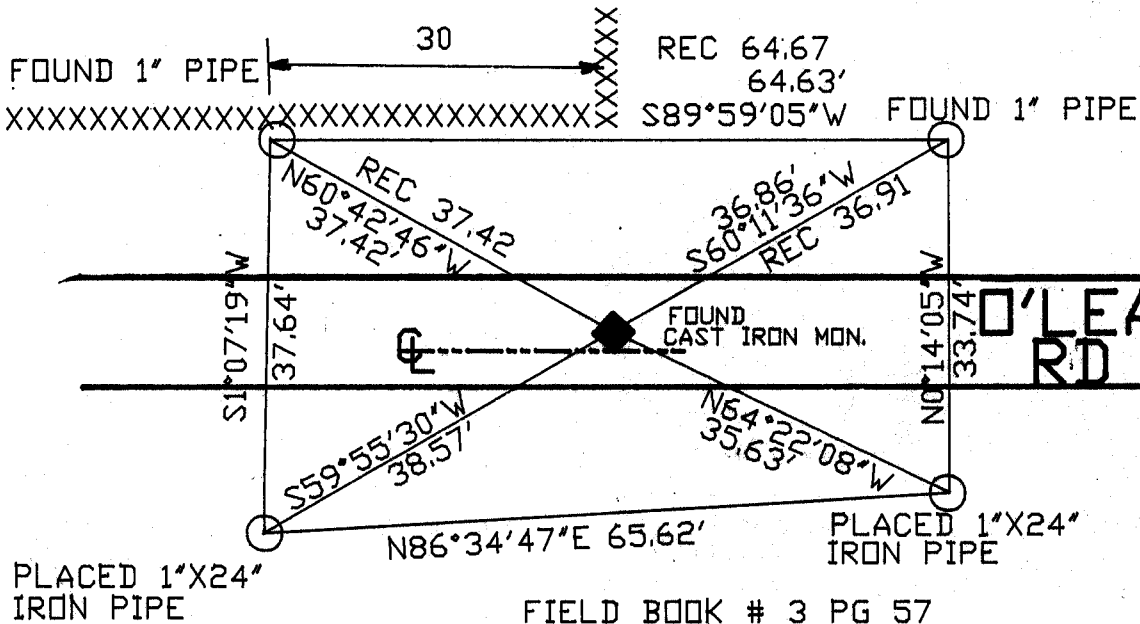

FIELD BOOK # 3 PG 57
2 PG 52

MICROFILMED

SHEET ___ OF ___

CORNER CODE: 57

(B) Describe any record evidence, monument evidence, occupational evidence, testimonial evidence or any other material evidence you considered, and whether the monument was found or placed.

- 1834 HARRISON ORIGINAL GOVERNMENT SURVEYOR. FIELD NOTES - PLACED POST. BEARING TREES - W.O. 8 N34W 181 & W.O. 8 S49W 122. SHOWS A DISTANCE OF 2659.80 TO SE AND SW CORNERS OF SECTION 8.
- 1868 LOCKE VOL 1 PG 316 FOUND STUMPS OF BEARING TREES AND OLD STAKE, SET BUR OAK STAKE WITH HARD HEADS ON NORTH, SOUTH, EAST AND WEST. SHOWS A DISTANCE OF 2681.91 TO THE SE CORNER OF SECTION 8.
- 1868 LOCKE VOL 1 PG 321 FOUND CORNER AS SET BY SELF.
- 1892 BLEEDORN. VOL 2 PG 462 FOUND STAKE, SET STAKE AND SURROUNDED IT WITH 4 HARD HEADS. SHOWS A DISTANCE OF 2695.44 TO THE SW CORNER OF SECTION 8
- 1973 LEE VOL 4 PG 593 DUG AND FOUND REMAINS OF STAKE SURROUNDED ON NORTH SOUTH AND EAST BY HARDHEADS 1.7' DEEP. REFERENCED SAME BUT DOES NOT STATE THE TYPE OF MONUMENT THAT HE PLACED.
- 1973 LEE VOL 5 PG 16. FOUND STAKE AND 3 HARD HEADS. REFERENCED SAME AND RE-REFERENCED 9/18/1974
- 1973 LEE VOL 5 PG 49 FOUND STAKE AND HARD HEADS ON NORTH, SOUTH AND EAST REFERENCED SAME.

FOUND CAST IRON MONUMENT THAT IS IN HARMONY WITH REFERENCE PIPES. **ADDED 4" RISER.**



C) Was the corner restored through acceptance of (1) an obliterated evidence location, or, (2) a found perpetuated location?

ACCEPTED FOUND PERPETUATED LOCATION.

D) Describe any material discrepancy between the location of the corner as restored or reestablished and the location of that corner as previously restored or reestablished by distance and direction. Show the discrepancy on the plan view drawing under (a), above. Show the distances between the corner as previously restored or reestablished and (1) the corner as restored or reestablished, and (2) to at least 4 of the witness monuments shown on the drawing in (a), above.

(E) Was the corner reestablished through lost corner proportionate methods? If so, show the method, including the directions and distances to other public land survey corners used as evidence or used for proportioning the corner location.

I, Donald Barnes, hereby certify that the corner points as identified by the corner code index were, in a field survey on, JULY 21, 1989, established, re-established, monumented, re-monumented, recovered or restored as expressed below and in conformance with the regulations and rules as required in the current manual of survey instructions of the United States Department of Interior Bureau of Land Management.

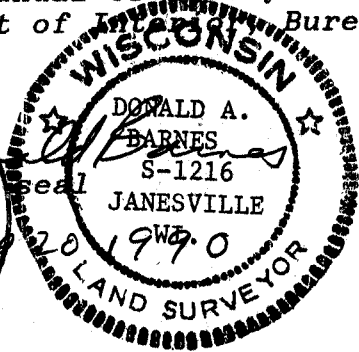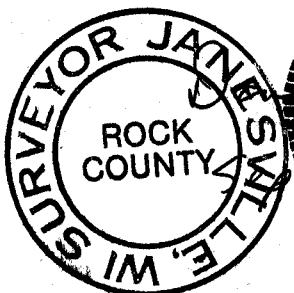

COUNTY SURVEYOR FILING DATA

Date of computer entry _____

Date microfilmed _____

Number of included sheets _____
CORNER CODE

AFFIX YOUR LAND SURVEYOR SEAL

57