Paper weight-110# (minimum)

Black nonfading ink required


## LAND **SURVEY** U.S. **PUBLIC** MONUMENT RECORD

For Public Land Survey Corners In:

WI ADMINISTRATIVE CODE A-E 7.08 REQUIREMENT

T. 4 N. R. 10 E. 4th P.M.

CORNER CODE INDEX

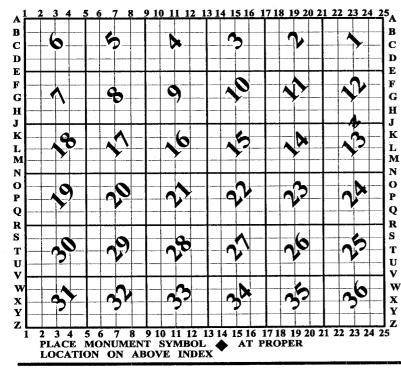

## **UNION TWP ROCK COUNTY WI**

IF AVAILABLE ROCK COUNTY COORDINATES PERFERRED

North	Elev
East	
Hor. Datum	Vert. Datum
LATITUDE	ELLIPS. HT.
LONGITUDE	
NAD83(91)	NETWORK ADJ. YR 2010
GPS (X)	TRAVERSE (X) X
BASED ON THE	FOLLOWING CONTROL:

**◆ CORNER MONUMENT** 

WITNESS MONUMENT

(a) ROCK COUNTY PROJECTION BEARINGS ARE BASED ON:\_

FIELD BOOK PAGE #		1	フ
OR OBSERVATION SHEET		OF	
SHOW A PLAN VIEW DRAWING DEPICTING THE CORNER MONUMENT AN	D SURROUND	ING	
PHYSICAL FEATURES, INCLUDING THE EXCAVATION AREA AND DEPTH.			
PLANNING & ZONING COMMITTEE ADOPTED THIS FORM ON 12/2/1982			フ
CODIED	CODE	J- Z	>

## UN552 S1/4CORSEC12

(B) Describe any record evidence, monument evidence, occupational evidence, testimonial evidence or any other material evidence you considered, and whether the monument was found or placed.

1833 HARRISON (OCT) EAST ON RAND. BET SECS 12 & 13 T4N R1 DE

1452 BROOK 3.3' CRS N.E.

2640 SET TEMPY 1/4 SEC COR

5188.92 INT. E BDY 46.2' NORTH OF POST LAND ROLLING 1ST RATE PRAIRIE.

WEST COR WEST BET SEC 12 & 13

2627.46 QUARTER SEC COR {SET POST & RAISED MOUND OF EARTH & SOD

2594.46 PENCELED IN BELOW 2627.46

5188.92 SEC COR

1870 RUGER AUG REMON-102 EAST ON NORTH LINE OF NW
1/4 SEC 13 ON A VAR 6-25; OFFSET NORTH
16.5' AT

2614.48 INTERSECTED QUARTER LINE AT QUARTER CORNER. FOUND REMAINS OF OLD STAKE AT CORNER. COR VAR 6-46

EAST ON NORTH LINE OF NE 1/4 SEC 13 ON A VAR 6-50; OFFSET SOUTH 5.61 AT

2597.10 INTERSECTED EAST BOUNDARY LINE 3.96'
NORTH OF CORNER. FOUND OLD STAKE
SURROUNDED BY LINE STONES AT CORNER.
COR VAR 6-38

1909 KERCH VOL 3 PG 51 MON. {EASTERLY} 1302 TO GAS PIPE, NORTHERLY 1341.8 TO DROVE 2" GAS PIPE, & NORTHERLY 2683.6 TO SET 2" GAS PIPE LIMESTONE ON N SIDE & HH ON SIDE @ CENTER OF SEC 12. USED TO SUBDIVIDE SEC 12

1976 BARNES VOL 5 PG 124 FD CUT STONE 5 1/2X6 .5' DEEP. REFERENCED SAME.

1976 COMBS CSM VOL 5 PG 246 CUT STONE. NORTH 1341.43 TO 1/16TH COR.

1993 COMBS #9871 FD LS. NORTH TO PK @ CENTER OF SEC 12, S89-34-10E TO CUT LS. @ SE COR SEC 12

2000 COMBS CSM VOL 23 PG 443 STATES NOTHING ABOUT MON. 2621.76 TO NW COR SEC 13.

2005 KARNS #15012 & # 15013 FD LIMESTONE. S0-06-15E 2614.42 ALONG SEC LINE. N89-32W 49.50 TO REBAR, & N62-00-17E 28.35 TO REBAR

FD CUT L.S. 1.5' DEEP. SET CARSONITE ON WEST SIDE & 3 MAGNETS ON TOP.

C) Was the corner restored through acceptance of (1) an obliterated evidence location, or, (2) a found perpetuated location?

## ACCEPTED FD CUT LIMESTONE WHICH PERPETUATES FOUND STAKE.

- D) Describe any material discrepancy between the location of the corner as restored or reestablished and the location of that corner as previously restored or reestablished by distance and direction. Show the discrepancy on the plan view drawing under (a), above. Show the distances between the corner as previously restored or reestablished and (1) the corner as restored or reestablished, and (2) to at least 4 of the witness monuments shown on the drawing in (a), above. NDNE
- (E) Was the corner reestablished through lost corner proportionate methods? If so, show the method, including the directions and distances to other public land survey corners used as evidence or used for proportioning the corner location.  $N \square$
- I, **Donald Barnes**, hereby certify that the corner location as identified by the corner code index was determined by me under my direction and control and that this U.S. Public Land Survey Monument Record is correct and complete to the best of my knowledge and belief.

SHEET 1 OF 2

CORNER CODE J-23

23, 20// A.E. 7.08 REQUIREMENT

