

# U.S. PUBLIC LAND SURVEY MONUMENT RECORD

For Public Land Survey Corners in  
ROCK TWP. T. 2 N., R. 12 E.

For Miscellaneous Corners within  
 Sec. 34, T. 3 N., R. 12 E.


## CORNER CODE INDEX

	1	2	3	4	5	6	7	8	9	10	11	12	13	14	15	16	17	18	19	20	21	22	23	24	25
A													◆												
B																									
C	6																								
D																									
E																									
F																									
G																									
H																									
I																									
J																									
K																									
L	18																								
M																									
N																									
O																									
P																									
Q	19																								
R																									
S																									
T	30																								
U																									
V																									
W																									
X	31																								
Y																									
Z																									

PLACE MONUMENT SYMBOL (◆) AT PROPER LOCATION ON ABOVE INDEX


IF AVAILABLE  
 STATE PLANE COORDINATES

North (Y) 246,255.04 Eleve. (Z) \_\_\_\_\_  
 East (X) 2,249,826.67 Zone SOUTH  
 Hor. Datum \_\_\_\_\_ Vert. Datum \_\_\_\_\_

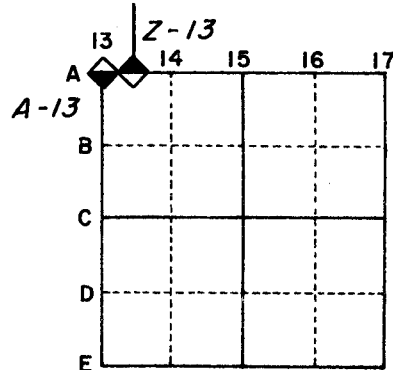

1. Above code numbers are positioned Meander, Claim, or Fractional corners of the section.
2. Township corner code numbers shall be applied to the corners of above typical section.

### EXAMPLE

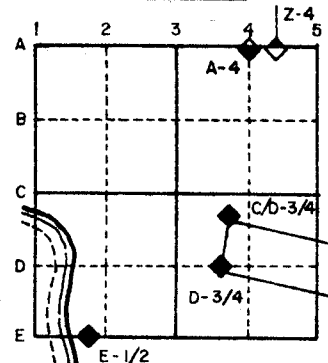

(a) ◆ CORNER MONUMENT ○ WITNESS MONUMENT

- 1-2 S88°41'04"E 20.03'
- 1-3 S44°35'13"E 28.56'
- 1-4 S23°24'09"W 28.18'
- 1-5 S57°19'09"W 52.32'
- 1-6 N25°00'09"E 41.87'
- 2-3 S 0°03'16"E 19.88'
- 2-6 N 3°28'36"W 38.48'
- 3-4 S79°58'36"W 31.73'
- 4-5 S85°50'25"W 32.93'
- 5-6 N43°00'07"E 50.52'

BEARINGS ARE BASED ON:

ALUMINUM MONUMENT  
 NW COR. SECTION 3  
 ROCK TOWNSHIP  
 T2N R12E

CORNER SET AT GRADE.

ALUMINUM MONUMENT  
 SW COR. SECTION 34  
 JANESVILLE TOWNSHIP  
 T3N R12E

2" IRON STAKE

ALL REFERENCE CORNERS ARE  
 3/4" DIA. REINF. BARS. UNLESS  
 OTHERWISE NOTED.

FIELD BOOK \_\_\_\_\_ PAGE # \_\_\_\_\_

SHOW A PLAN VIEW DRAWING DEPICTING THE CORNER MONUMENT AND SURROUNDING PHYSICAL FEATURES, INCLUDING THE EXCAVATION AREA AND DEPTH. THE CORNER MONUMENT SHALL HAVE THE FOLLOWING CHARACTERISTICS: 1) HAVE AT LEAST TWO PREDETERMINED BREAK-OFF POINTS. 2) IF BROKEN, LEAVE A PERMANENTLY MAGNETIZED REMNANT AT THE ORIGINAL POINT. 3) MUST BE EXTENDABLE. 4) THE CAP IS INSCRIBED: ROCK COUNTY SURVEY MONUMENT - PENALTY FOR DISTURBING MARKER. 5) OR AN EXISTING CUT LIMESTONE. AN IRON PIPE 1 1/2" x 4'0" (MINIMUM) MAY BE USED IN AREAS WHERE GROUND WATER IS WITHIN ONE FOOT OF THE SURFACE. IF THE CORNER IS OCCUPIED BY AN IMPROVEMENT (MANHOLE, BURIED CABLE, ETC.) ANY DURABLE, DISTINCT MONUMENT MAY BE USED. CORNERS SHALL BE REFERENCED WITH AT LEAST 4 DURABLE WITNESS MONUMENTS. WITNESS MONUMENTS SHALL BE MADE OF CONCRETE, NATURAL STONE, IRON OR OTHER EQUALLY DURABLE MATERIAL, EXCEPT WOOD. DESCRIBE THE CORNER AND THE WITNESS MONUMENTS.

CORNER CODE: A-13

- (b.) Describe any record evidence, monument evidence, occupational evidence, testimonial evidence or any other material evidence you considered, and whether the monument was found or placed.

Found Aluminum Monument.

Monument record made to conform with A-E 5.02 (A) Wisconsin Administrative Code. There was no Monument record for this corner.

- (c.) Was the corner restored through acceptance of (1) an obliterated evidence location, or, (2) a found perpetuated location?

N/A


- (d.) Describe any material discrepancy between the location of the corner as restored or reestablished and the location of that corner as previously restored or reestablished by distance and direction. Show the discrepancy on the plan view drawing under (a), above. Show the distances between the corner as previously restored or reestablished and (1) the corner as restored or reestablished, and (2) to at least 4 of the witness monuments shown on the drawing in (a), above.

N/A

- (e.) Was the corner reestablished through lost corner proportionate methods? If so, show the method, including the directions and distances to other public land survey corners used as evidence or used for proportioning in determining the corner location.

N/A

I, Roger D. Schneeberger, hereby certify that the corner points as identified by the corner code index were, in a field survey on May 3, 1983, established, re-established, monumented, re-monumented, recovered or restored as expressed below and in conformance with the regulations and rules as required in the current manual of survey instructions of the United States Department of Interior, Bureau of Land Management.

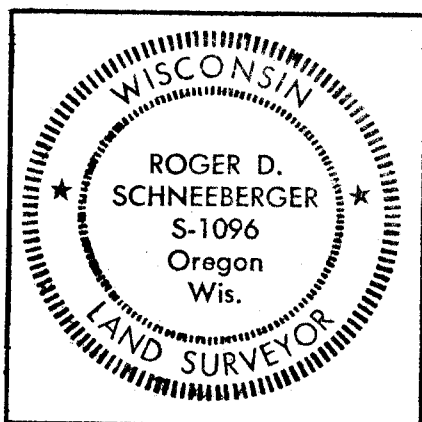

COUNTY SURVEYOR FILING DATA

Date of Computer Entry \_\_\_\_\_

Date Received \_\_\_\_\_

Date Microfilmed \_\_\_\_\_

Treasurer's Receipt No. \_\_\_\_\_

Number of Included Sheets \_\_\_\_\_

AFFIX YOUR LAND SURVEYOR SEAL.

A13