


U.S. PUBLIC LAND SURVEY MONUMENT RECORD

For Public Land Survey Corners in the
T. 2 N., R. 12 E.

CORNER CODE INDEX

| | | | | | | | | | | | | | | | | | | | | | | | | | |
|---|---|---|---|---|---|---|---|---|---|----|----|----|----|----|----|----|----|----|----|----|----|----|----|----|----|
| | 1 | 2 | 3 | 4 | 5 | 6 | 7 | 8 | 9 | 10 | 11 | 12 | 13 | 14 | 15 | 16 | 17 | 18 | 19 | 20 | 21 | 22 | 23 | 24 | 25 |
| A | | | | | | | | | | | | | | | | | | | | | | | | | |
| B | | | | | | | | | | | | | | | | | | | | | | | | | |
| C | 6 | | | | | | | | | | | | | | | | | | | | | | | | |
| D | | 5 | | | | | | | | | | | | | | | | | | | | | | | |
| E | | | 4 | | | | | | | | | | | | | | | | | | | | | | |
| F | | | | 3 | | | | | | | | | | | | | | | | | | | | | |
| G | | | | | 2 | | | | | | | | | | | | | | | | | | | | |
| H | | | | | | | | | | | | | | | | | | | | | | | | | |
| I | | | | | | | | | | | | | | | | | | | | | | | | | |
EXAMPLE

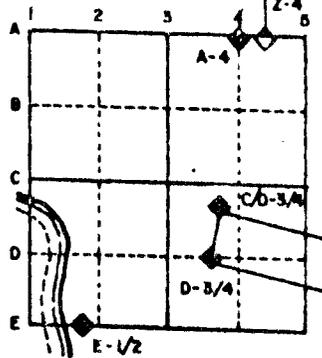

ROCK TWP
ROCK COUNTY WI

IF AVAILABLE
STATE PLANE COORDINATES

North (Y) 243,516.10 Eleve. (Z) _____

East (X) 2,249,839.14 Zone _____

Hor. Datum _____ Vert. Datum _____

243,515.24
2,249,838.86

PLACE MONUMENT SYMBOL (◆) AT PROPER
LOCATION ON ABOVE INDEX


WPL

◆ CORNER MONUMENT

○ WITNESS MONUMENT

Poly mon

BEARINGS ARE BASED ON: TOWNSHIP PROJECT

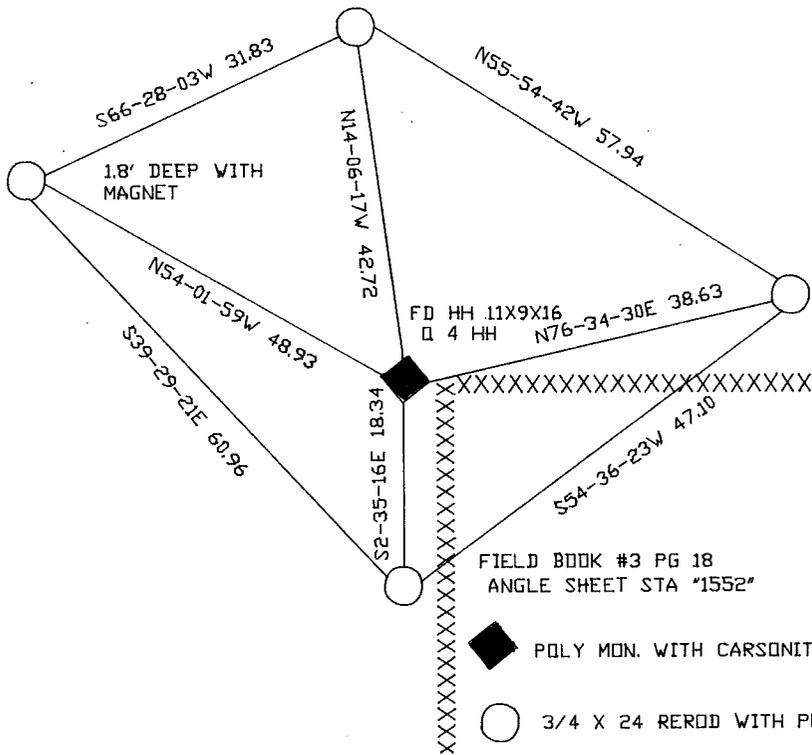

◆ POLY MON. WITH CARSONITE
○ 3/4 X 24 REROD WITH PLASTIC ORANGE CAP

SHEET ___ OF ___

CORNER CODE: C 13

(B) Describe any record evidence, monument evidence, occupational evidence, testimonial evidence or any other material evidence you considered, and whether the monument was found or placed.

1834 HARRISON ORIGINAL GOVERNMENT SURVEYOR. FIELD NOTES - BURR OAK 10 N72E E 50 AND BURR OAK 10 N55W 106. SHOWS A DISTANCE OF 2698.08 TO NW CORNER OF SECTION 3.

1865 LOCKE VOL 1 PG 241 FOUND BURR OAK S 18E 50 (THAT BEARS THE GOVERNMENT MARK) AND OLD STAKE. SET HARDHEAD 16 X 11 X 7 1/2 AND SURROUNDED IT BY 5 HARDHEADS.

1866 LOCKE VOL 1 PG 267. FOUND CORNER AS SET BY SELF. SHOWS A DISTANCE OF 2641.32 TO CENTER OF SECTION 3.

1981 BARNES VOL 6 PG 186 SHOWS WPL COORDINATES OF N/S 243,515.24; E/W 2,249,838.86. SHOWS THE FOLLOWING DISTANCES;

| | | | |
|-----------------------|--------|-----------|---------|
| TO NW CORNER OF SEC 3 | BARNES | N0-15-18W | 2739.83 |
| | RUGER | | 2740.65 |
| | WPL | N0-15-01W | 2719.34 |

FOUND 11X9X16 HH SURROUNDED BY 4 HH. REPLACED WITH POLY MONUMENT.



C) Was the corner restored through acceptance of (1) an obliterated evidence location, or, (2) a found perpetuated location?

ACCEPTED FOUND HARDHEAD STONE OF RECORD.

D) Describe any material discrepancy between the location of the corner as restored or reestablished and the location of that corner as previously restored or reestablished by distance and direction. Show the discrepancy on the plan view drawing under (a), above. Show the distances between the corner as previously restored or reestablished and (1) the corner as restored or reestablished, and (2) to at least 4 of the witness monuments shown on the drawing in (a), above.

(E) Was the corner reestablished through lost corner proportionate methods? If so, show the method, including the directions and distances to other public land survey corners used as evidence or used for proportioning the corner location.

I, Donald Barnes, hereby certify that the corner points as identified by the corner code index were, in a field survey on, July 19, 1990, established, re-established, monumented, re-monumented, recovered or restored as expressed below and in conformance with the regulations and rules as required in the current manual of survey instructions of the United States Department of Interior, Bureau of Land Management.

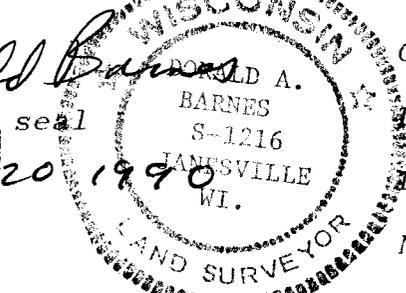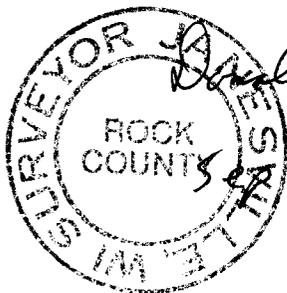

COUNTY SURVEYOR FILING DATA

Date of computer entry _____

Date microfilmed _____

Number of included sheets _____

CORNER CODE

AFFIX YOUR LAND SURVEYOR SEAL

C 13