

# U.S. PUBLIC LAND SURVEY MONUMENT RECORD

For Public Land Survey Corners In:

WI ADMINISTRATIVE CODE A-E 7.08 REQUIREMENT

T. 1 N. R. 10 E.

CORNER CODE INDEX

1	2	3	4	5	6	7	8	9	10	11	12	13	14	15	16	17	18	19	20	21	22	23	24	25	
A																									A
B																									B
C	6																								C
D																									D
E																									E
F																									F
G	7																								G
H																									H
J																									J
K																									K
L	18																								L
M																									M
N																									N
O																									O
P	19																								P
Q																									Q
R																									R
S																									S
T																									T
U	30																								U
V																									V
W																									W
X	31																								X
Y																									Y
Z																									Z

AVON TWP

ROCK COUNTY WI

IF AVAILABLE  
ROCK COUNTY COORDINATES PREFERRED

North \_\_\_\_\_ Elev. \_\_\_\_\_

East \_\_\_\_\_

Hor. Datum \_\_\_\_\_ Vert. Datum \_\_\_\_\_

LATITUDE \_\_\_\_\_ ELLIPS. HT. \_\_\_\_\_

LONGITUDE \_\_\_\_\_

GPS (X) \_\_\_\_\_ TRAVERSE (X) \_\_\_\_\_

BASED ON THE FOLLOWING CONTROL:  
\_\_\_\_\_

PLACE MONUMENT SYMBOL  AT PROPER LOCATION ON ABOVE INDEX

CORNER MONUMENT

WITNESS MONUMENT

(a)

BEARINGS ARE BASED ON: \_\_\_\_\_

FIELD BOOK \_\_\_\_\_ PAGE # \_\_\_\_\_

SHEET 1 OF 3

SHOW A PLAN VIEW DRAWING DEPICTING THE CORNER MONUMENT AND SURROUNDING PHYSICAL FEATURES, INCLUDING THE EXCAVATION AREA AND DEPTH.

PLANNING & ZONING COMMITTEE ADOPTED THE ABOVE FORM ON 12/2/1982

CORNER CODE R 13

AV587

(B) Describe any record evidence, monument evidence, occupational evidence, testimonial evidence or any other material evidence you considered, and whether the monument was found or placed.

- 1833 HARRISON NORTH BET. SECS 27 & 28  
297 INT. SUGAR CRK. 66' CRS EAST. SET A MEANDER POST FROM WHICH A RED O. 12 IN IN DIAM. BEARS S30E  
136.62' LAND & SAME AS BEFORE.
- 1834 HARRISON NORTH BET. SECS 27 & 28 CONT.  
1745.7 LEAVE RIVER SET M.P. AND ENTER MAPLE BOTTOM {MAPLE 16 N18W 23.1' MAPLE 28 N32E 56.1'  
1815.66 ELM 12  
2310 ELM 10  
2640 LEAVE TIMBER & ENTER MARSH SET COR TO QUARTER SEC {MAPLE 12 S37W 108.9', ELM 10 S7E 135.3' MAPLE 12, ELM 10} MARKED  
5280 COR TO SECS 21, 22, 27, 28 IN MARSH
- 1833 HARRISON EAST ON RAND. BET. SEC 21 & 28  
198 INT. SUGAR CRK ON SOUTH SET A MEANDERING POST & RAISED MOUND. LAND & SAME.
- 1834 HARRISON EAST ON A RAND. BET 21 & 28 CONT.  
392.7 LEAVE RIVER SET MEANDER? POST AND ENTER ELM & MAPLE BOTTOM  
1980 LEAVE IT & ENTER W & RED OAK TIMBER  
2640 TEMPY 1/4 POST  
2970 ENTER WET MARSH  
5263.5 INT. E BDY 19.8' NORTH OF POST. LAND LEVEL & WET 3RD RATE TIMBER ELM, MAPLE W & RED OAK.  
WEST COR. WEST  
2631.09 QUARTER SEC COR. RED O 10 S35E 17.82', RED OAK 12 N26W 13.2'  
4870.8 SET M.P. ON LEFT BANK SUGAR CREEK WILLOW 10 N12E 13.86'; ELM 12 N18W 49.5'  
5263.5 SEC COR.
- 1834 HARRISON EAST BET. 22 & 27 ON RAND.  
2640 TEMP 1/4 POST NEAR NORTH EDGE OF MARSH  
5233.8 INT. EAST BDY 59.4' NORTH OF POST  
LAND LEVEL & WET 3<sup>RD</sup> RATE MARSH  
COR WEST  
2616.9 QUARTER SEC COR. {W.O. 24 N10E 365.64' RED OAK 10 N12W 370.92' W OAK 24 & RED OAK 10} MARKED.  
5233.8 SEC COR.
- 1834 HARRISON NORTH BET SEC 21 & 22  
1320 LEAVE WET PRAIRIE & ENTER DRY PRAIRIE  
2640 QUARTER SEC COR IN PRAIRIE POST & MOUND  
5280 COR TO SECS 15, 16, 21, 22 SET POST & RAISED MOUND LAND LEVEL AND 2<sup>ND</sup> RATE PRAIRIE FOR LAST 3/4 OF A MILE. LEVEL & WET 3<sup>RD</sup> RATE FOR 1<sup>ST</sup> 3/4
- 1879 RUGER VOL 2 PG 252 SET HH 17X11X9. THE COR IS IN LINE WITH E & W FENCES & 33' E OF FENCE ON W SIDE OF ROAD.  
VAR 4-10 2623.5 TO S 1/4 COR SEC 22.
- 1972 LEE VOL 4 PG 573 COR OBVIOUSLY GONE. C. SHIMEALL SET R/R SPIKE. REF. COR. TO CONC. BRIDGE CORNERS.
- 1979 BARNES VOL 5 PG 557 N1-12-57E 2663.49 TO W 1/4 COR SEC 22. FD R/R  
FD R/R 0.2' DEEP & ON TOP OF LARGE CONCRETE CULVERT.

Donald Barnes

11-29-01

SHEET 1 OF 3  
CORNER CODE R-13

AV587

C) Was the corner restored through acceptance of (1) an obliterated evidence location, or, (2) a found perpetuated location?

ACCEPTED FD R/R SPIKE.

D) Describe any material discrepancy between the location of the corner as restored or reestablished and the location of that corner as previously restored or reestablished by distance and direction. Show the discrepancy on the plan view drawing under (a), above. Show the distances between the corner as previously restored or reestablished and (1) the corner as restored or reestablished, and (2) to at least 4 of the witness monuments shown on the drawing in (a), above.

(E) Was the corner reestablished through lost corner proportionate methods? If so, show the method, including the directions and distances to other public land survey corners used as evidence or used for proportioning the corner location.

I, Donald Barnes, hereby certify that the corner location as identified by the corner code index was determined by me under my direction and control and that this U.S. Public Land Survey Monument Record is correct and complete to the best of my knowledge and belief.

Seal

*Donald Barnes*  
Emboss


11-29-01

SHEET 2 OF 3


CORNER CODE

**R-13**

A.E. 7.08 REQUIREMENT

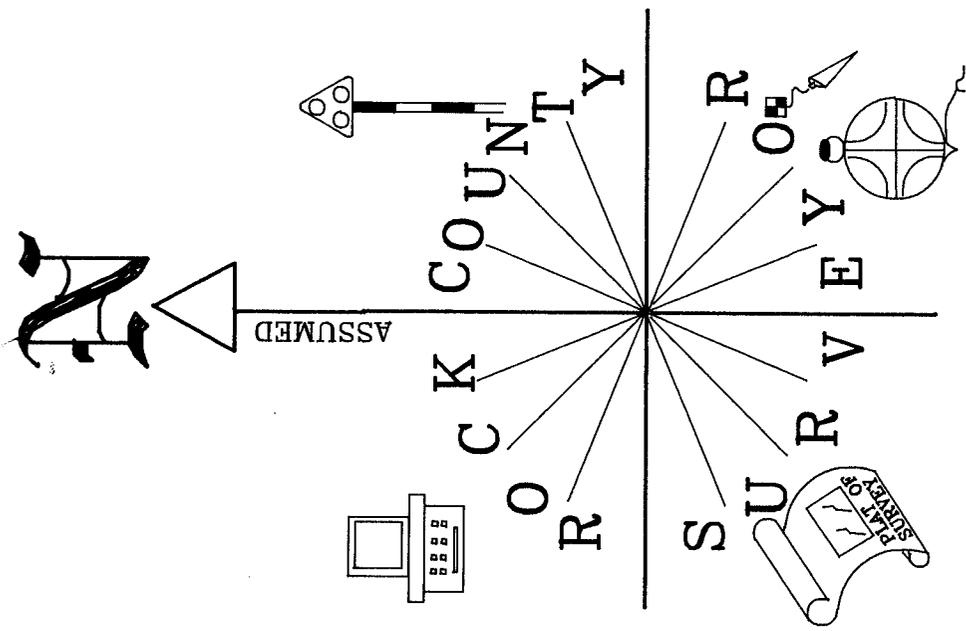

- ⊙ SE COR SEC 21  
FD R/R 0.2' DEEP
  - 3/4"X24" REROD  
/PLASTIC CAP
  - COTTON PIN
- NOT TO SCALE
- OBSERATION SHEET #212  
ASSUMED ELEVATION

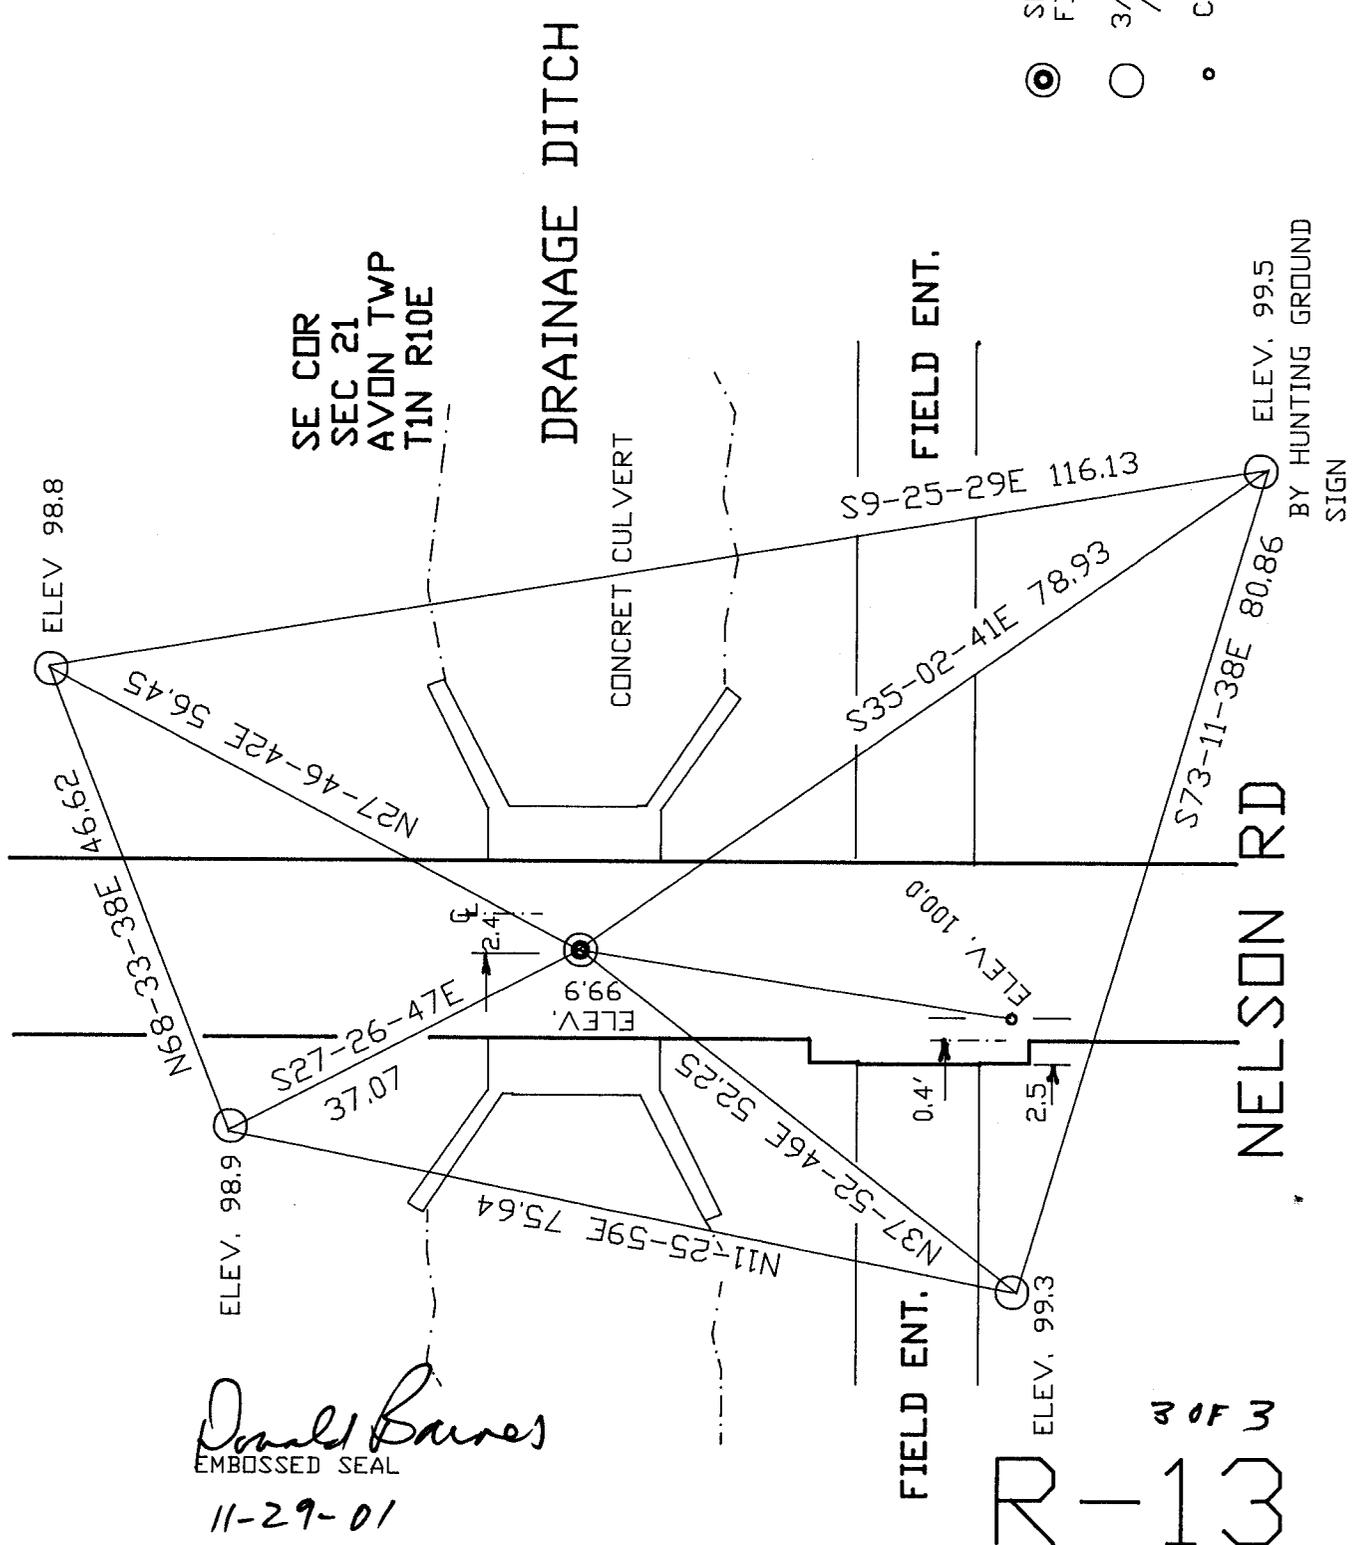

*Donald Barnes*  
EMBOSSSED SEAL  
11-29-01