


U.S. PUBLIC LAND SURVEY MONUMENT RECORD

For Public Land Survey Corners in the
 T. 1 N., R. 10 E.
CORNER CODE INDEX

	1	2	3	4	5	6	7	8	9	10	11	12	13	14	15	16	17	18	19	20	21	22	23	24	25
A																									
B																									
C	6	5	4	3	2																				
D																									
E																									
F																									
G	7	8	9	10	11	12																			
H																									
I																									
J																									
K																									
L	16	17	18	15	14	13																			
M																									
N																									
O																									
P	19	20	21	22	23	24																			
Q																									
R																									
S																									
T	30	29	28	27	26	25																			
U																									
V	◆																								
W																									
X	31	32	33	34	35	36																			
Y																									
Z																									

PLACE MONUMENT SYMBOL (◆) AT PROPER LOCATION ON ABOVE INDEX

EXAMPLE

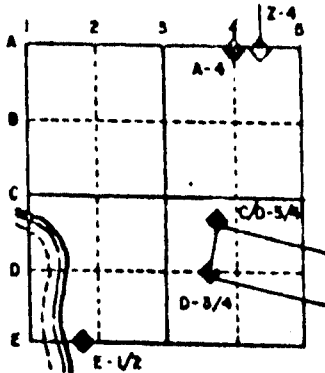

Avon TWP
 ROCK COUNTY WI

IF AVAILABLE
 STATE PLANE COORDINATES

North (Y) _____ Eleve. (Z) _____
 East (X) _____ Zone _____
 Hor. Datum _____ Vert. Datum _____

◆ CORNER MONUMENT

○ WITNESS MONUMENT

BEARINGS ARE BASED ON: ASSUMED

MICROFILMED

PLACED CARSONITE

14" TREE

N9°21'24"W
 88.68'

DRIVE

S32°46'20"E
 97.35'

DRAINAGE DITCH

○ 3/4X24 REROD

◆ PLACED POLY MON

FIELD BOOK #2 PG 48

DRAINAGE DITCH

19.83'
 N12°12'40"E
 5.78'

S81°36'12"W
 38.69'

XXXXXXXXXXXXXXXXXXXX

DRAINAGE DITCH

S59°29'14"W
 49.30'

SHEET ___ OF ___

CORNER CODE: V3

(B) Describe any record evidence, monument evidence, occupational evidence, testimonial evidence or any other material evidence you considered, and whether the monument was found or placed.

1833 HARRISON. ORIGINAL SURVEYOR SET POST FOR COR TO 1/4 SEC. FR. WH. A BURR OAK 24 BEARS S3W 56.1. CALLS FOR 2597.76 TO NW CORNER OF SECTION 31 AND 2640 TO NE CORNER OF SECTION 31.

1975 BICKEL PLAT OF SURVEY. ESTABLISHED AND PLACED CAST IRON MONUMENT AT THE CENTER OF SECTION 30. DOES NOT CALL FOR ANYTHING AT THE N 1/4 CORNER OF SECTION 31. HIS CAST IRON MONUMENT IS .69 OFF A LINE BETWEEN THIS CORNER AND A POINT AT THE N 1/4 CORNER OF SECTION 30 IF SAID CORNER WAS ESTABLISHED BY SINGLE PROPORTIONATE MEASUREMENT. SUNNY USED THE N/S FENCE TO ESTABLISH THE CENTER OF SECTION 31. SUNNY'S PIPE IS .15 OFF A LINE BETWEEN THE NORTH AND SOUTH QUARTER CORNERS OF SECTION 31.

ESTABLISHED THE CORNER AT SINGLE PROPORTIONATE DISTANCE. THIS IS IN HARMONY WITH THE MONUMENTS ESTABLISHED FOR THE CENTERS OF SECTION 30 AND 31. PLACED POLY MONUMENT MONUMENT AND CARSONITE POST NEXT TO SOUTH REFERENCE MONUMENT.

C) Was the corner restored through acceptance of (1) an obliterated evidence location, or, (2) a found perpetuated location?


NO

D) Describe any material discrepancy between the location of the corner as restored or reestablished and the location of that corner as previously restored or reestablished by distance and direction. Show the discrepancy on the plan view drawing under (a), above. Show the distances between the corner as previously restored or reestablished and (1) the corner as restored or reestablished, and (2) to at least 4 of the witness monuments shown on the drawing in (a), above.

(E) Was the corner reestablished through lost corner proportionate methods? If so, show the method, including the directions and distances to other public land survey corners used as evidence or used for proportioning the corner location.

YES

I, Donald Barnes, hereby certify that the corner points as identified by the corner code index were, in a field survey on, DECEMBER 10, 1991, established, re-established, monumented, re-monumented, recovered or restored as expressed below and in conformance with the regulations and rules as required in the current manual of survey instructions of the United States Department of Interior, Bureau of Land Management.

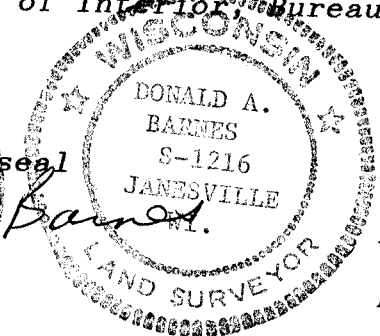

AFFIX YOUR LAND SURVEYOR SEAL

COUNTY SURVEYOR FILING DATA

Date of computer entry _____

Date microfilmed _____

Number of included sheets _____
CORNER CODE