

U.S. PUBLIC LAND SURVEY MONUMENT RECORD


For Public Land Survey Corners in the
T. 1 N., R. 10 E.

CORNER CODE INDEX

	1	2	3	4	5	6	7	8	9	10	11	12	13	14	15	16	17	18	19	20	21	22	23	24	25
A																									
B																									
C	6																								
D		5																							
E			4																						
F				3																					
G					2																				
H																									
I																									
J	7																								
K		8																							
L			9																						
M				10																					
N					11																				
O						12																			
P							13																		
Q								14																	
R									15																
S										16															
T											17														
U												18													
V													19												
W														20											
X															21										
Y																22									
Z																	23								
																		24							
																			25						
																				26					
																					27				
																						28			
																							29		
																								30	
																									31
																									32
																									33
																									34
																									35
																									36

PLACE MONUMENT SYMBOL (◆) AT PROPER LOCATION ON ABOVE INDEX

EXAMPLE

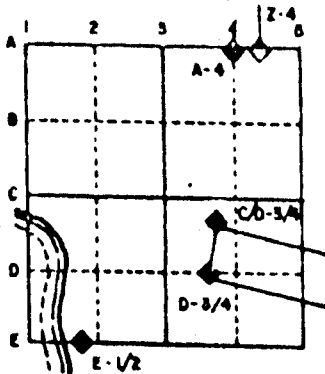

AVON TWP
ROCK COUNTY WI

IF AVAILABLE
STATE PLANE COORDINATES

North (Y) _____ Eleve. (Z) _____
 East (X) _____ Zone _____
 Hor. Datum _____ Vert. Datum _____


◆ CORNER MONUMENT

○ WITNESS MONUMENT

BEARINGS ARE BASED ON: ASSUMED

FIELD BOOK #2 PG 51

○ FOUND 1" PIPE

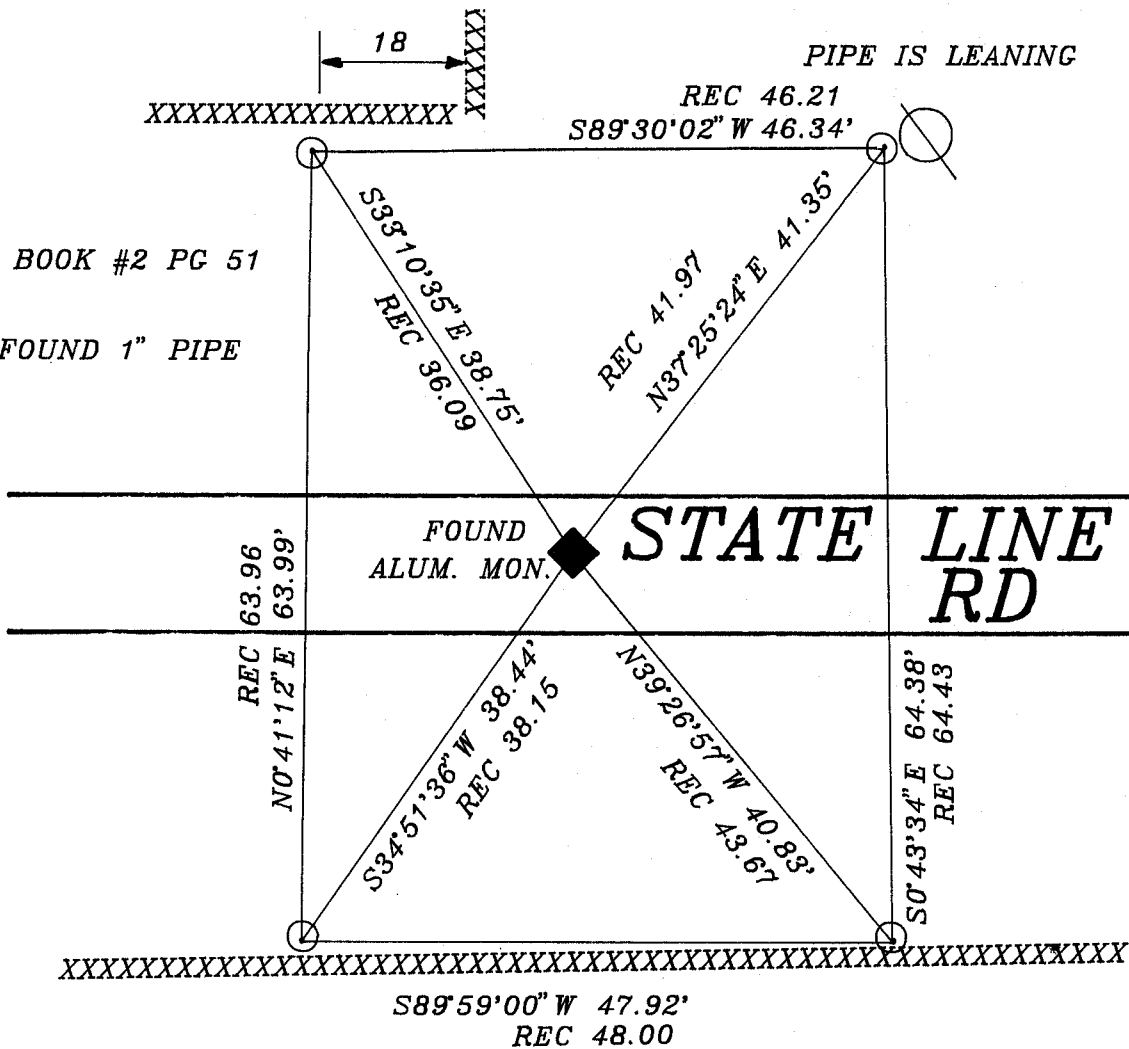

MICROFILMED

SHEET ___ OF ___

CORNER CODE: 23

(B) Describe any record evidence, monument evidence, occupational evidence, testimonial evidence or any other material evidence you considered, and whether the monument was found or placed.

- 1833 LYONS SET POST FOR 1/4 SECTION CORNER. ASPIN 10 N76E 15.84',BITTER NUT 11 N20 1/2W 29.7'.
- 18?? RUGER FOUND STUMP OF NW BT AND STUMPS OF NE BT WASHED OUT. DROVE STAKE SURROUNDED BY 3 HH STONES
- 1932 SUNNY VOL 3 PG 216 FOUND STONE MONUMENT 33'S OF N FENCE MEASURED 33 SOUTH OF NORTH FENCE,NORTH FENCE SAID TO BE 33 NORTH OF SECTION LINE.
- 1932 MAP #80012 FOUND SQUARE LIMESTONE MONUMENT ABOUT 4X4 ON TOP AND PROBABLY 6X6 ON BOTTOM, TOP 6" WAS BROKE OFF AND IT WAS SURROUNDED BY 4 HH. SET BROKEN TOP BACK ON ITS BASE AND READJUSTED HH. SET 40 D SPIKE 10'EAST.
- 1977 BARNES VOL 5 PG 295 DUG AND FOUND CUT LIMESTONEE 9X6 SURROUNDED BY 3 HH THAT WAS 4' DEEP. REFERENCED SAME.
- 1977 BARNES VOL 5 PG 304 PLACED ALUMINUM MONUMENT.
- 1981 BARNES VOL 6 PG 169 FOUND ALUMINUM MONUMENT. CALLS FOR 2636.02 TO SE CORNER AND 2639.71 TO SW CORNER OF SECTION 31.
- 1981 HAWKINS MAP #00112 FOUND CUT STONE 1964. CALLS FOR 672 TO NE CORNER OF SECTION 21.

FOUND ALUMINUM MONUMENT.



C) Was the corner restored through acceptance of (1) an obliterated evidence location, or, (2) a found perpetuated location?

ACCEPTED FOUND MONUMENT.

D) Describe any material discrepancy between the location of the corner as restored or reestablished and the location of that corner as previously restored or reestablished by distance and direction. Show the discrepancy on the plan view drawing under (a), above. Show the distances between the corner as previously restored or reestablished and (1) the corner as restored or reestablished, and (2) to at least 4 of the witness monuments shown on the drawing in (a), above.

(E) Was the corner reestablished through lost corner proportionate methods? If so, show the method, including the directions and distances to other public land survey corners used as evidence or used for proportioning the corner location.

I, Donald Barnes, hereby certify that the corner points as identified by the corner code index were, in a field survey on, December 11, 1991, established, re-established, monumented, re-monumented, recovered or restored as expressed below and in conformance with the regulations and rules as required in the current manual of survey instructions of the United States Department of Interior, Bureau of Land Management.

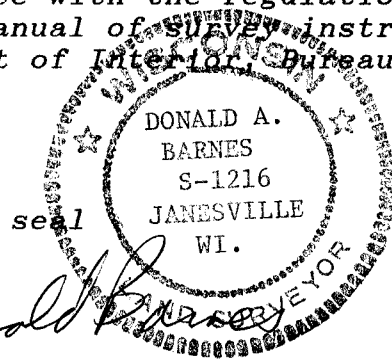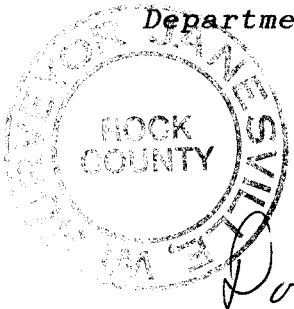

COUNTY SURVEYOR FILING DATA
Date of computer entry _____
Date microfilmed _____
Number of included sheets _____
CORNER CODE

AFFIX YOUR LAND SURVEYOR SEAL