

U.S. PUBLIC LAND SURVEY MONUMENT RECORD

For Public Land Survey Corners in the


T. 1 N., R. 10 E.

CORNER CODE INDEX

	1	2	3	4	5	6	7	8	9	10	11	12	13	14	15	16	17	18	19	20	21	22	23	24	25
A																									
B																									
C	6																								
D		5																							
E			4																						
F				3																					
G					2																				
H																									
I																									
J	7																								
K		8																							
L			9																						
M				10																					
N					11																				
O						12																			
P							13																		
Q								14																	
R									15																
S										16															
T											17														
U												18													
V													19												
W														20											
X															21										
Y																22									
Z																	23								
																		24							
																			25						
																				26					
																					27				
																						28			
																							29		
																								30	
																									31
																									32
																									33
																									34
																									35
																									36

PLACE MONUMENT SYMBOL (◆) AT PROPER LOCATION ON ABOVE INDEX

EXAMPLE

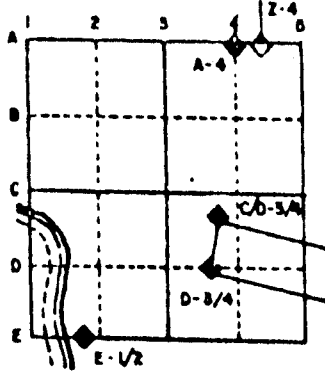

AVON TWP
ROCK COUNTY WI

IF AVAILABLE
STATE PLANE COORDINATES

North (Y) _____ Eleve. (Z) _____
 East (X) _____ Zone _____
 Hor. Datum _____ Vert. Datum _____

◆ CORNER MONUMENT

○ WITNESS MONUMENT

FD ALUM MONUMENT & TIES

MICROFILMED

BEARINGS ARE BASED ON:

(B) Describe any record evidence, monument evidence, occupational evidence, testimonial evidence or any other material evidence you considered, and whether the monument was found or placed.

- 1834 HARRISON. ORIGINAL GOVERNMENT SURVEYOR. QUARTER SECTION CORNER BUR OAK 10 S24W 45.5' & BUR OAK 8 N9E 79.9'.
- 1852 McVEAN VOL 1 PG 13 USED TO SUBDIVIDE SECTION 6. CALLS FOR 4703.16 TO THE N 1/4 CORNER OF SECTION 6.
- 1870 RUGER VOL 2 PG 26 FOUND LARGE LIMESTONE AT CORNER. ALSO FOUND SOUTH BEARING TREE AND STUMP OF NORTH BEARING TREE. USED SUBDIVIDE SECTION 7.
- 1969 BATTERMAN JR. VOL 4 PG 466 CALLS FOR CORNER BUT STATES NOTHING ABOUT IT. CALLS FOR 1334.45 TO THE 1/16TH CORNER THAT IS TO THE NORTH AND FROM THAT 1/16TH CORNER TO THE CENTER OF SECTION 6 THE DISTANCE IS 1337.31. ALSO CALLS FOR AN ANGLE OF 180-10-45 FROM THE CENTER OF SECTION 6 AT THE 1/16TH CORNER TO THE S 1/4 CORNER OF SECTION 6.
- 1970 LEE CSM VOL 1 PG 279 CALLS FOR 1334.45 TO A POINTED SANDSTONE AT THE 1/16TH CORNER THAT IS TO THE NORTH. CALLS FOR AN ANGLE OF 89-59-15 FROM THAT 1/16TH CORNER TO THE SE CORNER OF SECTION 6.
- 1973 BRIDWELL CSM VOL 3 PG 254 CALLS FOR A DISTANCE OF 2671.76 FROM THE S 1/4 CORNER OF SECTION 6 TO THE CENTER OF SECTION 6 AND AN ANGLE OF 90-50-00 FROM THE S 1/16TH CORNER OF THE NE 1/4 TO THE S 1/4 CORNER OF SECTION 6 AT THE CENTER OF SECTION 6.
- 1974 THOM PLAT OF SURVEY. CALLS FOR 2676.78 TO THE CENTER OF SECTION 6 AND 1332.72 TO THE S 1/16TH CORNER OF THE SE 1/4 OF SECTION 6. ALSO CALLS FOR AN ANGLE OF 90-03-25 FROM THE CENTER OF 6 TO THE SE CORNER OF SECTION 6 AT THE S 1/4 CORNER, 90-00-15 AT THE CENTER OF SECTION 6 FROM THE S 1/16TH CORNER OF THE NE 1/4 OF SECTION 6 TO THE S 1/4 CORNER OF SECTION 6.
- 1976 BARNES VOL 5 PG 131 FOUND 2" PIPE AND REFERENCED SAME.
- 1977 BARNES VOL 5 PG 330 FOUND 2" PIPE AND REPLACED WITH ALUMINUM MONUMENT.


FOUND ALUMINUM MONUMENT AND TIES.

C) Was the corner restored through acceptance of (1) an obliterated evidence location, or, (2) a found perpetuated location?

ACCEPTED FOUND MONUMENT.

D) Describe any material discrepancy between the location of the corner as restored or reestablished and the location of that corner as previously restored or reestablished by distance and direction. Show the discrepancy on the plan view drawing under (a), above. Show the distances between the corner as previously restored or reestablished and (1) the corner as restored or reestablished, and (2) to at least 4 of the witness monuments shown on the drawing in (a), above.

I, Donald Barnes, hereby certify that the corner points as identified by the corner code index were, in a field survey on, MAY 11, 1992, established, re-established, monumented, re-monumented, recovered or restored as expressed below and in conformance with the regulations and rules as required in the current manual of survey instructions of the United States Department of Interior, Bureau of Land Management.

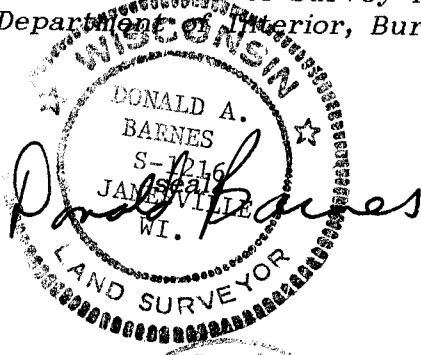

COUNTY SURVEYOR FILING DATA

Date of computer entry _____

Date microfilmed _____

Number of included sheets _____

CORNER CODE

AFFIX YOUR LAND SURVEYOR SEAL

