
## LAND U.S. PUBLIC SURVEY MONUMENT RECORD

For Public Land Survey Corners in:

WI ADMINISTRATIVE CODE A-E 7.08 REQUIREMENT

T. / N., R. / O E

CORNER CODE INDEX

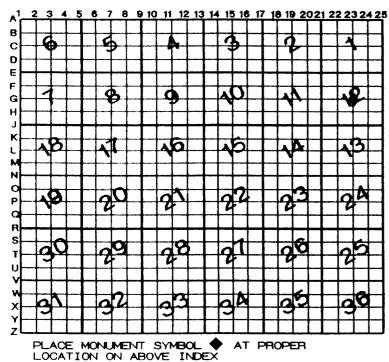

AVON **TWP** 

ROCK COUNTY WI

IF AVAILABLE ROCK COUNTY COORDINATES PERFERRED

North Elev. East Hor. Datum \_\_\_\_\_ Vert. Datum \_

LATITUDE \_\_ELLIPS. HT.

GPS (X) \_\_\_ TRAVERSE (X)

BASED ON THE FOLLOWING CONTROL:

**♦**CORNER MONUMENT

WITNESS MONUMENT

LONGITUTE

BEAFINGS ARE BASED

(a)

	SHEET OF	/
FIELD BOOKPAGE #	SHEET OF	
SHOW A PLAN VIEW DRAWING DEPICTING THE CORNER MONUMENT AN	ID SURROUNDING	
PHYSICAL FEATURES, INCLUDING THE EXCAVATION AREA AND DEPTH.		
PLANNING & ZONING COMMITTEE ADOPTED THE ABOVE FORM ON 12/2/1982		

- (B) Describe any record evidence, monument evidence, occupational evidence, testimonial evidence or any other material evidence you considered, and whether the monument was found or placed.

  SEARCHED FOR SUNNY'S PIPE AND FD NOTHING. POSITION IS IN OR NEAR SOUTH DITCH LINE. PROBABLE THE PIPE WAS DITCHED OUT.
- C) Was the corner restored through acceptance of (1) an obliterated evidence location, or, (2) a found perpetuated location?
- D) Describe any material discrepancy between the location of the corner as restored or reestablished and the location of that corner as previously restored or reestablished by distance and direction. Show the discrepancy on the plan view drawing under (a), above. Show the distances between the corner as previously restored or reestablished and (1) the corner as restored or reestablished, and (2) to at least 4 of the witness monuments shown on the drawing in (a), above.
- (E) Was the corner reestablished through lost corner proportionate methods? If so, show the method, including the directions and distances to other public land survey corners used as evidence or used for proportioning the corner location.
- I, **Donald Barnes**, hereby certify that the corner location as identified by the corner code index was determined by me under my direction and control and that this U.S. Public Land Survey Monument Record is correct and complete to the best of my knowledge and belief.

Segl

Emboss

SHEET 1 OF 1

6-17-03

CORNER CODE G-23

A.E. 7.08 REQUIREMENT