

U.S. PUBLIC LAND SURVEY MONUMENT RECORD

For Public Land Survey Corners in:

WI ADMINISTRATIVE CODE A-E 7.08 REQUIREMENT

T/ N., R. E

CORNER CODE INDEX

A	2	3	4	5	6	7	8	9	10	11	12	13	14	15	16	17	18	19	20	21	22	23	24	25
B																								
C	6																							
D																								
E																								
F	1	8																						
G																								
H																								
J																								
K	18	17	16	15	14	13																		
L																								
M																								
N																								
O	19	20	21	22	23	24																		
P																								
Q																								
R																								
S	30	29	28	27	26	25																		
T																								
U																								
V																								
W																								
X	31	32	33	34	35	36																		
Y																								
Z																								

AVON TWP

ROCK COUNTY WI

IF AVAILABLE
ROCK COUNTY COORDINATES PREFERRED

North 224,565.27 Elev. _____

East 429,997.50

Hor. Datum _____ Vert. Datum _____

LATITUDE _____ ELLIPS. HT. _____

LONGITUDE _____

GPS (X) _____ TRAVERSE (X) _____


BASED ON THE FOLLOWING CONTROL:

UPWARD TWP PROJECT

PLACE MONUMENT SYMBOL \blacklozenge AT PROPER LOCATION ON ABOVE INDEX

\blacklozenge CORNER MONUMENT \circ WITNESS MONUMENT

(a)

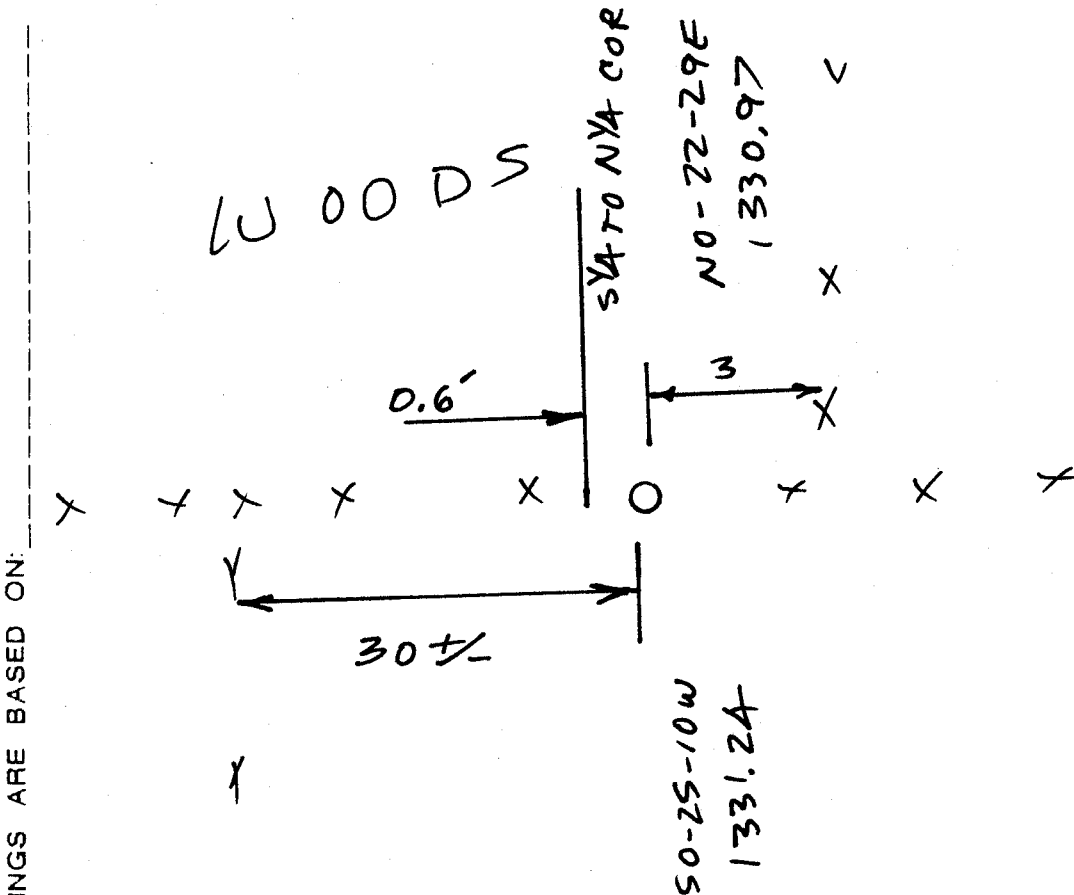

BEARINGS ARE BASED ON:

1871 RUGER - DROVE STAKE DEEP & PUT ON TOP OF IT L.S 8x7x6

7-02-03

FD L.S 7x6x9 & STAKE 1 1/2" DIA. x 8" LONG REPLACED WITH 3/4x24 RE/ROD/cap 6" DEEP

Donald Barney

OBSERVATION SHEET 42

FIELD BOOK _____ PAGE # _____ SHEET 1 OF 1

SHOW A PLAN VIEW DRAWING DEPICTING THE CORNER MONUMENT AND SURROUNDING PHYSICAL FEATURES, INCLUDING THE EXCAVATION AREA AND DEPTH.

PLANNING & ZONING COMMITTEE ADOPTED THE ABOVE FORM ON 12/2/1982

CORNER CODE H-23