## U.S. P


## PUBLIC LAND SURVEY MONUMENT RECORD

For Public Land Survey Corners in:

WI ADMINISTRATIVE CODE A-E 7.08 REQUIREMENT

T. \_/ N., R. \_/O\_E

CORNER CODE INDEX

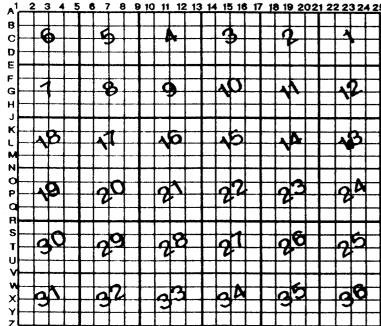

AJON TWP

IF AVAILABLE ROCK COUNTY COORDINATES PERFERRED

North \_\_\_\_\_ Elev. \_\_\_\_

East \_\_\_\_\_

Hor. Datum \_\_\_\_ Vert. Datum \_\_\_\_

LATITUDE \_\_\_\_ ELLIPS. HT.

GPS (X) \_\_\_ TRAVERSE (X) \_\_\_ BASED ON THE FOLLOWING CONTROL:

LONGITUTE

**♦**CORNER MONUMENT

PLACE MONUMENT SYMBOL 
LOCATION ON ABOVE INDEX

O WITNESS MONUMENT

BEAFINGS ARE BASED ON:

(a)

			•				
FIELD	воок	PAGE # _		•		SHEET	
SHOW	A PLAN V	IEW DRAWING DE	PICTING THE	CORNER	MONUMENT	AND SURRO	UNDING
PHYSIC	AL FEATU	RES, INCLUDING 1	HE EXCAVAT	TION AREA	AND DEPTI	H.	
PLANNIN	G & ZONING	COMMITTEE ADOPTI	D THE ABOVE	FORM ON	12/2/1982		

- (B) Describe any record evidence, monument evidence, occupational evidence, testimonial evidence or any other material evidence you considered, and whether the monument was found or placed. FENCE LINES ARE GONE. FARM LANE IS NEAR. DUG AND FD 0.6' DEEP A HH 11X13X9 & PIECES OF BARB WIRE. PLACED MAGNET IN HOLE & STONE ON TOP. STONE WAS IN HARMONY WITH RECORD DISTANCES BUT NOT COMPLETELY WITH REC SIZE. REC. SIZE IS 16X11X7
- C) Was the corner restored through acceptance of (1) an obliterated evidence location, or, (2) a found perpetuated location?
- D) Describe any material discrepancy between the location of the corner as restored or reestablished and the location of that corner as previously restored or reestablished by distance and direction. Show the discrepancy on the plan view drawing under (a), above. Show the distances between the corner as previously restored or reestablished and (1) the corner as restored or reestablished, and (2) to at least 4 of the witness monuments shown on the drawing in (a), above.

(E) Was the corner reestablished through lost corner proportionate methods? If so, show the method, including the directions and distances to other public land survey corners used as evidence or used for proportioning the corner location.

I, **Donald Barnes**, hereby certify that the corner location as identified by the corner code index was determined by me under my direction and control and that this U.S. Public Land Survey Monument Record is correct and complete to the best of my knowledge and belief.

Emboss

SHEET 1 OF 1

6-17-03

CORNER CODE L- 23

A.E. 7.08 REQUIREMENT