

U.S. PUBLIC LAND SURVEY MONUMENT RECORD

For Public Land Survey Corners in the $T. \stackrel{\checkmark}{=} N.$, $R. \stackrel{\checkmark}{=} E.$

CORNER CODE INDEX

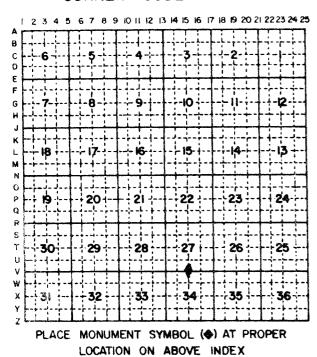

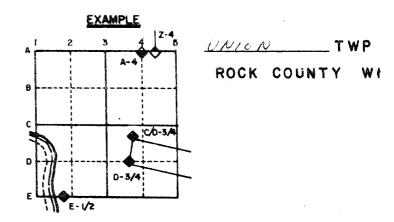

IF AVAILABLE

STATE PLANE COORDINATES

North (Y) 282525,27 Eleve. (Z)893

East (X) 218828700 Zone _

Hor. Datum Vert. Datum

(a.)

CORNER MONUMENT

O WITNESS MONUMENT

FOUND PK





FIELD BOOK ___ PAGE # ___

SHOW A PLAN VIEW DRAWING DEPICTING THE CORNER MONUMENT AND SURROUNDING PHYSICAL FEATURES, INCLUDING THE EXCAVATION AREA AND DEPTH. THE CORNER MONUMENT SHALL HAVE THE FOLLOWING CHARACTERISTICS: I) HAVE AT LEAST TWO PREDETERMINED BREAK-OFF POINTS. 2) IF BROKEN, LEAVE A PERMANENTLY MAGNETIZED REMNANT AT THE ORIGINAL POINT. 3) MUST BE EXTENDABLE. 4) THE CAP IS INSCRIBED: ROCK COUNTY SURVEY MONUMENT - PENALTY FOR DISTURBING MARKER. 5) OR AN EXISTING CUT LIMESTONE. AN IRON PIPE I' X X 4'O" (MINIMUM) MAY BE USED IN AREAS WHERE GROUND WATER IS WITHIN ONE FOOT OF THE SURFACE. IF THE CORNER IS OCCUPIED BY AN IMPROVEMENT (MANHOLE, BURIED CABLE, ETC.) ANY DURABLE, DISTINCT MONUMENT MAY BE USED. CORNERS SHALL BE REFERENCED WITH AT LEAST 4 DURABLE WITNESS MONUMENTS. WITNESS MONUMENTS SHALL BE MADE OF CONCRETE, NATURAL STONE, IRON OR OTHER EQUALLY DURABLE MATERIAL, EXCEPT WOOD. DESCRIBE THE CORNER AND THE WITNESS MONUMENTS.

V 15

(6.)	Describe any record evidence, monument evidence, occupational evidence, testimonial evidence or
	any other material evidence you considered, and whether the monument was found or placed.

FU PK as REFERENCED IN COUNTY SURVEYOR'S RECORDS.


(c.) Was the corner restored through acceptance of (1) an obliterated evidence location, or, (2) a found perpetuated location?

Accepted FOUND PERPETULTED LOCATION

(d) Describe any material discrepancy between the location of the corner as restored or reestablished and the location of that corner as previously restored or reestablished by distance and direction. Show the discrepancy on the plan view drawing under (a), above. Show the distances between the corner as previously restored or reestablished and (1) the corner as restored or reestablished, and (2) to at least 4 of the witness monuments shown on the drawing in (a), above.

(e.) Was the corner reestablished through lost corner proportionate methods? If so, show the method, including the directions and distances to other public land survey corners used as evidence or used for proportioning in determining the corner location.

as identified by the corner code index were, in a field survey on Africal 161957, established, re-established, monumented, re-monumented, recovered or restored as expressed below and in conformance with the regulations and rules as required in the current manual of survey instructions of the United States Department of Interior, Bureau of Land Management.

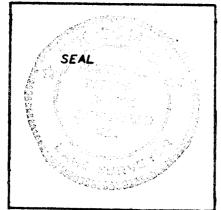

COUNTY SURVEYOR FILING DA	TA		
Date of Computer Entry			
Date Received			
Date Microfilmed Apail	301985		
Treasurer's Receipt No.			
Number of Included Sheets			
	CODNED		

CORNER AFFIX YOUR LAND SURVEYOR SEAL CODE V/5