

Paper weight-110# (minimum) Black nonfading ink required

# U.S. PUBLIC LAND SURVEY MONUMENT RECORD

For Public Land Survey Corners In:  
**T. 4 N. R. 10 E. 4th P.M.**  
 CORNER CODE INDEX

WI ADMINISTRATIVE CODE A-E 7.08 REQUIREMENT  
 REV 10/23/2004 USMONREC.DWG

**UNION** TWP  
**ROCK COUNTY WI**

IF AVAILABLE  
 ROCK COUNTY COORDINATES PREFERRED

A	1	2	3	4	5	6	7	8	9	10	11	12	13	14	15	16	17	18	19	20	21	22	23	24	25	A
B		6				5				4				3				2				1				B
C																										C
D																										D
E																										E
F																										F
G																										G
H																										H
J																										J
K																										K
L																										L
M																										M
N																										N
O																										O
P																										P
Q																										Q
R																										R
S																										S
T																										T
U																										U
V																										V
W																										W
X																										X
Y																										Y
Z																										Z

North \_\_\_\_\_ Elev. \_\_\_\_\_

East \_\_\_\_\_

Hor. Datum \_\_\_\_\_ Vert. Datum \_\_\_\_\_

LATITUDE \_\_\_\_\_ ELLIPS. HT. \_\_\_\_\_

LONGITUDE \_\_\_\_\_

NAD83(91) \_\_\_\_\_ NETWORK ADJ. YR 2010 \_\_\_\_\_

GPS (X) \_\_\_\_\_ TRAVERSE (X) X

BASED ON THE FOLLOWING CONTROL:

PLACE MONUMENT SYMBOL **◆** AT PROPER LOCATION ON ABOVE INDEX

**◆** CORNER MONUMENT      **○** WITNESS MONUMENT

BEARINGS ARE BASED ON: ROCK COUNTY PROJECTION

FIELD BOOK \_\_\_\_\_ PAGE # \_\_\_\_\_  
 OR OBSERVATION SHEET \_\_\_\_\_

SHEET 1 OF 3

SHOW A PLAN VIEW DRAWING DEPICTING THE CORNER MONUMENT AND SURROUNDING PHYSICAL FEATURES, INCLUDING THE EXCAVATION AREA AND DEPTH.

PLANNING & ZONING COMMITTEE ADOPTED THIS FORM ON 12/2/1982

CORNER CODE J B-1 (S)

UN541 NWCORSEC18

(B) Describe any record evidence, monument evidence, occupational evidence, testimonial evidence or any other material evidence you considered, and whether the monument was found or placed.

1833 BRINK PG 44 EAST BOUNDARY T4N R9E NORTH ON EAST SIDE OF SECTION 24

2640.00 SET 1/4 SECTION POST MADE A MOUND

5280.00 SET POST FOR CORNER TO SECTIONS 13 & 24 LAND SAME NEEDLE ATTRACTED 1-15' WEST

1833 BRINK PG 44 EAST BOUNDARY T4N R9E NORTH ON EAST SIDE OF SECTION 13

2640.00 SET 1/4 SECTION POST IN PRAIRIE MADE A MOUND

2937.00 ROAD FROM MINERAL POINT TO KOSCONONG E&W

4620.00 LEAVE PRAIRIE

5280.00 SET POST FOR CORNER TO SECTIONS 12 & 13 BUR OAK 24 S17E 80.52'; BUR OAK 12 N43E 89.76' LAND ROLLING RICH DRY PRAIRIE.

NORTH OF PRAIRIE THINLY TIMBERED WITH BURR OAK NEEDLE ATTRACTED 1-40 WEST

1833 HARRISON T3N R9E 4TH MER. [SIDE PAGE IS T4N R9E 4TH MER. PROBABLY 3N IS A 4N] EAST ON RANDOM BET SECS 13 & 24

2640.00 TEMPY 1/4 SEC COR

5243.04 INT. E BDY 204.6' N OF P LAND ROLLING 1S RATE PRAIRIE GROWTH GRASS & WEEDS WEST CORD WEST BET SECS 13 & 24

2621.52 QUARTER SEC COR. MARKED POST & RAISED MOUND

5243.04 INT. SEC. COR.

1833 HARRISON T4N T10E 4TH MER WEST BETWEEN SECS 7 & 18

1114.08 BURR O 12

1980.0 LEAVE TIMBER & ENTER PRAIRIE

2640.00 QUARTER SEC COR SET POST & RAISED MOUND

5396.16 INT. WEST BDY SET COR TO SECS 7 & 18 SET POST & RAISED MOUND LAND 1ST 1980' LEVEL 2ND RATE WITH BURR O TIMBER RUN LEVEL 1ST RATE PRAIRIE

1861 RUGER VOL 1 PG 166 SET LIMESTONE 15X6X5 & SET LIMESTONE ON N & S SIDES. 2756.16 TO N 1/4 COR SEC 18, 2631.75 TO W 1/4 COR SEC 18,

1870 RUGER AUG REMON-90 NORTH ON WEST LINE OF SW 1/4 SEC 18 ON A VAR 5-45; AT

2636.04 INTERSECTED QUARTER LINE AT QUARTER CORNER. FOUND LIME STONE AT CORNER SET BY SELF IN A PREVIOUS SURVEY.

NORTH ON WEST LINE OF NW 1/4 SEC 18 ON A VAR 5-30; AT

2637.03 INTERSECTED NORTH BOUNDARY LINE AT CORNER.

1870 RUGER AUG REMON-89 WEST ON NORTH LINE OF NE QUARTER SEC 18 ON A VAR 7-05; OFFSET SOUTH 21.12' AT

2645.28 INTERSECTED QUARTER LINE AT QUARTER CORNER. FOUND STAKE AT CORNER SET BY SELF IN A PREVIOUS SURVEY. COR VAR 7-32 WEST ON NORTH LINE OF NW 1/4 SEC 18 ON A VAR 7-26 AT

2756.16 INTERSECTED WEST BOUNDARY LINE AT CORNER. FOUND LIME STONE AT CORNER SET BY SELF IN A PREVIOUS SURVEY.

1870 RUGER VOL 2 PG 50 & #5089 STONE MON SET BY SELF. VAR 7-11 2754.35 TO STONE MON @ S 1/4 COR SEC 7

SEAL

Emboss

*Daniel Barnes*  
Aug 25, 2011

SHEET 1 OF 3

CORNER CODE ~~R~~-1 (E)

J

UN541 NWCORSEC18

1870 RUGER AUG REMON-122 NORTH ON WEST LINE OF SW  
1/4 SEC 7 ON A VAR 5-05; AT

2640.00 INTERSECTED QUARTER LINE AT QUARTER  
CORNER. FOUND STONE AT CORNER AND OLD  
STAKE UNDER STONE.

NORTH ON WEST LINE OF NW 1/4 SEC 7 ON A  
VAR 4-55; AT

2630.76 INTERSECTED NORTH BOUNDARY LINE AT  
CORNER FOUND STONE AT CORNER AND OLD  
STAKE UNDER STONE. ALSO FOUND STUMPS OF  
BEARING TREES.

1976 TALARCZYK #5145 SE COR SEC 13 T4N R9E CORNER SET  
BY PROPORTIONATE MEASUREMENTS & EXISTING PHYSICAL  
EVIDENCE. SHOWS @ INT. OF CENTER OF PVMT. YARWOOD  
RD & GTH T. CAST ALUM. MON.

1977 BARNES VOL 5 PG 369 2646.63 TO W 1/4 COR SEC 7,  
2643.66 TO W 1/4 COR SEC 18, SOUTHERLY 880.19 TO SE  
COR SEC 13. ANGLE OF 180-00-00 @ SW COR SEC 7 FROM E  
1/4 COR SEC 13 TO SE COR SEC 13.

1978 BARNES VOL 5 PG 368 DUG 3 HOLES & FD NOTHING. SET  
AT SINGLE PROPORTIONATE DISTANCE ON LINE WITH THE  
SE COR SEC 13 & E 1/4 COR SEC 13. 4/5/1978 SET ALUM.  
MON. REFERENCED SAME. 1' EAST OF PVMT CENTER.

1979 BARNES VOL 5 PG 528 STATES NOTHING ABOUT MON.  
SHOWS RECORD DISTANCES.

1979 BARNES VOL 5 PG 530 N88-03-51E (TRUE NORTH) 5412.83  
TO NE COR SEC 18.

1982 BARNES VOL 6 PG 273 FD ALUM. MON 2646.63 TO W 1/4  
COR SEC 7

1992 COMBS CSM VOL 16 PG 164 ALUM 2647.08 TO POLY @ W  
1/4 COR SEC 7

1996 BOWEDEN K-1 SE COR SEC 13 T4N R9E MAG. READING CL  
GTH T !@ YARWOOD RD. NOTE: BARNES - THE ABOVE  
LATITUDE & LONGITUDE WAS ACQUIRED FOR A GREEN  
COUNTY LAND INFORMATION PROJECT BY BOWEDEN  
SURVEYING COMPANY. GPS EQUIPMENT WAS USED. I  
COMPUTED THE COUNTY COORDINATES & THE FOLLOWING  
DATA LATITUDE 7 LONGITUDE. 316,896.946; 400,310.482  
NAVD 29 961.66

FD PK. USED OLD FIELD DATA & TIE DISTANCE TO THE REFERENCE  
PIPES TO COMPUTE POSITION OF ALUM. MON. THERE IS NO  
PREVIOUS RECORD FOR THE PK.

C) Was the corner restored through acceptance of (1) an obliterated evidence location, or, (2) a found  
perpetuated location?

ACCEPTED FD ALUM. MON. DID NOT ACCEPT FD PK. THE 1978 VOL  
5 PG 368 MAP SHOWS THE LOCATION OF THE EXCAVATION OF  
THREE HOLES.

D) Describe any material discrepancy between the location of the corner as restored or reestablished  
and the location of that corner as previously restored or reestablished by distance and direction. Show  
the discrepancy on the plan view drawing under (a), above. Show the distances between the corner as  
previously restored or reestablished and (1) the corner as restored or reestablished, and (2) to at least 4  
of the witness monuments shown on the drawing in (a), above.

SEE DRAWING. ALUM MONUMENT IS S71-36E 0.16 FROM FD PK.

I, **Donald Barnes**, hereby certify that the corner location as identified by the corner code index  
was determined by me under my direction and control and that this U.S. Public Land Survey  
Monument Record is correct and complete to the best of my knowledge and belief.

  
Embloss

SHEET 2 OF 3

Aug 23, 2011

CORNER CODE -1(1)

A.E. 7.08 REQUIREMENT

REC ALUM  
COMPUTED POSITION  
FROM REC DATA

1978 BARNES VOL 5-368  
OBSERVATION SHEET #141

VOL 5 PG 368 SHOWS  
LIMITS OF OLD  
EXCAVATION

1/2X24 REROD  
2' EAST OF  
EAST PVMT EDGE

FD PIPE  
ELEV 977.1X

ELEV 978.4X  
FD BENT  
PIPE

S83-34-10E 53.61

S0-28-50W 3466.47

S00-04-26W 3433.11

1.5'

FD PK

S36-32-42E 47.99  
N36-26-01W 48.06  
REC 47.93

FD PK

N37-05-37E 39.87  
N37-18-25E 40.87  
REC 40.93

7.0'

REC 56.35

FD PK

0.15

S71-36E 0.16

NW COR


S0-39-44W 94.56  
REC 94.64

ELEV 979.6X

N27-58-18E 63.35  
N27-49-37E 63.32  
REC 63.36

N31-32-49E 103.91

REC 44.11

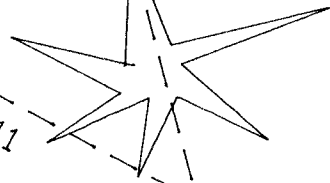

FD PIPE  
PHOTO ELEV 978

NW COR  
SEC 18  
T4N R10E  
UNION TWP

SHEET 3 OF 3

BARN

FD PIPE  
ELEV 979.8X

*Dusold*  
EMBOSSSED  
SEAL

*Barnes*

*Aug 23, 2011*

STH 104

*J. Barnes* - 1 ( )