Paper weight-110# (minimum)

Black nonfading ink required


## LAND SURVEY U.S. **PUBLIC** MONUMENT RECORD

For Public Land Survey Corners In:

WI ADMINISTRATIVE CODE A-E 7.08 REQUIREMENT

T. 4 N. R. 10 E. 4th P.M.

CORNER CODE INDEX

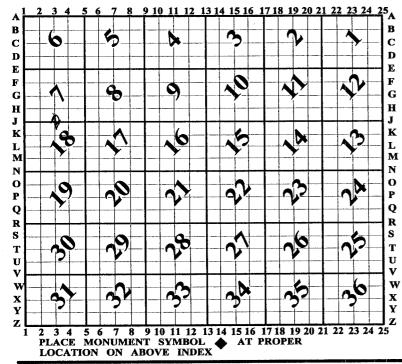

## **UNION TWP ROCK COUNTY WI**

IF AVAILABLE ROCK COUNTY COORDINATES PERFERRED

North	Elev
East	and the second second
Hor. Datum	Vert. Datum
LATITUDE	ELLIPS. HT.
LONGITUDE _	
NAD83(91)	NETWORK ADJ. YR 2010
GPS (X)	TRAVERSE (X) X
BASED ON THE	FOLLOWING CONTROL:

**◆ CORNER MONUMENT** 

WITNESS MONUMENT

(a) ROCK COUNTY PROJECTION BEARINGS ARE BASED ON:\_

		,	
FIELD BOOK PAGE #			2
OR OBSERVATION SHEET	SHEET	<b>OF</b>	
SHOW A PLAN VIEW DRAWING DEPICTING THE CORNER MONUMENT AND	D SURROUN	NDING	
PHYSICAL FEATURES, INCLUDING THE EXCAVATION AREA AND DEPTH.			
PLANNING & ZONING COMMITTEE ADOPTED THIS FORM ON 12/2/1982			
	CODE		

## UN542 N1/4CORSEC18

- (B) Describe any record evidence, monument evidence, occupational evidence, testimonial evidence or any other material evidence you considered, and whether the monument was found or placed.
- 1833 HARRISON T4N T10E 4TH MER WEST BETWEEN SECS 7 & 18 1114.08 BURR 0 12
  - 1980.0 LEAVE TIMBER & ENTER PRAIRIE
  - 2640.00 QUARTER SEC COR SET POST & RAISED MOUND
  - 5396.16 INT. WEST BDY SET COR TO SECS 7 & 18 SET POST & RAISED MOUND LAND 1ST 1980 LEVEL 2ND RATE WITH BURR O TIMBER RUN LEVEL 1ST RATE PRAIRIE
- 1861 RUGER VOL 1 PG 166 SET STAKE & SURROUNDED IT BY 3
  HARD HEADS. 2645.28 TO SURROUNDED POST BY 4 HH. @
  NE COR SEC 18, 2756.16 TO SET LIMESTONE 15X6X5 @ NW
  COR SEC 18. USED TO SUBDIVIDE SEC 18
- 1863 LOCKE VOL 1 PG 193 & 5090 FD 3 HARD HEADS IN A
  HOLE, WITH OUT DOUBT SET BY RUGER IN SEC 18.
  2650.56 TO CORNER SET BY RUGER IN SEC 18 @ SE COR
  SEC 7. USED TO SUBDIVIDE SECTION 7. 2630.10 TO
  CENTER OF SEC 7 & 5260.20 TO N 1/4 COR SEC 7. CENTER
  OF SEC 7 IS EQUI DISTANCE BETWEEN N & S 1/4 CORNERS
  OF SEC 7
- 1870 RUGER VOL 2 PG 50 & #5089 [DEC 20-23] STONE MON. SET BY SELF. USED TO SUBDIVIDE SEC 7, VAR 7-11 2754.35 TO STONE MON @ SW COR SEC 7.
- 1870 RUGER AUG REMON-89 WEST ON NORTH LINE OF NE QUARTER SEC 18 ON A VAR 7-05; OFFSET SOUTH 21.12'AT
  - 2645.28 INTERSECTED QUARTER LINE AT QUARTER CORNER. FOUND STAKE AT CORNER SET BY SELF IN A PREVIOUS SURVEY. COR VAR 7-32 WEST ON NORTH LINE OF NW 1/4 SEC 18 ON A VAR 7-26 AT
  - 2756.16 INTERSECTED WEST BOUNDARY LINE AT CORNER. FOUND LIME STONE AT CORNER SET BY SELF IN A PREVIOUS SURVEY.
- 1979 BARNES VOL 5 PG 528 SHOWS RECORD DISTANCES.
- 1979 BARNES VOL 5 PG 530 DUG 3' DEEP & FD NOTHING. SET A
  POINT N88-03-51E (TRUE NORTH) 2650.86 TO NE COR SEC
  18, S88-03-51W (TRUE NORTH) 2761.97 TO NW COR SEC 18.
  POINT IS 6' SOUTH OF 3" ANGLE IRON SET IN CONCRETE. & 5'
  EAST OF N/S FENCE. SHOWS HOLE DIM.
  NW COR TO NE COR SEC 18 IS N88-03-51E (TRUE NORTH)
  5412.83
- 1982 BARNES VOL 6 PG 273 SHOWS REC DISTANCES.
- 1982 COMBS CSM VOL 11-26 USED CENTER OF SEC 7.

DUG WITH BACKHOE & FD CUT LIMESTONE. BROKE TOP 18" OFF & TOOK TO OFFICE. PLACED 2 MAGNETS ON ALL SIDES OF L.S. BASE. SET CARSONITE 1.5' EAST OF L.S.

C) Was the corner restored through acceptance of (1) an obliterated evidence location, or, (2) a found perpetuated location?

## ACCEPTED FD LS.

- D) Describe any material discrepancy between the location of the corner as restored or reestablished and the location of that corner as previously restored or reestablished by distance and direction. Show the discrepancy on the plan view drawing under (a), above. Show the distances between the corner as previously restored or reestablished and (1) the corner as restored or reestablished, and (2) to at least 4 of the witness monuments shown on the drawing in (a), above. NDNE
- (E) Was the corner reestablished through lost corner proportionate methods? If so, show the method, including the directions and distances to other public land survey corners used as evidence or used for proportioning the corner location.  $N\Box$
- I, **Donald Barnes**, hereby certify that the corner location as identified by the corner code index was determined by me under my direction and control and that this U.S. Public Land Survey Monument Record is correct and complete to the best of my knowledge and belief.

SHEET 1 OF 2

CORNER CODE J-3

A.E. 7.08 REQUIREMENT

Bunes Der 28, 2011

