Paper weight-110# (minimum)

Black nonfading ink required


## Black nonfa **SURVEY** U.S. **PUBLIC** MONUMENT RECORD

For Public Land Survey Corners In:

WI ADMINISTRATIVE CODE A-E 7.08 REQUIREMENT

T.  $\frac{4}{N}$  N. R.  $\frac{10}{E}$  4th P.M.

CORNER CODE INDEX

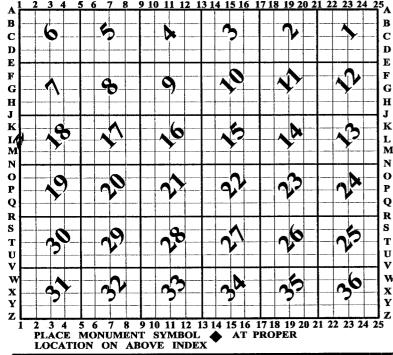

**UNION TWP ROCK COUNTY WI** 

IF AVAILABLE ROCK COUNTY COORDINATES PERFERRED

North	Elev
East	
Hor. Datum	Vert. Datum
LATITUDE _	ELLIPS. HT.
LONGITUDE _	
NAD83(91)	NETWORK ADJ. YR 2010
GPS (X)	TRAVERSE (X) X
BASED ON THE	FOLLOWING CONTROL:

**◆ CORNER MONUMENT** 

O WITNESS MONUMENT

(a) ROCK COUNTY PROJECTION BEARINGS ARE BASED ON:\_

FIELD BOOK PAGE #		4	っ
OR OBSERVATION SHEET	SHEET	OF	
SHOW A PLAN VIEW DRAWING DEPICTING THE CORNER MONUMENT AND	D SURROUND	)ING	
PHYSICAL FEATURES, INCLUDING THE EXCAVATION AREA AND DEPTH.			
PLANNING & ZONING COMMITTEE ADOPTED THIS FORM ON 12/2/1982		1 /	
CORNER	CODE	1-1	

## UN554 W1/4CORSEC18

(B) Describe any record evidence, monument evidence, occupational evidence, testimonial evidence or any other material evidence you considered, and whether the monument was found or placed.

1833 BRINK PG 43 EAST BOUNDARY TAN R9E NORTH ON EAST SIDE OF SECTION 24

2640.00 SET 1/4 SECTION POST MADE A MOUND 5280.00 SET POST FOR CORNER TO SECTIONS 13 & 24 LAND SAME NEEDLE ATTRACTED 1-15 WEST

- 1861 RUGER VOL 1 PG 166 SET LIMESTONE 10X7X8 1/2 2631.75 TO SW & NW COR SEC 18. VAR 7-49 2803.68 TO CENTER OF SEC 18, & 5443.68 TO E 1/4 COR SEC 18
- 1870 RUGER AUG REMON-90 NORTH ON WEST LINE OF SW 1/4
  SEC 18 ON A VAR 5-45; AT
  - 2636.04 INTERSECTED QUARTER LINE AT QUARTER CORNER. FOUND LIME STONE AT CORNER SET BY SELF IN A PREVIOUS SURVEY.

NORTH ON WEST LINE OF NW 1/4 SEC 18 ON A VAR 5-30; AT

2637.03 INTERSECTED NORTH BOUNDARY LINE AT CORNER.

- 1976 TALARCZYK #5145 E 1/4 COR SEC 24 T4N R9E CORNER SET BY PROPORTIONATE MEASUREMENT & EXISTING PHYSICAL EVIDENCE. SHOWS ON LINE WITH E/W FENCE TO THE WEST & 30.07 FROM REROD NEAR FENCE INT. CAST ALUM. MON.
- 1977 BARNES VOL 5 PG 367 FD CUT LIMESTONE 30" DEEP. @ PVMT CENTER. REF. SAME. 1978 SET ALUM MON.
- 1977 BARNES VOL 5 PG 369 2643.66 TO NW COR SEC 18.
  NORTHERLY 1763.47 TO SE COR SEC 13 T4 R9E
- 1979 BARNES VOL 5 PG 528 RECORD DISTANCES

FD SE REFERENCE MON. USED OLD OBSERVATIONS AND SE REFERENCE. METAL LOCATOR FOUND ALUM. ROAD IS DANGEROUS FOR UNCOVERING MON.

C) Was the corner restored through acceptance of (1) an obliterated evidence location, or, (2) a found perpetuated location?

ACCEPTED RECORD ALUM. MON., WHICH PERPETUATES CUTLIMESTONE.

- D) Describe any material discrepancy between the location of the corner as restored or reestablished and the location of that corner as previously restored or reestablished by distance and direction. Show the discrepancy on the plan view drawing under (a), above. Show the distances between the corner as previously restored or reestablished and (1) the corner as restored or reestablished, and (2) to at least 4 of the witness monuments shown on the drawing in (a), above.
- (E) Was the corner reestablished through lost corner proportionate methods? If so, show the method, including the directions and distances to other public land survey corners used as evidence or used for proportioning the corner location.

I, **Donald Barnes**, hereby certify that the corner location as identified by the corner code index was determined by me under my direction and control and that this U.S. Public Land Survey Monument Record is correct and complete to the best of my knowledge and belief.

SHEET 1 OF 2

CORNER CODE L-1

COR Hy 23, 26// A.E. 7.08 REQUIREMENT

