

(B) Describe any record evidence, monument evidence, occupational evidence, testimonial evidence or any other material evidence you considered, and whether the monument was found or placed.

1833 MULLETT ORIGINAL GOVERNMENT SURVEYOR. NORTH ON EAST SIDE SECTION 25. SET POST CORNER SECTION 24 & 25 AND RAISED A MOUND.

1834 HARRISON ORIGINAL GOVERNMENT SURVEYOR. WEST BETWEEN 19 & 30. W. BDG IN MARSH 62 N OF P. MARKED SAME FOR COR TO SEC 19 & 30. LAND ALL MARSH.

1868 LOCKE PLYMOUTH TOWNSHIP REMONUMENTATION FIELD NOTES. EAST BETWEEN SECTION 24 AND 25. INTERSECTED EAST BOUNDARY 15.18' NORTH OF CORNER. FOUND MOUND IN LINE WITH FENCES RUNNING SOUTH AND EAST. PLACED CUT LIMESTONE. SHOWS A DISTANCE OF 2671.02' TO SOUTH 1/4 OF SECTION 24 PLYMOUTH TOWNSHIP, 2647.92 TO E 1/4 COR SEC 24, 2659.80' TO E 1/4 CORNER OF SECTION 25 PLYMOUTH TOWNSHIP.

1892 BLEEDORN VOL 2 PG 466 FOUND MONUMENT AT SE COR SEC 24 PLYMOUTH. SHOWS A DISTANCE OF 2663.10' TO S 1/4 CORNER AND 2645.28 TO E 1/4 CORNERS OF SECTION 24 PLYMOUTH TOWNSHIP.

1961 BATTERMAN VOL 4 PG 16 RESET 1" PIPE FROM OLD TIES AND REFERENCED SAME. SHOWS WPL COORDINATES OF N/S 224908.56; E/W 2,234,298.70

1972 LEE VOL 4 PG 577 SHOWS DISTANCE FROM NW TO N 1/4 CORNERS OF SECTION 30 AS 2689.88 AND 2658.64 FROM NW TO W 1/4 CORNERS OF SECTION 30.

1981 BARNES VOL 6 PG 144 SHOWS WPL BEARING AND DISTANCE OF S89-55-15E 2690.37 FROM NW TO N 1/4 CORNERS OF SECTION 30 AND N1-02-37W 2658.70 FROM NW TO W 1/4 CORNERS OF SECTION 30.

1982 BARNES VOL 6 PG 282 SHOWS A DISTANCE FROM NW CORNER OF SECTION 30 TO S 1/4 CORNER OF SECTION 24 PLYMOUTH TOWNSHIP AS 2666.42.


FOUND CAST IRON MONUMENT

C) Was the corner restored through acceptance of (1) an obliterated evidence location, or, (2) a found perpetuated location?

ACCEPTED FOUND PERPETUATED MONUMENT.

D) Describe any material discrepancy between the location of the corner as restored or reestablished and the location of that corner as previously restored or reestablished by distance and direction. Show the discrepancy on the plan view drawing under (a), above. Show the distances between the corner as previously restored or reestablished and (1) the corner as restored or reestablished, and (2) to at least 4 of the witness monuments shown on the drawing in (a), above.

I, Donald Barnes, hereby certify that the corner points as identified by the corner code index were, in a field survey on, JUNE 21, 1989, established, re-established, monumented, re-monumented, recovered or restored as expressed below and in conformance with the regulations and rules as required in the current manual of survey instructions of the United States Department of Interior, Bureau of Land Management.

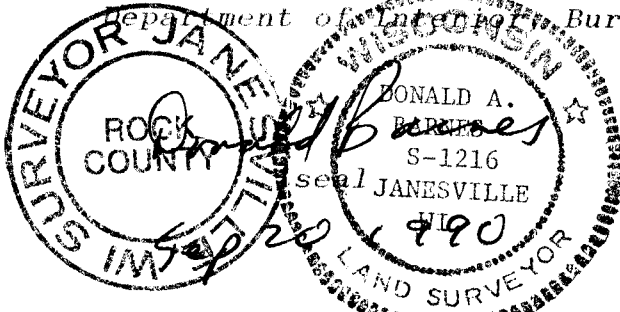

COUNTY SURVEYOR FILING DATA
Date of computer entry _____
Date microfilmed _____

Number of included sheets _____

R1
CORNER CODE