

(B) Describe any record evidence, monument evidence, occupational evidence, testimonial evidence or any other material evidence you considered, and whether the monument was found or placed.

- 1855 CHURCH VOL 1 PG 31 SHOWS 2644.62 TO CENTER OF SEC 30.
- 1964 BATTERMAN VOL 4 PG 200 FOUND HARRISON MONUMENT. SHOWS WPL COORDINATES N/S 224,904.84 E/W 2,236,989.07
- 1972 LEE VOL 4 PG 577 SET CAST IRON MONUMENT. SHOWS S88-32-44E 2689.88 TO NW COR SEC 30, S88-32-44E 2646.88 TO NE COR SEC 30, AND N0-05-21E 5292.48 TO S 1/4 COR SEC 30
- 1981 BARNES VOL 6 PG 144 SHOWS RECORD DISTANCES.

FOUND CAST IRON MONUMENT. PLACED CARSONITE POST NEXT TO MONUMENT.


(C) Was the corner restored through acceptance of (1) an obliterated evidence location, or, (2) a found perpetuated location?

ACCEPTED FOUND MONUMENT.

D) Describe any material discrepancy between the location of the corner as restored or reestablished and the location of that corner as previously restored or reestablished by distance and direction. Show the discrepancy on the plan view drawing under (a), above. Show the distances between the corner as previously restored or reestablished and (1) the corner as restored or reestablished, and (2) to at least 4 of the witness monuments shown on the drawing in (a), above.

(E) Was the corner reestablished through lost corner proportionate methods? If so, show the method, including the directions and distances to other public land survey corners used as evidence or used for proportioning the corner location.

I, Donald Barnes, hereby certify that the corner points as identified by the corner code index were, in a field survey on, July 20, 1990, established, re-established, monumented, re-monumented, recovered or restored as expressed below and in conformance with the regulations and rules as required in the current manual of survey instructions of the United States Department of Interior, Bureau of Land Management.

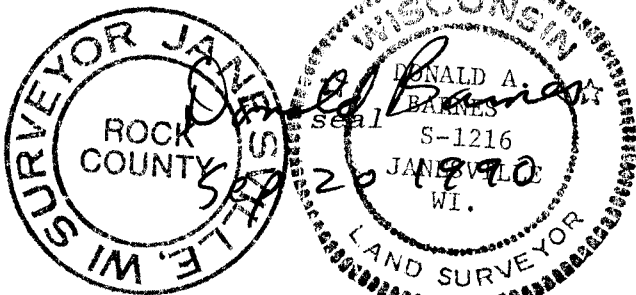

AFFIX YOUR LAND SURVEYOR SEAL

COUNTY SURVEYOR FILING DATA

Date of computer entry _____

Date microfilmed _____

Number of included sheets _____

CORNER CODE

R 3