Paper weight-110# (minimum)

Black nonfading ink required LAND SUI U.S. PUBLIC SURVEY MONUMENT RECORD


For Public Land Survey Corners In:

WI ADMINISTRATIVE CODE A-E 7.08 REQUIREMENT

USMONREC.DWG REV 10/23/2004

T. $\underline{4}$ N. R. $\underline{10}$ E. 4th P.M.

CORNER CODE INDEX

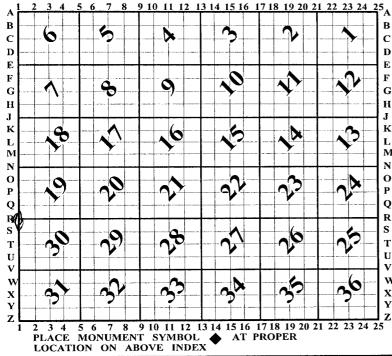

UNION ROCK COUNTY WI

IF AVAILABLE ROCK COUNTY COORDINATES PERFERRED

North	Elev
East	····
Hor. Datum	Vert. Datum
LATITUDE	ELLIPS. HT.
LONGITUDE _	
NAD83(91)	NETWORK ADJ. YR 2010
GPS (X)	TRAVERSE (X) X
BASED ON THE	FOLLOWING CONTROL:

◆ CORNER MONUMENT

WITNESS MONUMENT

(a) ROCK COUNTY PROJECTION BEARINGS ARE BASED ON:

FIELD BOOK PAGE #	SHEET	/	ヌ	-9
OR OBSERVATION SHEET			OF 🖳	# e.se ^t
SHOW A PLAN VIEW DRAWING DEPICTING THE CORNER MONUMENT AND	SURROUN	DING		
PHYSICAL FEATURES, INCLUDING THE EXCAVATION AREA AND DEPTH.				
PLANNING & ZONING COMMITTEE ADOPTED THIS FORM ON 12/2/1982		47		

UN581 NWCORSEC30

(B) Describe any record evidence, monument evidence, occupational evidence, testimonial evidence or any other material evidence you considered, and whether the monument was found or placed.

- 1833 BRINK PG 42 EAST BOUNDARY T4N R9E VAR 8-10E

 NORTH ON EAST SIDE OF SECTION 36
 - 2640.00 SET 1/4 SECTION POST IN PRAIRIE MADE MOUND OF EARTH & SODS
 - 5280.00 SET POST FOR CORNER TO SECTIONS 25 & 36
 IN PRAIRIE MADE A MOUND LAND ROLLING DRY
 PRAIRIE SECOND RATE COVERED WITH A SHORT
 GRASS
- 1833 BRINK PG 43 EAST BOUNDARY TAN R9E NORTH ON EAST SIDE OF SECTION 25
 - 2640.00 SET 1/4 SECTION POST IN PRAIRIE AND MADE MOUND
 - 5280.00 SET POST FOR CORNER TO SECTIONS 24 & 25
 IN PRAIRIE MADE A MOUND LAND @C SAME AS
 LAST MILE. NOTE NEEDLE ATTRACTED 30' WEST.
- 1833 HARRISON T4N R1OE 4TH MER WEST BETWEEN SECS 19 & 30
 - 2640.00 QUARTER SEC COR. SET POST & RAISED MOUND 5570.40 INT. RANGE LINE SET POST & RAISED MOUND LAND ROLLING 1ST RATE PRAIRIE GROWTH GRASS & WEEDS
- 1833 HARRISON T4N R9E EAST ON

RANDOM BET SECS 25 & 36

- 2640.00 TEMPORARY 1/4 SEC COR.
- 5206.08 INT. E BNDY 125.4 NOF P. LAND ROLLING 1ST RATE PRAIRIE RATHER BROKEN GROWTH PRAIRIE GRASS & WEEDS

WEST COR WEST BET SECS 25 & 36

- 2603.04 QUARTER SEC CORNER MARKED POST & RAISED MOUND
- 1860 RUGER VOL 1 PG 148 SET LIMESTONE 20X10X7 & SET SAND STONE ON SOUTH & LIMESTONE ON NORTH SIDES. VAR 7-55 2931.72, VAR 7-55 5579.64 TO SET LS 18X9X6 @ NE COR SEC 30, 2636.70 TO W 1/4 COR SEC 30, 5273.40 TO SW COR SEC 30, & SOUTHERLY TO SET LS 15X9X3 LIMESTONE & SET LS ON WEST & SAND STONE ON EAST SIDE OF SE COR SEC 25.
- 1860 RUGER VOL 1 PG 149 SET LIMESTONE 20X10X7 & SET SANDSTONE ON SOUTH & LIMESTONE ON NORTH SIDE.
 2931.72 TO S 1/4 COR SEC 19 & 5579.64 TO SET LIMESTONE 18X9X6 @ SE COR SEC 19.
- 1870 RUGER AUG REMON-87 SOUTH ON WEST LINE OF NW 1/4
 SEC 30 ON A VAR 6-25; AT
 - 2632.41 INTESECTED QUARTER LINE 4.95' WEST OF QUARTER CORNER. FOUND HARD HEAD STONE AT CORNER SET BY SELF IN A PREVIOUS SURVEY. COR VAR 6-32

SOUTH ON WEST LINE OF SW 1/4 SEC 30 ON A VAR 6-32: AT

- 2632.41 INTERSECTED SOUTH BOUNDARY LINE AT CORNER.
- 1870 RUGER AUG REMON-85 WEST ON NORTH LINE OF NE 1/4 SEC 30 ON A VAR 7-11; AT
 - 2647.48 INTERSECTED QUARTER LINE AT QUARTER CORNER. FOUND HARD HEAD STONE ON CORNER SET BY SELF IN PREVIOUS SURVEY.

WEST ON NORTH LINE OF NW 1/4 SEC 30 ON A VAR 7-30; AT

2931.28 INTERSECTED WEST BOUNDARY LINE AT CORNER. FOUND LIMESTONE AT CORNER SET BY SELF IN PREVIOUS SURVEY.

SHEET 1 OF 3

CORNER CODE R-1

Parol 0 eT 17,20// UN581 NWCORSEC30

1870 RUGER AUG 25 REMON-86 AUGUST 25 1870 NORTH ON WEST LINE OF SW 1/4 SEC 19 ON A VAR6-10; AT

2602.05 INTERSECTED QUARTER LINE 6.6' WEST OF QUARTER CORNER. FOUND HARD HEAD STONE AT CORNER SET BY SELF IN SURVEY. COR VAR 6-

NORTH ON WEST LINE OF NW 1/4 SEC 19 ON A VAR 5-50; AT

2601.39 INTERSECTED NORTH BOUNDARY LINE 5.28' EAST OF CORNER. COR VAR 5-57

- 1906 KERCH VOL 3 PG 37 FD MON. STAKED OUT CENTER OF RD 33 EAST SIDE OF SEC. LINE
- 1936 SUNNY VOL 3 PG 302 FD LS MON. TOP BROKEN OFF 6"
 LOW. SET CAPPED 1 1/2 IRON PIPE MON ON TOP. REFER.
 SAME. 21.8 EAST OF N/S FENCE ON WEST SIDE OF RD.
- 1966 BATTERMAN VOL 4 PG 265 DUG & FD CUT STONE 1' DEEP. RE-SET 3' DEEP. REFERENCED SAME.
- 1974 SCHROEDER CSM VOL 3 PG 356 STATES NOTHING ABOUT MONUMENTS. SOUTH TO NW COR SEC 30
- 1976 TALARCZYK #5234 NE COR SEC 36 ALUM MON. TIE SHEET 10' NORTH OF E/W CENTER OF PVMT & ON CENTER OF N/S PVMT. CORNER SET BY PROPORTIONATE MEASUREMENT & EXISTING PHYSICAL EVIDENCE
- 1976 BARNES VOL 5 PG 132 FD PK REF SAME. SET BERNSTEN W-1-B MON
- 1994 COMBS CSM VOL 17 PG 205 POLY MON. N89-20-40E TO PK @ N 1/4 COR SEC 30 & SOUTH 2636.66 TO PK @ W 1/4 COR SEC 30

FD REFERENCE MONUMENTS & SOUND OF ALUM. MON.

C) Was the corner restored through acceptance of (1) an obliterated evidence location, or, (2) a found perpetuated location?

ACCEPTED POSITION AS DETERMINED FROM TIES, WHICH PERPETUATES CUT LIMESTONE.

D) Describe any material discrepancy between the location of the corner as restored or reestablished and the location of that corner as previously restored or reestablished by distance and direction. Show the discrepancy on the plan view drawing under (a), above. Show the distances between the corner as previously restored or reestablished and (1) the corner as restored or reestablished, and (2) to at least 4 of the witness monuments shown on the drawing in (a), above.

NONE

(E) Was the corner reestablished through lost corner proportionate methods? If so, show the method, including the directions and distances to other public land survey corners used as evidence or used for proportioning the corner location.

NΟ

I, **Donald Barnes**, hereby certify that the corner location as identified by the corner code index was determined by me under my direction and control and that this U.S. Public Land Survey Monument Record is correct and complete to the best of my knowledge and belief.

SHEET 2 OF 3

Hans Banos OCT 17,2011

GORNER GODE R-1

A.E. 7.08 REQUIREMENT