Paper weight-110# (minimum)

Black nonfading ink required LAND SUI U.S. PUBLIC SURVEY MONUMENT RECORD


For Public Land Survey Corners In:

WI ADMINISTRATIVE CODE A-E 7.08 REQUIREMENT

REV 10/23/2004 USMONREC.DWG

T. $\frac{4}{N}$ N. R. $\frac{10}{E}$ E. 4th P.M.

CORNER CODE INDEX

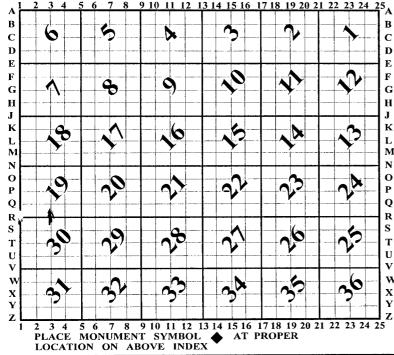

UNION TWP ROCK COUNTY WI

IF AVAILABLE ROCK COUNTY COORDINATES PERFERRED

North	Elev
East	·
Hor. Datum	Vert. Datum
LATITUDE _	ELLIPS. HT.
LONGITUDE _	
NAD83(91)	NETWORK ADJ. YR 2010
GPS (X)	TRAVERSE (X) X
BASED ON THE	E FOLLOWING CONTROL:

◆ CORNER MONUMENT

WITNESS MONUMENT

(a) ROCK COUNTY PROJECTION BEARINGS ARE BASED ON:_

FIELD BOOK PAGE #			1	2.
OR OBSERVATION SHEET			_/ OF	
SHOW A PLAN VIEW DRAWING DEPICTING THE CORNER MONUMENT AND SURRO	OUN	IDING		
PHYSICAL FEATURES, INCLUDING THE EXCAVATION AREA AND DEPTH.				
PLANNING & ZONING COMMITTEE ADOPTED THIS FORM ON 12/2/1982			0	

UN582 N1/4CORSEC30

- (B) Describe any record evidence, monument evidence, occupational evidence, testimonial evidence or any other material evidence you considered, and whether the monument was found or placed.
- 1833 HARRISON T4N R1DE 4TH MER WEST BETWEEN SECS 19
 - 2640.00 QUARTER SEC COR. SET POST & RAISED MOUND 5570.40 INT. RANGE LINE SET POST & RAISED MOUND LAND ROLLING 1ST RATE PRAIRIE GOWTH GRASS & WEEDS
- 1860 RUGER VOL 1 PG 148 SET HARDHEAD 15X8X7 VAR7-55
 2647.92 TO SET LS 18X9X6 @ NE COR SEC 30, VAR7-55
 2931.72 TO SET LIMESTONE 20X10X7 @ NW COR SEC 30,
 2638.68 TO SET LS 16X8X6 @ CENTER OF SEC 30. USED TO
 SUBDIVIDE SEC 30
- 1860 RUGER VOL 1 PG 149 USED TO SUBDIVIDE SEC 19. SET HH 15X8X7. 2647.92 TO SET LS 18X9X6 @ SE COR SEC 19 & 2931.72 TO SET LS 20X10X7 @ SW COR SEC 19. USED TO SUBDIVIDE SEC 19
- 1870 RUGER AUG REMON-85 WEST ON NORTH LINE OF NE 1/4
 SEC 30 ON A VAR 7-11; AT
 - 2647.48 INTERSECTED QUARTER LINE AT QUARTER CORNER. FOUND HARD HEAD STONE ON CORNER SET BY SELF IN PREVIOUS SURVEY.

WEST ON NORTH LINE OF NW 1/4 SEC 30 ON A VAR 7-30; AT

- 2931.28 INTERSECTED WEST BOUNDARY LINE AT CORNER. FOUND LIMESTONE AT CORNER SET BY SELF IN PREVIOUS SURVEY.
- 1936 SUNNY VOL 3 PG 302 FD 6X6 CUT STONE MON. 18" LOW. SET 1 1/2 CAPPED PIPE ON TOP. REF. SAME. ON LINE WITH N/S FENCE ON NORTH SIDE OF RD
- 1963 BATTERMAN VOL 4 PG 245 FD CUT STONE. REF. SAME. ON LINE N/S FENCE ON NORTH SIDE OF RD.
- 1966 BATTERMAN VOL 4 PG 265 FD CUT STONE. REF. SAME. ON LINE N/S FENCE ON NORTH SIDE OF RD.
- 1994 COMBS CSM VOL 17 PG 205. PK N89-20-40E TO @ POLY MON NW SEC 30

FD NO METAL ATTRACTION. LOCATION FITS WITH FD 3 REFERENCE MONUNEMTS.

C) Was the corner restored through acceptance of (1) an obliterated evidence location, or, (2) a found perpetuated location?

ACCEPTED LOCATION AS DETERMINED BY 3 REFERENCE MONUMENTS.

D) Describe any material discrepancy between the location of the corner as restored or reestablished and the location of that corner as previously restored or reestablished by distance and direction. Show the discrepancy on the plan view drawing under (a), above. Show the distances between the corner as previously restored or reestablished and (1) the corner as restored or reestablished, and (2) to at least 4 of the witness monuments shown on the drawing in (a), above.

NONE

(E) Was the corner reestablished through lost corner proportionate methods? If so, show the method, including the directions and distances to other public land survey corners used as evidence or used for proportioning the corner location.

YES. IN 1860 RUGER VOL 1 PG 148 SET IT ON LINE & @ MID POINT. I, **Donald Barnes**, hereby certify that the corner location as identified by the corner code index was determined by me under my direction and control and that this U.S. Public Land Survey Monument Record is correct and complete to the best of my knowledge and belief.

SHEET 1 OF 2

CORNER CODE R-3

Denild Carea

8 (T/9 A.E. 7

A.E. 7.08 REQUIREMENT

2011

