


# U.S. PUBLIC LAND SURVEY MONUMENT RECORD

For Public Land Survey Corners in the  
T. 2 N., R. 12 E.

## CORNER CODE INDEX

	1	2	3	4	5	6	7	8	9	10	11	12	13	14	15	16	17	18	19	20	21	22	23	24	25
A																									
B																									
C	6																								
D		5																							
E			4																						
F				3																					
G					2																				
H	7																								
I		8																							
J			9																						
K				10																					
L					11																				
M						12																			
N	18																								
O		17																							
P			16																						
Q				15																					
R					14																				
S						13																			
T	19																								
U		20																							
V			21																						
W				22																					
X					23																				
Y						24																			
Z	25																								
		26																							
			27																						
				28																					
					29																				
						30																			
							31																		
								32																	
									33																
										34															
											35														
												36													

### EXAMPLE

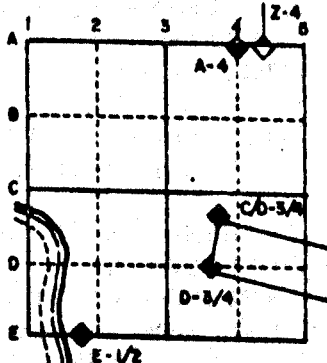

ROCK TWP  
ROCK COUNTY WI

IF AVAILABLE  
STATE PLANE COORDINATES

NAD North (Y) 219,614.78      Eleve. (Z) \_\_\_\_\_  
 27 East (X) 2,237,109.55      Zone \_\_\_\_\_  
 Hor. Datum \_\_\_\_\_      Vert. Datum \_\_\_\_\_  
 WPL 219,613.85  
2,237,108.93

PLACE MONUMENT SYMBOL (◆) AT PROPER  
LOCATION ON ABOVE INDEX

◆ CORNER MONUMENT

○ WITNESS MONUMENT

c.)

FOUND 1" PIPE      REC 44.14  
N89°58'00"E 44.13'      FOUND 1" PIPE

REC 96.41  
N0°14'42"E 96.24'  
N15°10'58"W 50.61'  
REC 50.61'  
19.05'

REC 57.81  
S32°17'02"W 57.81'

PLYMOUTH  
CHURCH RD

FOUND CAST IRON  
MONUMENT

S16°05'05"W 49.33'  
REC 49.45'

N33°37'32"W 57.53'  
REC 57.55'

S0°34'48"E 96.78'  
REC 96.84'

FOUND 1" PIPE      REC 45.47  
N89°22'01"W 45.52'

FOUND 1" PIPE

XX

XXXXX  
← 21 →

BEARINGS ARE BASED ON: ASSUMED

FIELD BOOK #2  
PAGES 67  
#3 PG 1

MICROFILMED

SHEET \_\_\_ OF \_\_\_

CORNER CODE: V3

(B) Describe any record evidence, monument evidence, occupational evidence, testimonial evidence or any other material evidence you considered, and whether the monument was found or placed.

1834 HARRISON ORIGINAL GOVERNMENT SURVEYOR. FIELD NOTES - 1/4 SECTION CORNER. WHITE OAK 24 S77E 275 AND RED OAK 12 S71W. MEASURED 2640 TO THE SE AND 2691.48 TO THE SW CORNERS OF SECTION 30.

1855 CHURCH VOL 1 PG 31. SHOWS A DISTANCE OF 2644.62 TO THE CENTER OF SECTION 30 AND 2640 TO THE SE CORNER OF SECTION 30.

1870 VOL 2 PG 46 FOUND REMAINS OF OLD STAKE AND STUMP OF BEARING TREE. SET LIMESTONE 26X7X3.

1972 LEE VOL 4 PG 577 WPL COORDINATES- N/S 219,613.85;E/W 2,237,108.93. SHOWS N88-50-00W 2696.82 TO THE SW COR OF SEC 30, N88-50-00W 2645.24 TO THE SE COR OF SEC 30, AND N0-05-21E 5292.48 TO THE N 1/4 COR OF SEC 30.

1972 LEE VOL 4 PG 581 SET BY PRORATION. SET CAST IRON MONUMENT AND REFERENCED SAME.

1981 BARNES VOL 6 PG 143 SHOWS WPL DISTANCE AND BEARING OF N1-12-11W 2653.05 TO THE CENTER OF SEC 31.

1981 BARNES VOL 6 PG 144 SHOWS (WPL) N89-47-31E 2698.41 TO THE SW COR OF SEC 30, (WPL) N89-47-24E 2645.54 TO THE SE COR SEC 30, AND (WPL) N1-12-11W 2653.06 TO THE CENTER OF SEC 31.

FOUND CAST IRON MONUMENT WITHOUT CAP. ADDED CAP.


C) Was the corner restored through acceptance of (1) an obliterated evidence location, or, (2) a found perpetuated location?

ACCEPTED FOUND CAST IRON MONUMENT.

D) Describe any material discrepancy between the location of the corner as restored or reestablished and the location of that corner as previously restored or reestablished by distance and direction. Show the discrepancy on the plan view drawing under (a), above. Show the distances between the corner as previously restored or reestablished and (1) the corner as restored or reestablished, and (2) to at least 4 of the witness monuments shown on the drawing in (a), above.

(E) Was the corner reestablished through lost corner proportionate methods? If so, show the method, including the directions and distances to other public land survey corners used as evidence or used for proportioning the corner location.

I, Donald Barnes, hereby certify that the corner points as identified by the corner code index were, in a field survey on, JULY 14, 1989, established, re-established, monumented, re-monumented, recovered or restored as expressed below and in conformance with the regulations and rules as required in the current manual of survey instructions of the United States Department of the Interior, Bureau of Land Management.

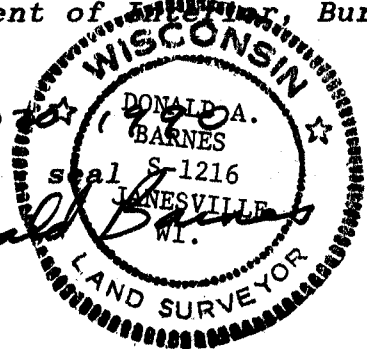

COUNTY SURVEYOR FILING DATA

Date of computer entry \_\_\_\_\_

Date microfilmed \_\_\_\_\_

Number of included sheets \_\_\_\_\_

CORNER CODE

V3

AFFIX YOUR LAND SURVEYOR SEAL