

U.S. PUBLIC LAND SURVEY MONUMENT RECORD


For Public Land Survey Corners in the
T. 2 N., R. 12 E.

CORNER CODE INDEX

	1	2	3	4	5	6	7	8	9	10	11	12	13	14	15	16	17	18	19	20	21	22	23	24	25
A																									
B																									
C	6																								
D		5																							
E			4																						
F				3																					
G					2																				
H																									
I	7																								
J		6																							
K			5																						
L				4																					
M					3																				
N						2																			
O							1																		
P	8																								
Q		20																							
R			21																						
S				22																					
T					23																				
U						24																			
V							25																		
W								26																	
X									27																
Y										28															
Z											29														
AA												30													
AB													31												
AC														32											
AD															33										
AE																34									
AF																	35								
AG																		36							

PLACE MONUMENT SYMBOL (●) AT PROPER LOCATION ON ABOVE INDEX

EXAMPLE

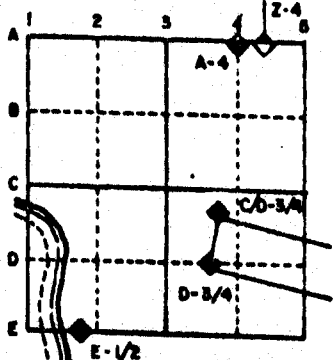


ROCK TWP
ROCK COUNTY WI

IF AVAILABLE
STATE PLANE COORDINATES

North (Y) 214,301.55 Eleve. (Z) _____
 East (X) 2,234,553.37 Zone _____
 Hor. Datum _____ Vert. Datum _____
 WPL 214,300.60
2,234,552.50

e.) CORNER MONUMENT WITNESS MONUMENT

JOHNSON RD

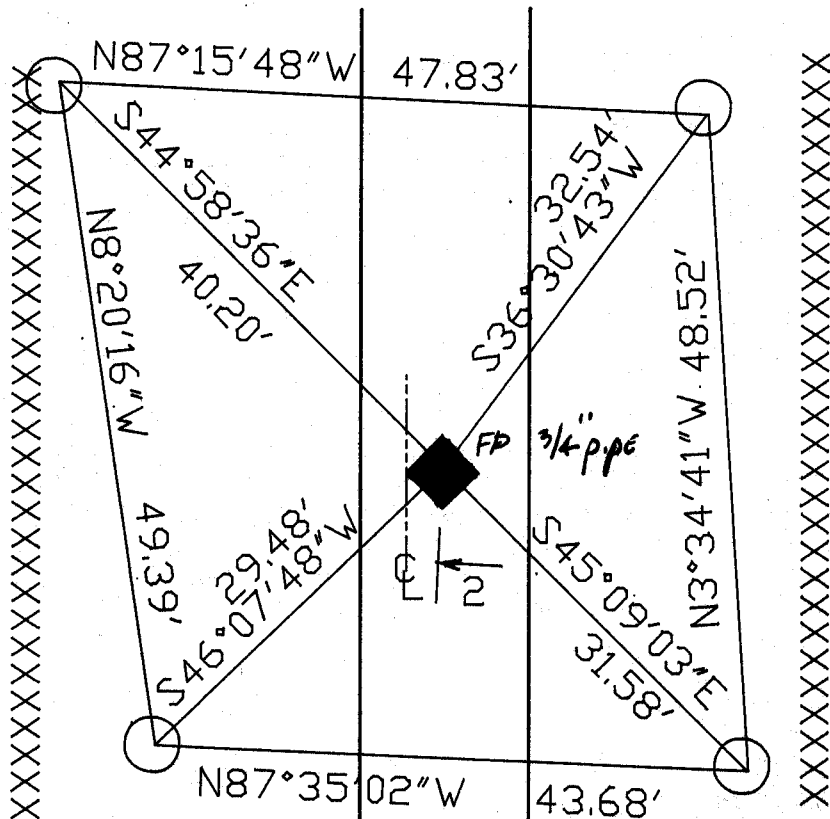

BEARINGS ARE BASED ON: ASSUMED

FIELD BOOK #3 PG 30

3/4X24 REROD WITH ORANGE PLASTIC CAP

MICROFILMED

SHEET ___ OF ___

CORNER CODE: 21

(B) Describe any record evidence, monument evidence, occupational evidence, testimonial evidence or any other material evidence you considered, and whether the monument was found or placed.

- 1833 MULLETT ORIGINAL GOVERNMENT SURVEYOR. FIELD NOTES - SET POST CORNERS TOWNSHIP 1 & 2 N. RANGES 11 & 12 E BLACK OAK 8 N53E .30 AND BLACK OAK 6 S32E .14
- 1868 LOCKE PLYMOUTH TOWNSHIP REMONUMENTATION FIELD NOTES. SOUTH ON EAST LINE OF SECTION 36. INTERSECTED SOUTH BOUNDARY 5.61' WEST OF CORNER. FOUND STUMPS OF B.T.s AND OLD STAKE. VAR CORRECTED 7-32. MEASURED 2661.12' TO NE CORNER OF SECTION 36 FROM E 1/4 CORNER OF SECTION 36 PLYMOUTH TOWNSHIP AND 2645.45 TO S 1/4 CORNER OF SECTION 36.
- 1870 RUGER VOL 2 PG 45. FOUND STONE MONUMENT SET BY LOCKE. SHOWS 2446.84 TO THE N 1/4 CORNER OF SECTION 6 BELOIT.
- 1874 RUGER VOL 2 PG 127 STONE MONUMENT.
- 1881 LEE VOL 2 G 328 FOUND MONUMENT SHOWS 2448.60 TO N 1/4 CORNER OF SECTION 6 BELOIT TOWNSHIP AND 2647.92 TO W 1/4 CORNER OF SECTION 6.
- 1959 BATTERMAN VOL 4 PG 11 FOUND CUT LIMESTONE. 1" PIPE IN BLACKTOP. WPL COORDINATES N/S 214,300.60 E/W 2,234,552.50. REFERENCED CORNER.
- 1966 BATTERMAN VOL 4 PG 286 IRON PIPE
- 1981 BARNES VOL 6 PG 144 SHOWS THE FOLLOWING DISTANCES:
- | | | |
|---------------------|----------------|---------|
| TO W 1/4 COR SEC 31 | WPL N1-26N02W | 2647.01 |
| | LOCKE 1868 | 2650.56 |
| | RUGER 1870 | 2641.98 |
| S 1/4 COR SEC 31 | RUGER 1870 | 2651.22 |
| N 1/4 COR SEC 6 | RUGER 1870 | 2446.84 |
| | WPL N89-38-22E | 2452.66 |
| W 1/4 COR SEC 6 | WPL N0-01-26W | 2650.74 |
| | COLLINS 1871 | 2657.16 |


FOUND 3/4" PIPE THAT IS 2' EAST OF THE CENTER OF THE PAVEMENT.

C) Was the corner restored through acceptance of (1) an obliterated evidence location, or, (2) a found perpetuated location?

ACCEPTED FOUND PERPETUATED LOCATION.

D) Describe any material discrepancy between the location of the corner as restored or reestablished and the location of that corner as previously restored or reestablished by distance and direction. Show the discrepancy on the plan view drawing under (a), above. Show the distances between the corner as previously restored or reestablished and (1) the corner as restored or reestablished, and (2) to at least 4 of the witness monuments shown on the drawing in (a), above.

I, Donald Barnes, hereby certify that the corner points as identified by the corner code index were, in a field survey on, August 17, 1990, established, re-established, monumented, re-monumented, recovered or restored as expressed below and in conformance with the regulations and rules as required in the current manual of survey instructions of the United States Department of Interior, Bureau of Land Management.

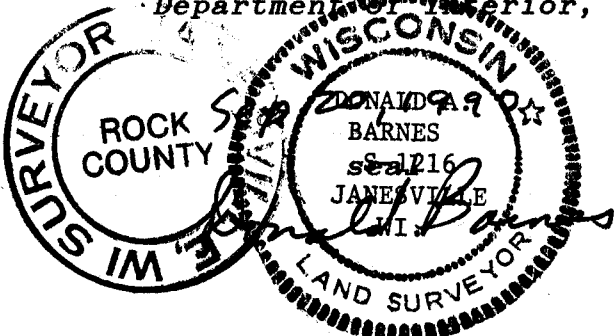

COUNTY SURVEYOR FILING DATA

Date of computer entry _____

Date microfilmed _____

Number of included sheets _____
CORNER CODE

AFFIX YOUR LAND SURVEYOR SEAL

21