Paper weight-110# (minimum)


Black nonfading ink required LAND SUI U.S. **PUBLIC** SURVEY MONUMENT RECORD

For Public Land Survey Corners In:

WI ADMINISTRATIVE CODE A-E 7.08 REQUIREMENT

REV 10/23/2004 USMONREC.DWG

T. 4 N. R. 10 E. 4th P.M. CORNER CODE INDEX

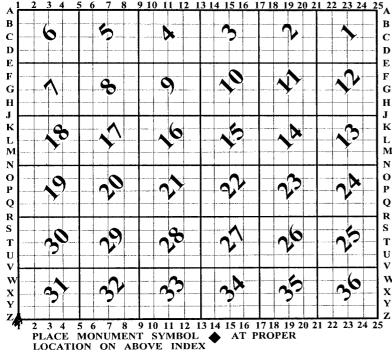

UNION TWP **ROCK COUNTY WI**

IF AVAILABLE ROCK COUNTY COORDINATES PERFERRED

North	Elev.
East	
Hor. Datum	Vert. Datum
LATITUDE	ELLIPS. HT.
LONGITUDE _	
NAD83(91)	NETWORK ADJ. YR 2010
GPS (X)	TRAVERSE (X) X
BASED ON THE	E FOLLOWING CONTROL:

◆ CORNER MONUMENT

O WITNESS MONUMENT

	L
(a)	
ROCK COUNTY PROJECTION	
į	
	BASED
	AKK
	BEAKINGS

FIELD BOOK PAGE #	SHEET	/		1
			OF	
SHOW A PLAN VIEW DRAWING DEPICTING THE CORNER MONUMENT AND S	SURROUN	DING		
PHYSICAL FEATURES, INCLUDING THE EXCAVATION AREA AND DEPTH.				
DI ANNING & ZONING COMMITTEE ADOPTED THIS FORM ON 12/2/1982.				

UN621 SWCORSEC31

(B) Describe any record evidence, monument evidence, occupational evidence, testimonial evidence or any other material evidence you considered, and whether the monument was found or placed.

1833 BRINK SEP 11 EAST BOUNDARY T3N R9E NORTH ON EAST SIDE SEC 12

528.00 WESTERN POINT OF A SAND STONE LEDGE

990.00 DESCENT TO CREEK BOTTOMS

1716.00 RAPID STREAM 16.5' CROSS WEST

2508.00 LEAVE BOTTOM LAND

2640.00 SET 1/4 SECTION POST BURR OAK 16 S41W 66.00' BUR OAK 16 N42W 45.54'

3468.96 W. DAK 14

5280.00 SET POST CORNER SECTIONS 1 & 12 W OAK 14 S26W 21.78 W. OAK 15 N1W 40.92 LAND ROLLING, SECOND RATE BLACK & BURR OAK, & ?/

1833 BRINK SEP 11 NORTH ON EAST SIDE SECTION 1

2640.00 ENTER PRAIRIE

1676.40 A SMALL SPRING RUNNING EAST

2640.00 SET 1/4 SECTION POST IN PRAIRIE AND MADE A MOUND & C?

5280.00 INTERSECTED SOUTH BOUNDARY OF T4 AS RUN OUT FROM SUGAR CREEK. SET POST FOR CORNER TO TOWNSHIPS 3 & 4 NORTH, RANGE 9 EAST IN PRAIRIE AND MADE A MOUND, &C? LAND ROLLING SECOND RATE PRAIRIE HAZEL GRASS & ? LAND ROLLING SECOND RATE PRAIRIE HALE GRASS, & C. SEPTEMBER 11TH 1833

1833 BRINK (SEP 12) WEST ON SOUTH SIDE OF SECTION 31 T4N
R10E

249.48 W DAK 14

2640.00 SET QUARTER POST BURR OAK 7 N43E 55.44'; BURR OAK 6 N70W 65.34'

5732.76 INTERSECTED RANGE LINE 924' NORTH OF CORNER TO SECTIONS 1 & 12. SET POST AT INTERSECTION FOR CORNER TO T3 & 4N R10E. W. OAK 16 N61E 15.18', W. OAK 18 SBE 75.9' LAND ROLLING SECOND RATE BURR OAK W. OAK HICKORY & HAZLE ???? SEP 12TH 1833

1833 HARRISON (DEC 9) SE COR SEC 1 T3N R9E EAST ON RAND.

BET 1 & 12

1848.00 LEAVE TIMBER & ENTER MARSH

2574.00 LEAVE MARSH & ENTER TIMBER

2640.00 TEMPY 1/4 SEC CORNER

5254.92 INT. E. BDY 237.60 NORTH OF P. LAND LEVEL 2ND RATE TIMBER BURR W.O. & RED OAK. ??? GRASS & WEEDS.

WEST COR. BET. SECS 1 & 12

2627.46 QUARTER SEC. CORNER. {BURR O. 16 N2OE 26.4 BURR OAK 13 SB3E 36.96 BURR O 16, BURR O 13}MARKED

5254.92 SEC COR.

BENSON MAGNOLIA TOWN RD RECORDS BK 1 PG 1 NOTICE OF A SURVEY OF A ROAD LEADING FROM BELOIT ROCK COUTNY, WISCONSIN TERRITORY TO EXETER IN GREEN COUNTY, WISCONSIN. COMMENCING AT THE TOWN LINE 877.80' WEST OF THE 1/4 POST ON THE NORTH SIDE OF SEC 6 T2 RANGE 10 E RUNNING N18W 1188'; THENCE N21-30W 990'; THENCE N18W 1188'; THENCE N34 -15W 2574' THENCE NORTH 17-15 ? 726'; N21-30W 990' TO THE COUNTY LINE HIRAM BROWN, ELISA MC MONTH COMMISSIONERS APPOINTED BY THE ACT OF LEGISLATURE 1945 OF THE ACT

SHEET 1 OF 4

CORNER CODE ${f Z}-{f 1}$

Level James Det 11,2011

UN621 SWCORSEC31

TO AURHORIZE THE LOCATION OF CERTAIN TERRITORY ROADS. I DO HEREBY CERTIFY THAT THE ABOVE MINUTES OF THE SURVEY OF A ROAD FROM BELOIT TO EXETER, W.T. AS SURVEYED BY ME. HENRY A. BENSON, SURVEYOR

- MAGNOLIA TOWN RD RECORDS RD BK 1 PG 12 ALBON 1851 SOUGHTON AND OTHERS OF THE TOWN OF ALBANY TO DO SURVEY AND REROUTE THE ROUTE FOR A HIGHWAY ON THE TOWN LINE BETWEEN THE TOWNS OF MAGNOLIA AND ALBANY IT WAS ORDERED THAT THE FOLLOWING SURVEY CONSTITUTE SAID HIGHWAY TO WIT: COMMENCING AT THE SOUTH EAST CORNER OF THE TOWN OF ALBANY AND RUNNING THENCE NORTH ON THE TOWN LINE TO THE 1/4 STAKE ON THE EAST SIDE OF SECTION 36 THENCE NORTH 60 1/2W 299.64; THENCE N47W 231.0' THENCE N11W 259.71 TO A RED OAK TREE THENCE N42 1/2E 698.2B TO THE SAID TOWN LINE THENCE NORTH ON THE TOWN LINE BETWEEN THE TWO TOWNS TO THE CORNER OF THE TOWN OF MAGNOLIA. THE SAID COURSE AND DISTANCE TO BE FOUR RODS WIDE. THE VARIATION OF THE MAGNETIC NEEDLE IS 7- 25 MINUTES
- MAGNOLIA TWP RD REC BK 1 PG 25 """ WHEREOF AN 1859 ACCURATE SURVEY HAS BEEN MADE WHICH IS AS FOLLOWS TO WIT. COMMENCING AT THE QUARTER STAKE ON THE SOUTH LINE DIVIDING SEC 32 OF UNION & SECTION FIVE IN MAGNOLIA AND RUNNING THENCE WEST ALONG SAID LINE TO THE SOUTH CENTER QUARTER POST OF SECTION 31 OF SAID TOWN OF UNION AND SECTION 6 OF MAGNOLIA THE LINE OF SAID SURVEY TO BE THE CENTER OF SAID HIGHWAY THENCE WEST ON THE LINE OF SAID SECTION 31 IN THE TOWN OF UNION AND SECTION SIX OF MAGNOLIA TO THE WEST LINE O FTHE EAST HALF OF THE NW 1/4 OF SECTION SIX IN THE TOWN OF MAGNOLIA, LINE OF SAID SURVEY TO BE THE NORTH LINE OF SAID HIGHWAY THENCE WEST ALONG THE LINE OF SECTION 31 AND SECTION 6 OF THE TOWN OF MAGNOLIA TO THE WEST SIDE OF SAID SECTION, THE LINE OF SAID SURVEY TO BE THE CENTER OF SAID HIGHWAY AND THE SAME IS HEREBY ESTABLISHED FOUR RODS WIDE.
- 1864 LOCKE VOL 1 PG 205 FD STUMPS OF BTS SET HARDHEAD
 11 1/2XBX5. VAR 6-50 2749.23 TO N 1/4 COR SEC 6 T3N
 R10E, VAR 7-55 924.00 TO SET BR. 0 STAKE @ SE COR SEC
 1, & VAR 7-05 2185.59 TO SET LS 24X15X6 @ W 1/4 COR
 SEC 6 T3N R10E
- 1870 RUGER AUG REMON-82 AUGUST 24 1870 WEST ON
 SOUTH LINE OF SE 1/4 SEC 31 ON A VAR 6-45
 OFFSET SOUTH 30.03' OFFSET NORTH 10.56' AT
 - 2627.79 INTERSECTED QUARTER LINE 11.88 SOUTH OF QUARTER CORNER. FOUND OLD STAKE AT CORNER. ALSO FOUND EAST BEARING TREE AND WHERE STUMP OF WEST BEARING TREE HAD BEEN DUG UP. COR VAR 6-55

WEST ON SOUTH LINE OF SW 1/4 SEC 31 ON A VAR 7-17' OFFSET SOUTH 34.98' OFFSET NORTH 17.82' OFFSET NORTH 15.18' OFFSET NORTH 8.58' OFFET NORTH 7.92 AT

2988.48 INTERSECTED WEST BOUNDARY LINE 9.9' SOUTH OF CORNER FOUND OLD STAKE AT CORNER ALSO FOUND STUMPS OF BEARING TREES. COR VAR 6-45

1870 RUGER AUG

REMON-83 NORTH ON WEST LINE OF SW 1/4
SEC 31 ON A VAR 7-18 OFFSET WEST 6.93'
OFFSET WEST 4.95 COULD FIND NO TRACE OF
QUARTER CORNER. CONTINUED LINE ON SAME
VARIATION. AT

SHEET 2 OF 4

CORNER CODE Z-1

0 (T12, 201)

UN621 SWCORSEC31

5246.34

INTERSECTED NORTH BOUNDARY LINE 24.09'
EAST OF CORNER FOUND HARD HEAD STONE AT
CORNER SET BY SELF IN A PREVIOUS SURVEY
COR VAR 7-41
ESTABLISHED QUARTER CORNER AT A POINT IN A

ESTABLISHED QUARTER CORNER AT A POINT IN A TRUE LINE BETWEEN AND EQUI-DISTANT FROM THE NORTH WEST AND SOUTH WEST CORNERS OF SAID SECTION. IT BEING 2623.17 DISTANT FROM EACH.

- 1966 BATTERMAN VOL 4 PG 266 FD CUT STONE & REFERENCED SAME.
- 1973 SCHROEDER VOL 3 PG 74 STATES NOTHING ABOUT MON. EAST 1383.21
- 1973 LEE CSM VOL 3 PG 192 SET PIN. WEST 250.26 TO NW COR SEC 5. ANGLE 89-25-29 @ NW COR SEC 5 FROM SW COR SEC 31 TO W 1/4 COR SEC 5
- 1978 BARNES VOL 5 PG 459 SET ALUM. MON. FD PK & 2.3' DEEP FD CUT LIMESTONE. SOUTHERLY 929.18 TO FD ALUM @ NE COR SEC 12. 959 SOUTH OF NW COR SEC 6 T3N R10E DUG A 3' DEEP & 25' WIDE HOLE SOUTHERLY 6" AT THE CENTER OF THE ROAD AND FOUND NOTHING. ANGLE @ NE COR SEC 12 FROM NW COR SEC 6 TO W 1/4 COR SEC 6 IS 179-58-17. SW COR SEC 31 TO W 1/4 COR SEC 6 IS 2194.49
- 1978 TALARCZK #6987 E 1/4 COR SEC 1 T3N R9E CAST ALUM.
 MON. CORNER SET BY PROPORTIONATE MEASUREMENT &
 EXISTING PHYSICAL EVIDENCE. 1' WEST OF PVMT CENTER
 & 51.72' NE OF 2 STORE HOUSE NE PORCH CORNER
- 1978 TALARCZK #2724 SE COR SEC 1 T3N R9E CAST ALUM.
 MON. CORNER SET BY PROPORTIONATE MEASUREMENT &
 EXISTING PHYSICAL EVIDENCE. REFERENCED SAME. 3'
 SOUTH OF E/W CENTER PVMT.

FD ALUM MON ON LINE WITH E/W CENTER PVMT LINE PROJECTED FROM EAST & 1 † EAST OF N/S PVMT CENTER.

C) Was the corner restored through acceptance of (1) an obliterated evidence location, or, (2) a found perpetuated location?

ACCEPTED FD ALUM. MON. WHICH IS ON TOP OF CUT LS.

D) Describe any material discrepancy between the location of the corner as restored or reestablished and the location of that corner as previously restored or reestablished by distance and direction. Show the discrepancy on the plan view drawing under (a), above. Show the distances between the corner as previously restored or reestablished and (1) the corner as restored or reestablished, and (2) to at least 4 of the witness monuments shown on the drawing in (a), above.

NONE

(E) Was the corner reestablished through lost corner proportionate methods? If so, show the method, including the directions and distances to other public land survey corners used as evidence or used for proportioning the corner location.

ΝП

I, **Donald Barnes**, hereby certify that the corner location as identified by the corner code index was determined by me under my direction and control and that this U.S. Public Land Survey Monument Record is correct and complete to the best of my knowledge and belief.

SHEET 3 OF 4

Oct 12, 2011

corner code Z-1

A.E. 7.08 REQUIREMENT

