Paper weight-110# (minimum)

Black nonfading ink required LAND SUI U.S. PUBLIC SURVEY MONUMENT RECORD


For Public Land Survey Corners In:

WI ADMINISTRATIVE CODE A-E 7.08 REQUIREMENT

REV 10/23/2004 USMONREC.DWG

T. $\frac{4}{N}$ N. R. $\frac{10}{E}$ 4th P.M.

CORNER CODE INDEX

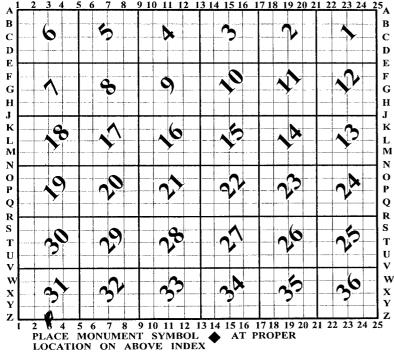

UNION ROCK COUNTY WI

IF AVAILABLE ROCK COUNTY COORDINATES PERFERRED

North Elev. East Hor. Datum ____ Vert. Datum **LATITUDE** ELLIPS. HT. LONGITUDE NAD83(91) _____NETWORK ADJ. YR 2010 GPS (X) ____ TRAVERSE (X) X BASED ON THE FOLLOWING CONTROL:

◆ CORNER MONUMENT

WITNESS MONUMENT

(a) ROCK COUNTY PROJECTION BEARINGS ARE BASED ON:

FIELD BOOK PAGE #		,		7
OR OBSERVATION SHEET	SHEET	-	F.	
SHOW A PLAN VIEW DRAWING DEPICTING THE CORNER MONUMENT AND	SURROUN	DING		
PHYSICAL FEATURES, INCLUDING THE EXCAVATION AREA AND DEPTH.				
PLANNING & ZONING COMMITTEE ADOPTED THIS FORM ON 12/2/1982		~		P.
	~~~			75

## UN622 S1/4CORSEC31

(B) Describe any record evidence, monument evidence, occupational evidence, testimonial evidence or any other material evidence you considered, and whether the monument was found or placed.

1833 BRINK & MULLETT (SEP 12) T4N R10E

WEST ON SOUTH SIDE OF SECTION 31 (PG111)

249.48 W. OAK 14

2640.00 SET QUARTER POST BURR DAK 7 N43E 55.44'; BURR DAK 6 N 70W 65.34'

- 5732.76 INTERSECTED RANGE LINE 924' NORTH OF CORNER TO SECTIONS 1 & 12. SET POST AT INTERSECTION FOR CORNER TO TS 3 & 4N R10E. W. OAK 16 N61E 15.18'; W OAK 18 S8E 75.9' LAND ROLLING SECOND RATE BURR OAK W. OAK HICKORY & C HAZLE ????? SEPT 12TH 1833
- 1859 MAGNOLIA TWP RD REC BK 1 PG 25 WHEREOF AN ACCURATE SURVEY HAS BEEN MADE WHICH IS AS FOLLOWS TO WIT. COMMENCING AT THE QUARTER STAKE ON THE SOUTH LINE DIVIDING SEC 32 OF UNION & SECTION FIVE IN MAGNOLIA AND RUNNING THENCE WEST ALONG SAID LINE TO THE SOUTH CENTER QUARTER POST OF SECTION 31 OF SAID TOWN OF UNION AND SECTION 6 OF MAGNOLIA THE LINE OF SAID SURVEY TO BE THE CENTER OF SAID HIGHWAY THENCE WEST ON THE LINE OF SAID SECTION 31 IN THE TOWN OF UNION AND SECTION SIX OF MAGNOLIA TO THE WEST LINE OF THE EAST HALF OF THE NW 1/4 OF SECTION SIX IN THE TOWN OF MAGNOLIA, LINE OF SAID SURVEY TO BE THE NORTH LINE OF SAID HIGHWAY THENCE WEST ALONG THE LINE OF SECTION 31 AND SECTION 6 OF THE TOWN OF MAGNOLIA TO THE WEST SIDE OF SAID SECTION, THE LINE OF SAID SURVEY TO BE THE CENTER OF SAID HIGHWAY AND THE SAME IS HEREBY ESTABLISHED FOUR RODS WIDE.
- 1864 LOCKE VOL 1 PG 205 FD EAST BT. 237.60 EAST OF SET LS 20X13X2 1/2 @ N 1/4 COR SEC 6 T3N R10E. 2986.83 FROM S 1/4 COR SEC 31 TO SW COR SEC 31. VAR 6-50 2749.23 TO FD STUMPS OF BT. SET HH 11 1/2X8X5 @ SW COR SEC 31 & VAR 7-15 2613.93 FROM N 1/4 COR SEC 6 TO FD WHERE CORNER TREE WAS DUG UP @ NE COR SEC 6 N 1/4 COR SEC 6 USED TO SUBDIVIDE SEC 6. VAR 6-42 2166.78 FROM N 1/4 COR TO CENTER OF SEC 6
- 1870 RUGER AUG REMON-82 AUGUST 24 1870 WEST ON SOUTH LINE OF SE 1/4 SEC 31 ON A VAR 6-45 OFFSET SOUTH 30.03' OFFSET NORTH 10.56' AT
  - 2627.79 INTERSECTED QUARTER LINE 11.88 SOUTH OF QUARTER CORNER. FOUND OLD STAKE AT CORNER. ALSO FOUND EAST BEARING TREE AND WHERE STUMP OF WEST BEARING TREE HAD BEEN DUG UP. COR VAR 6-55

WEST ON SOUTH LINE OF SW 1/4 SEC 31 ON A VAR 7-17' OFFSET SOUTH 34.98' OFFSET NORTH 17.82' OFFSET NORTH 15.18' OFFSET NORTH 8.58' OFFET NORTH 7.92 AT

- 2988.48 INTERSECTED WEST BOUNDARY LINE 9.9' SOUTH OF CORNER FOUND OLD STAKE AT CORNER ALSO FOUND STUMPS OF BEARING TREES. COR VAR 6-45
- 1890 BLEEDORN VOL 2 PG 440 MON. USED TO SUBDIVIDE SEC 31. VAR 5-05 TO N 1/4 COR SEC 31
- 1890 BLEEDORN VOL 2 PG 441 N 1/16 TH OF NE1/4 COR SEC 6 FD LS SET BY LOCKE. CALLS FOR MON. @ N 1/4 COR SEC 6 CALLS FOR MON AS WEST OF S 1/4 COR SEC 31
- 1968 BATTERMAN VOL 4 PG 364 FD CUT STONE ON N SIDE OF RD IN DITCH. REF. SAME.
- 1977 BARNES VOL 5 PG 330 FD 1/4 REBAR. SET ALUM. & REF SAME. 4.7' NORTH OF NORTH PVMT EDGE.

SHEET 1 OF 3

CORNER CODE Z-3

Emboss 1/201/ Oct 1/201/ Daniel Raises UN622 S1/4CORSEC31

COMBS CSM VOL 9 PG 152 ALUM MON. 1979

COMBS CSM VOL 12 PG 365 ALUM 1986

COMBS CSM VOL 24 PG 264 ALUM 2634.14 TO R/R SPIKE @ 2001 SE COR SEC 31

KARNES #16230 ROCK COUNTY SEC COR. N89-45E TO SE 2009 COR SEC 31

2009 COMBS #16201 FD ALUM

FD ALUM, MON. 4.7' NORTH OF NORTH PVMT EDGE. THE G-1 MON IS UNDER A LOT OF STONES. I DID NOT UNCOVER IT.

C) Was the corner restored through acceptance of (1) an obliterated evidence location, or, (2) a found perpetuated location?

ACCEPTED ALUM WHICH PERPETUATES THE FD CUT LIMESTONE.

D) Describe any material discrepancy between the location of the corner as restored or reestablished and the location of that corner as previously restored or reestablished by distance and direction. Show the discrepancy on the plan view drawing under (a), above. Show the distances between the corner as previously restored or reestablished and (1) the corner as restored or reestablished, and (2) to at least 4 of the witness monuments shown on the drawing in (a), above.

NONE

(E) Was the corner reestablished through lost corner proportionate methods? If so, show the method, including the directions and distances to other public land survey corners used as evidence or used for proportioning the corner location.

 $N\Box$ 

I, Donald Barnes, hereby certify that the corner location as identified by the corner code index was determined by me under my direction and control and that this U.S. Public Land Survey Monument Record is correct and complete to the best of my knowledge and belief. Oct 11 2001 On Baires

SHEET 2 OF 3

CORNER CODE Z-3

A.E. 7.08 REQUIREMENT

