


U.S. PUBLIC LAND SURVEY MONUMENT RECORD

For Public Land Survey Corners in the
T. 2 N., R. 12 E.

CORNER CODE INDEX

	2	3	4	5	6	7	8	9	10	11	12	13	14	15	16	17	18	19	20	21	22	23	24	25
A	◆																							
B																								
C		6																						
D			5																					
E				4																				
F					3																			
G						2																		
H																								
I																								
J																								
K																								
L																								
M																								
N																								
O																								
P																								
Q																								
R																								
S																								
T																								
U																								
V																								
W																								
X																								
Y																								
Z																								

EXAMPLE

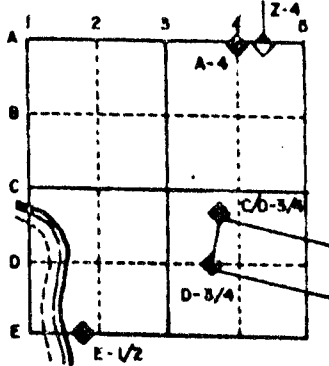

ROCK TWP
ROCK COUNTY WI

IF AVAILABLE
STATE PLANE COORDINATES

NAD
27
North (Y) 246,136.16 Eleve. (Z) _____
East (X) 2,233,919.67 Zone _____
Hor. Datum _____ Vert. Datum _____


PLACE MONUMENT SYMBOL (◆) AT PROPER LOCATION ON ABOVE INDEX

JANESVILLE PROJECT
246,136.05
2,233,920.98
 USING DOT CONTROL
246,136.80
2,233,919.92

◆ CORNER MONUMENT ○ WITNESS MONUMENT

BEARINGS ARE BASED ON:

FOUND TIES AS
SHOWN IN JANESVILLE TWP 21 (1)

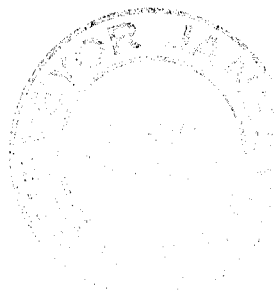

Donald Barnes
2/18/92

MICROFILMED

SHEET ___ OF ___

CORNER CODE: A1