
## PUBLIC LAND SURVEY U.S. MONUMENT RECORD

For Public Land Survey Corners in: T. 4N., R. 9 E

WI ADMINISTRATIVE CODE A-E 7.08 REQUIREMENT

T. 4 N., R. \_

CORNER CODE INDEX

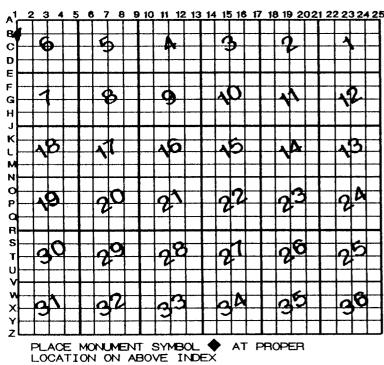

BROOKLYN GREEN ROCK COUNTY WI

IF AVAILABLE

ROCK COUNTY COORDINATES PERFERRED

North 327,406, 962 Elev. 956,761

East 400, 357. 395

Hor. Datum NAD 83 Vert. Datum NAD 29

LATITUDE 42-50-32,703394 ELLIPS. HT.

LONGITUTE89-22-8,972099 846,502

GPS (X)

TRAVERSE (X) \_\_\_

BASED ON THE FOLLOWING CONTROL:

**◆**CORNER MONUMENT

WITNESS MONUMENT

(a)

Fd PK

SE 1 TA 9R9E

THE ABOVE LATITUDE & LONGITUDE WAS ACQUIRED FOR A GREEN COUNTY LAND INFORMATION PROJECT BY BOWEDEN SURVEYING COMPANY. GPS EQUIPMENT WAS USED. BOWEDEN SURVEYING COMPANY PROVIDED THE INFORMATION.

I COMPUTED THE COUNTY COORDINATES AND THE FOLLOW DATA FROM THE LATITUDE & LONGITUDE.

SCALE 1.00000 32460

ANGULAR DIFFERENCE BETWEEN THE GEODETIC NORTH & ROCK COUNTY MERCATOR NORTH

0-12-06,9

Ö BASED BEARINGS ARE

FIELD BOOKPAGE #	SHEET	OF
SHOW A PLAN VIEW DRAWING DEPICTING THE CORNER MONUMENT AN	D SURROUNDING	
PHYSICAL FEATURES, INCLUDING THE EXCAVATION AREA AND DEPTH.	(11110	TWA
DIANNING & TONING COMMITTEE ADOPTED THE ABOVE FORM ON 12/2/1082	1/N/() K	

(B) Describe any record evidence, monument avidence, occupational evidence, testimonial evidence or any other material evidence you considered, and whether the monument was found or placed.

I DID NOT PERFORM THE SURVEY. I AM ONLY PLACING ON NECOND THE DETA.

C) Was the corner restored through acceptance of (1) an obliterated evidence location, or, (2) a found perpetuated location?

DID NOT ACCEPT NOR REJECT THE PROVIDED DATA.

- D) Describe any material discrepancy between the location of the corner as restored or reestablished and the location of that corner as previously restored or reestablished by distance and direction. Show the discrepancy on the plan view drawing under (a), above. Show the distances between the corner as previously restored or reestablished and (1) the corner as restored or reestablished, and (2) to at least 4 of the witness monuments shown on the drawing in (a), above.
- (E) Was the corner reestablished through lost corner proportionate methods? If so, show the method, including the directions and distances to other public land survey corners used as evidence or used for proportioning the corner location.

I, Donald Barnes, hereby certify that the corner location as identified by the corner code index was determined by me under by direction and control and that this U.S. Public Land Survey Monument Record is correct and complete to the best of my knowledge and belief.

seal

Number of included sheets \_

A-E 7.08 REQUIREMENT

CORNER CODE

B-1 UNION TWP