

# U.S. PUBLIC LAND SURVEY MONUMENT RECORD


For Public Land Survey Corners in the  
T. 2 N., R. 12 E.

## CORNER CODE INDEX

	1	2	3	4	5	6	7	8	9	10	11	12	13	14	15	16	17	18	19	20	21	22	23	24	25
A																									
B																									
C	6																								
D		5																							
E			4																						
F				3																					
G					2																				
H																									
I																									
J	7																								
K		8																							
L			9																						
M				10																					
N					11																				
O						12																			
P							13																		
Q								14																	
R									15																
S										16															
T											17														
U												18													
V													19												
W														20											
X															21										
Y																22									
Z																	23								
																		24							
																			25						
																				26					
																					27				
																						28			
																							29		
																								30	
																									31
																									32
																									33
																									34
																									35
																									36

PLACE MONUMENT SYMBOL (◆) AT PROPER LOCATION ON ABOVE INDEX

### EXAMPLE

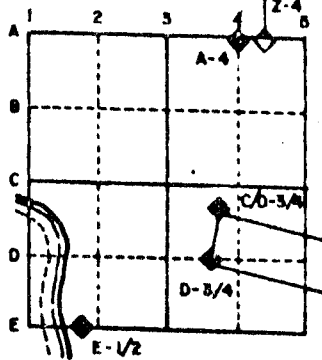

ROCK TWP  
ROCK COUNTY WI


IF AVAILABLE  
STATE PLANE COORDINATES

North (Y) \_\_\_\_\_ Eleve. (Z) \_\_\_\_\_  
 East (X) \_\_\_\_\_ Zone \_\_\_\_\_  
 Hor. Datum \_\_\_\_\_ Vert. Datum \_\_\_\_\_

◆ CORNER MONUMENT

○ WITNESS MONUMENT

BEARINGS ARE BASED ON: TOWNSHIP PROJECT

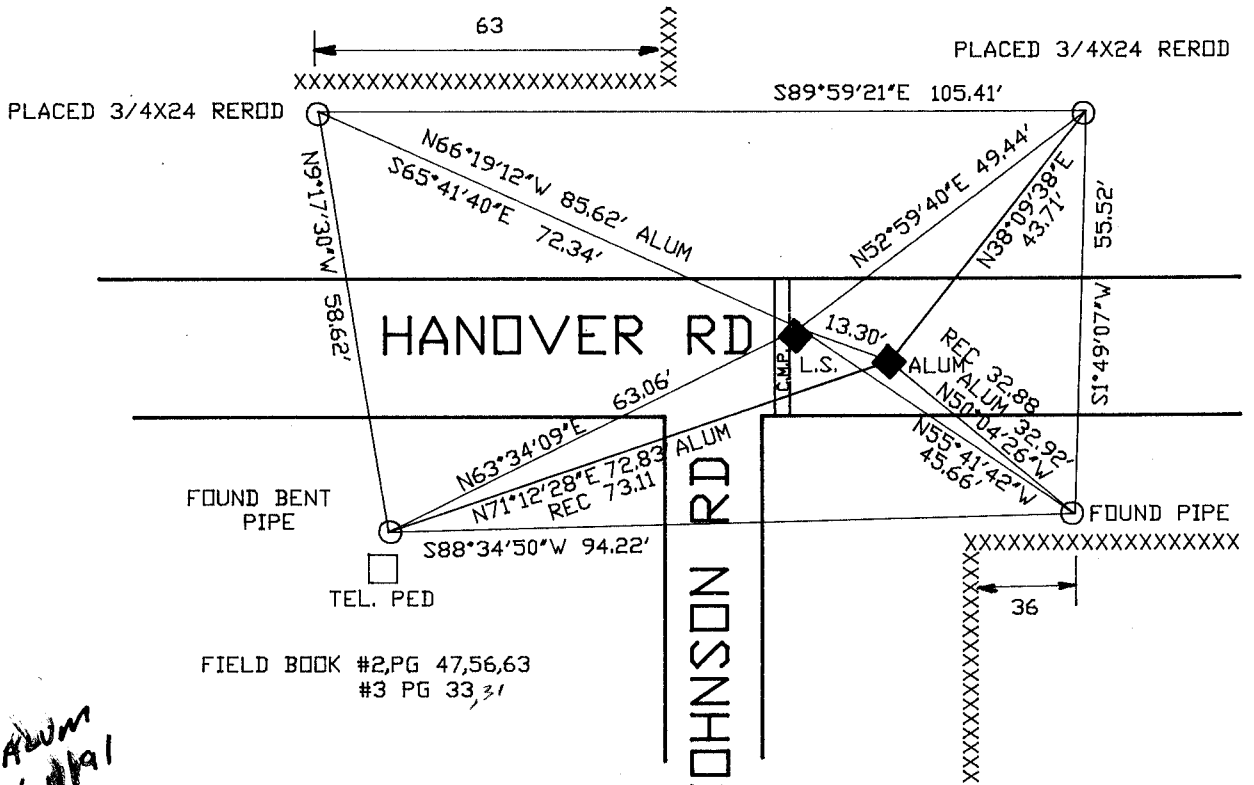

FIELD BOOK #2, PG 47,56,63  
#3 PG 33,31

*Placed Alum  
MON. 7/20/91  
DAB*

MICROFILMED

SHEET \_\_\_ OF \_\_\_

CORNER CODE: E1

(B) Describe any record evidence, monument evidence, occupational evidence, testimonial evidence or any other material evidence you considered, and whether the monument was found or placed.

- 1833 MULLETT ORIGINAL GOVERNMENT SURVEYOR. FIELD NOTES - NORTH ON EAST SIDE OF SECTION 12 PLYMOUTH TOWNSHIP. SET POST CORNER SECTIONS 1 & 12. BUR OAK 8 N 1/2W 8.75 & BUR OAK 8 S73W 3.88
- 1834 HARRISON ORIGINAL GOVERNMENT SURVEYOR. FIELD NOTES - INTERSECTED WEST BOUNDARY 72.60 SOUTH OF POST AND MARKED SAME. NO TREES. SHOWS A DISTANCE OF 2689.50' TO S 1/4 CORNER OF SECTION 6.
- 1854 McVEAN VOL 1 PG 23. SHOWS A DISTANCE OF 2636.70 TO W 1/4 CORNER AND 2670.36 TO S 1/4 CORNER OF SECTION 6.
- 1867 LEE VOL 1 PG 331 FOUND STAKE SET BY LOCKE. SHOWS A DISTANCE OF 2644.46 FROM THE E 1/4 CORNER TO NE CORNER OF SECTION 12 PLYMOUTH TOWNSHIP.
- 1868 LOCKE PLYMOUTH TOWNSHIP REMONUMENTATION FIELD NOTES. NORTH ON EAST LINE SECTION 12. INTERSECTED 1/4 LINE 1.32' WEST OF CORNER. FOUND NORTH B.T. AND STUMP OF SOUTH B.T. AND STAKE. NORTH B.T. 15 N79W. MEASURED 2653.20' TO SE CORNER OF SECTION 12 AND 2653.20 TO NE CORNER OF SECTION 12 PLYMOUTH TOWNSHIP.
- 1870 RUGER VOL 2 PG 43 FOUND STONE MONUMENT SET BY LOCKE.
- 1876 RUGER VOL 2 PG 205 CALLS FOR STONE MONUMENT. SHOWS A DISTANCE OF 2615.94 FROM E 1/4 CORNER TO NE CORNER OF SECTION 12 PLYMOUTH TOWNSHIP.
- 1974 LEE VOL 5 PG 53 CORNER SET BY DOUBLING DISTANCE AND LINE BETWEEN THE W 1/16 CORNER OF THE NW 1/4 OF SECTION 7 AND THE W 1/4 CORNER OF SECTION 7. HE REFERENCED SAME. SHOWS A DISTANCE OF 2666.27 TO S 1/4 CORNER OF SECTION 6 AND 2648.62 TO W 1/4 CORNER OF SECTION 7.
- 1980 BARNES VOL 6 PG 29 SHOWS A DISTANCE TO THE W 1/4 CORNER OF SECTION 7 OF 2644.45 BY LOCKE (1867) AND LOCKE 2653.20.
- 1983 BARNES VOL 6 PG 307. THE WEST LINE OF NW 1/4 OF SECTION 7. DEPICTS DIFFERENT DISTANCES AND MONUMENTS FOUND OR SET. SEE VOL 5 PAGE 53 AND VOL 4 PAGES 587 AND 588.

PLACED AN ALUMINUM MONUMENT AT THE POSITION THAT LEE ESTABLISHED. DUG AND FOUND CUT LIMESTONE THAT IS HARMONY WITH RECORD DISTANCES.

C) Was the corner restored through acceptance of (1) an obliterated evidence location, or, (2) a found perpetuated location?

ACCEPTED FOUND CUT LIMESTONE.

I, Donald Barnes, hereby certify that the corner points as identified by the corner code index were, in a field survey on, July 19, 1990, established, re-established, monumented, re-monumented, recovered or restored as expressed below and in conformance with the regulations and rules as required in the current manual of survey instructions of the United States Department of Interior, Bureau of Land Management.



COUNTY SURVEYOR FILING DATA

Date of computer entry \_\_\_\_\_

Date microfilmed \_\_\_\_\_

Number of included sheets \_\_\_\_\_  
CORNER CODE

AFFIX YOUR LAND SURVEYOR SEAL

E1