


# U.S. PUBLIC LAND SURVEY MONUMENT RECORD

For Public Land Survey Corners in the  
T. 2 N., R. 12 E.

## CORNER CODE INDEX

	1	2	3	4	5	6	7	8	9	10	11	12	13	14	15	16	17	18	19	20	21	22	23	24	25
A																									
B																									
C	6																								
D		5																							
E			4																						
F				3																					
G					2																				
H	7																								
I		8																							
J			9																						
K				10																					
L					11																				
M						12																			
N							13																		
O								14																	
P									15																
Q										16															
R											17														
S												18													
T													19												
U														20											
V															21										
W																22									
X																	23								
Y																		24							
Z																			25						

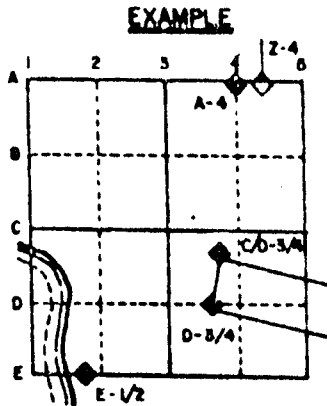

Rock TWP  
ROCK COUNTY WI

IF AVAILABLE  
STATE PLANE COORDINATES

North (Y) 238,171.08      Eleve. (Z) \_\_\_\_\_  
 East (X) 2,234,005.84      Zone \_\_\_\_\_  
 Hor. Datum \_\_\_\_\_      Vert. Datum \_\_\_\_\_

PLACE MONUMENT SYMBOL (●) AT PROPER LOCATION ON ABOVE INDEX

WPL 238,169.78  
2,234,006.65

◆ CORNER MONUMENT

○ WITNESS MONUMENT

FOUND TIES AS SHOWN  
ON VOL 6 PG 33

BEARINGS ARE BASED ON:

MICROFILMED

SHEET \_\_\_ OF \_\_\_

CORNER CODE: G1

(B) Describe any record evidence, monument evidence, occupational evidence, testimonial evidence or any other material evidence you considered, and whether the monument was found or placed.

- 1833 MULLETT ORIGINAL GOVERNMENT SURVEYOR. FIELD NOTES - (E 1/4 CORNER SEC 12 PLYMOUTH TOWNSHIP) NORTH ON EAST SIDE SECTION 12. SET QUARTER SECTION POST HICKORY 8 S22W 26, HICKORY 10 N89W 25.
- 1864 LOCKE VOL 1 PG 218 (E 1/4 COR SEC 12 PLYMOUTH) FOUND BEARING TREES AND OLD STAKE. ERROR IN NOTES. SET W.O. STAKE 2 INCHES NORTH OF OLD STAKE WITH 4 LIMESTONES ( ON N.S.E. & W SIDES) IN MOUND. PIT 3 FEET S-SW. SHOWS A DISTANCE OF 2674.32 TO CENTER OF SECTION 12 PLYMOUTH TOWNSHIP.
- 1867 LEE VOL 1 PG 331 FOUND STAKE SET BY LOCKE. SHOWS A DISTANCE OF 2644.46 TO THE NE CORNER AND CENTER OF SECTION 12 PLYMOUTH TOWNSHIP.
- 1868 LOCKE PLYMOUTH TOWNSHIP REMONUMENTATION FIELD NOTES. NORTH ON EAST LINE OF SECTION 12. INTERSECTED 1/4 LINE 1.32' WEST OF CORNER. FOUND N. BT. AND STUMP OF SOUTH BT. AND STAKE. NORTH BT IS N79W. MEASURED 2653.20 TO SE CORNER OF SECTION 12 AND 2653.20' TO NE CORNER OF SECTION 12. PLACED CUT LIMESTONE.
- 1876 RUGER VOL 2 PG 205 STONE MONUMENT. SHOWS A DISTANCE OF 2645.94 TO NE CORNER SECTION 12, 2599.08 TO CENTER OF SECTION 12, AND 2646.93 TO SE CORNER OF SECTION 12 PLYMOUTH TOWNSHIP.
- 1972 LEE VOL 4 PG 587 DUG AND FOUND NOTHING. SET BY PRORATION. SET CAST IRON MONUMENT. REFERENCED SAME.
- 1972 LEE VOL 4 PG 588 SHOWS THE FOLLOWING DISTANCES AND BEARINGS TO:  
 NW COR OF SW 1/4 OF NW 1/4 SEC 7 N00-55-35W 1331.74  
 E 1/4 COR SEC 7 S89-29-16E 5343.83  
 SW COR SEC 7 N00-55-35W 2663.48
- 1974 LEE VOL 5 PG 53 CUT STONE MONUMENT SHOWS A DISTANCE OF 2648.62 TO NW CORNER OF SECTION 7.
- 1980 BARNES VOL 6 PG 29. SHOWS WPL COORDINATES N/S 238,169.78; E/W 2,234,006.65 AND THE FOLLOWING DISTANCES:  
 TO NW COR SEC 7 RUGER 1876 2645.94  
 LOCKE 1867 2644.45  
 LOCKE 2653.20  
 N89-44-41W 2606.39  
 CENTER SEC 12 SOUTHERLY TO CENTER R/R 1506  
 SW COR SEC 7 N01-05-42W 2651.73  
 LOCKE 2653.2
- 1980 BARNES VOL 6 PG 33 FOUND CUT LIMESTONE .2' ABOVE GROUND REFERENCED SAME.
- 1982 BARNES VOL 6 PG 281 SHOWS N0-01-16E 2653.84 TO SW CORNER OF SECTION 7.
- 1982 BARNES VOL 6 PG 282 SHOWS COORDINATES N/S 238,169.78; E/W 2,234,006.65 AND THE FOLLOWING DISTANCE:  
 TO: SE CORNER OF SEC 13 LOCKE 1869 2653.20  
 MEASURED 2653.84
- 1983 BARNES VOL 6 PG 307. SEE VOLUME 5 PAGE 53 AND VOLUME 4 PAGES 587 AND 588. THE WEST LINE OF THE NW 1/4 OF SECTION 7 DEPICTS DIFFERENT DISTANCES AND MONUMENTS THAT WERE FOUND OR SET.

FOUND CUT LIMESTONE WITH CARSONITE POST.


C) Was the corner restored through acceptance of (1) an obliterated evidence location, or, (2) a found perpetuated location?

ACCEPTED FOUND CUT LIMESTONE.



SHEET 1 OF 2

I, Donald Barnes, hereby certify that the corner points as identified by the corner code index were, in a field survey on, October 24, 1990, established, re-established, monumented, re-monumented, recovered or restored as expressed below and in conformance with the regulations and rules as required in the current manual of survey instructions of the United States Department of Interior, Bureau of Land Management.

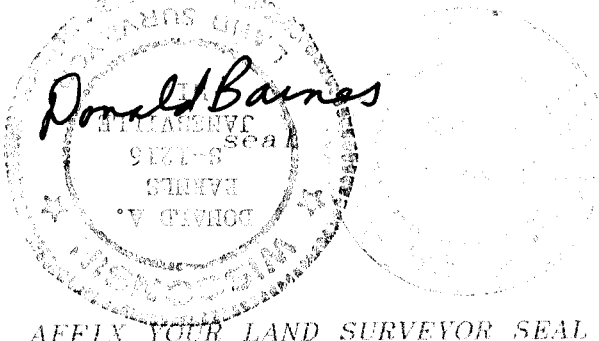

COUNTY SURVEYOR FILING DATA

Date of computer entry \_\_\_\_\_

Date microfilmed \_\_\_\_\_

Number of included sheets 1  
CORNER CODE

AFFIX YOUR LAND SURVEYOR SEAL

G /