

# PUBLIC LAND SURVEY MONUMENT RECORD

For Public Land Survey Corners in the


T. 1 N., R. 10 E.

## CORNER CODE INDEX

|   |    |    |    |    |    |    |   |   |   |    |    |    |    |    |    |    |    |    |    |    |    |    |    |    |    |
|---|----|----|----|----|----|----|---|---|---|----|----|----|----|----|----|----|----|----|----|----|----|----|----|----|----|
|   | 1  | 2  | 3  | 4  | 5  | 6  | 7 | 8 | 9 | 10 | 11 | 12 | 13 | 14 | 15 | 16 | 17 | 18 | 19 | 20 | 21 | 22 | 23 | 24 | 25 |
| A | 6  | 5  | 4  | 3  | 2  | 1  |   |   |   |    |    |    |    |    |    |    |    |    |    |    |    |    |    |    |    |
| B |    |    |    |    |    |    |   |   |   |    |    |    |    |    |    |    |    |    |    |    |    |    |    |    |    |
| C |    |    |    |    |    |    |   |   |   |    |    |    |    |    |    |    |    |    |    |    |    |    |    |    |    |
| D |    |    |    |    |    |    |   |   |   |    |    |    |    |    |    |    |    |    |    |    |    |    |    |    |    |
| E |    |    |    |    |    |    |   |   |   |    |    |    |    |    |    |    |    |    |    |    |    |    |    |    |    |
| F |    |    |    |    |    |    |   |   |   |    |    |    |    |    |    |    |    |    |    |    |    |    |    |    |    |
| G |    |    |    |    |    |    |   |   |   |    |    |    |    |    |    |    |    |    |    |    |    |    |    |    |    |
| H | 7  | 8  | 9  | 10 | 11 | 12 |   |   |   |    |    |    |    |    |    |    |    |    |    |    |    |    |    |    |    |
| I |    |    |    |    |    |    |   |   |   |    |    |    |    |    |    |    |    |    |    |    |    |    |    |    |    |
| J |    |    |    |    |    |    |   |   |   |    |    |    |    |    |    |    |    |    |    |    |    |    |    |    |    |
| K |    |    |    |    |    |    |   |   |   |    |    |    |    |    |    |    |    |    |    |    |    |    |    |    |    |
| L | 18 | 17 | 16 | 15 | 14 | 13 |   |   |   |    |    |    |    |    |    |    |    |    |    |    |    |    |    |    |    |
| M |    |    |    |    |    |    |   |   |   |    |    |    |    |    |    |    |    |    |    |    |    |    |    |    |    |
| N |    |    |    |    |    |    |   |   |   |    |    |    |    |    |    |    |    |    |    |    |    |    |    |    |    |
| O |    |    |    |    |    |    |   |   |   |    |    |    |    |    |    |    |    |    |    |    |    |    |    |    |    |
| P |    |    |    |    |    |    |   |   |   |    |    |    |    |    |    |    |    |    |    |    |    |    |    |    |    |
| Q | 19 | 20 | 21 | 22 | 23 | 24 |   |   |   |    |    |    |    |    |    |    |    |    |    |    |    |    |    |    |    |
| R |    |    |    |    |    |    |   |   |   |    |    |    |    |    |    |    |    |    |    |    |    |    |    |    |    |
| S |    |    |    |    |    |    |   |   |   |    |    |    |    |    |    |    |    |    |    |    |    |    |    |    |    |
| T | 30 | 29 | 28 | 27 | 26 | 25 |   |   |   |    |    |    |    |    |    |    |    |    |    |    |    |    |    |    |    |
| U |    |    |    |    |    |    |   |   |   |    |    |    |    |    |    |    |    |    |    |    |    |    |    |    |    |
| V |    |    |    |    |    |    |   |   |   |    |    |    |    |    |    |    |    |    |    |    |    |    |    |    |    |
| W |    |    |    |    |    |    |   |   |   |    |    |    |    |    |    |    |    |    |    |    |    |    |    |    |    |
| X |    |    |    |    |    |    |   |   |   |    |    |    |    |    |    |    |    |    |    |    |    |    |    |    |    |
| Y | 31 | 32 | 33 | 34 | 35 | 36 |   |   |   |    |    |    |    |    |    |    |    |    |    |    |    |    |    |    |    |
| Z |    |    |    |    |    |    |   |   |   |    |    |    |    |    |    |    |    |    |    |    |    |    |    |    |    |

PLACE MONUMENT SYMBOL (♦) AT PROPER LOCATION ON ABOVE INDEX

### EXAMPLE

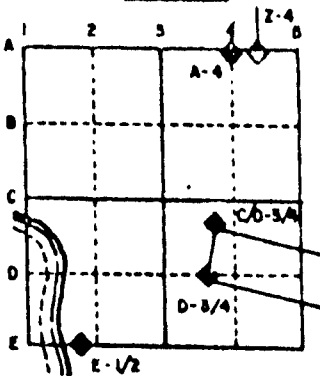


AVON TWP  
ROCK COUNTY WI

IF AVAILABLE  
STATE PLANE COORDINATES

North (Y) \_\_\_\_\_ Eleve. (Z) \_\_\_\_\_  
 East (X) \_\_\_\_\_ Zone \_\_\_\_\_  
 Hor. Datum \_\_\_\_\_ Vert. Datum \_\_\_\_\_

♦ CORNER MONUMENT      ⊙ WITNESS MONUMENT

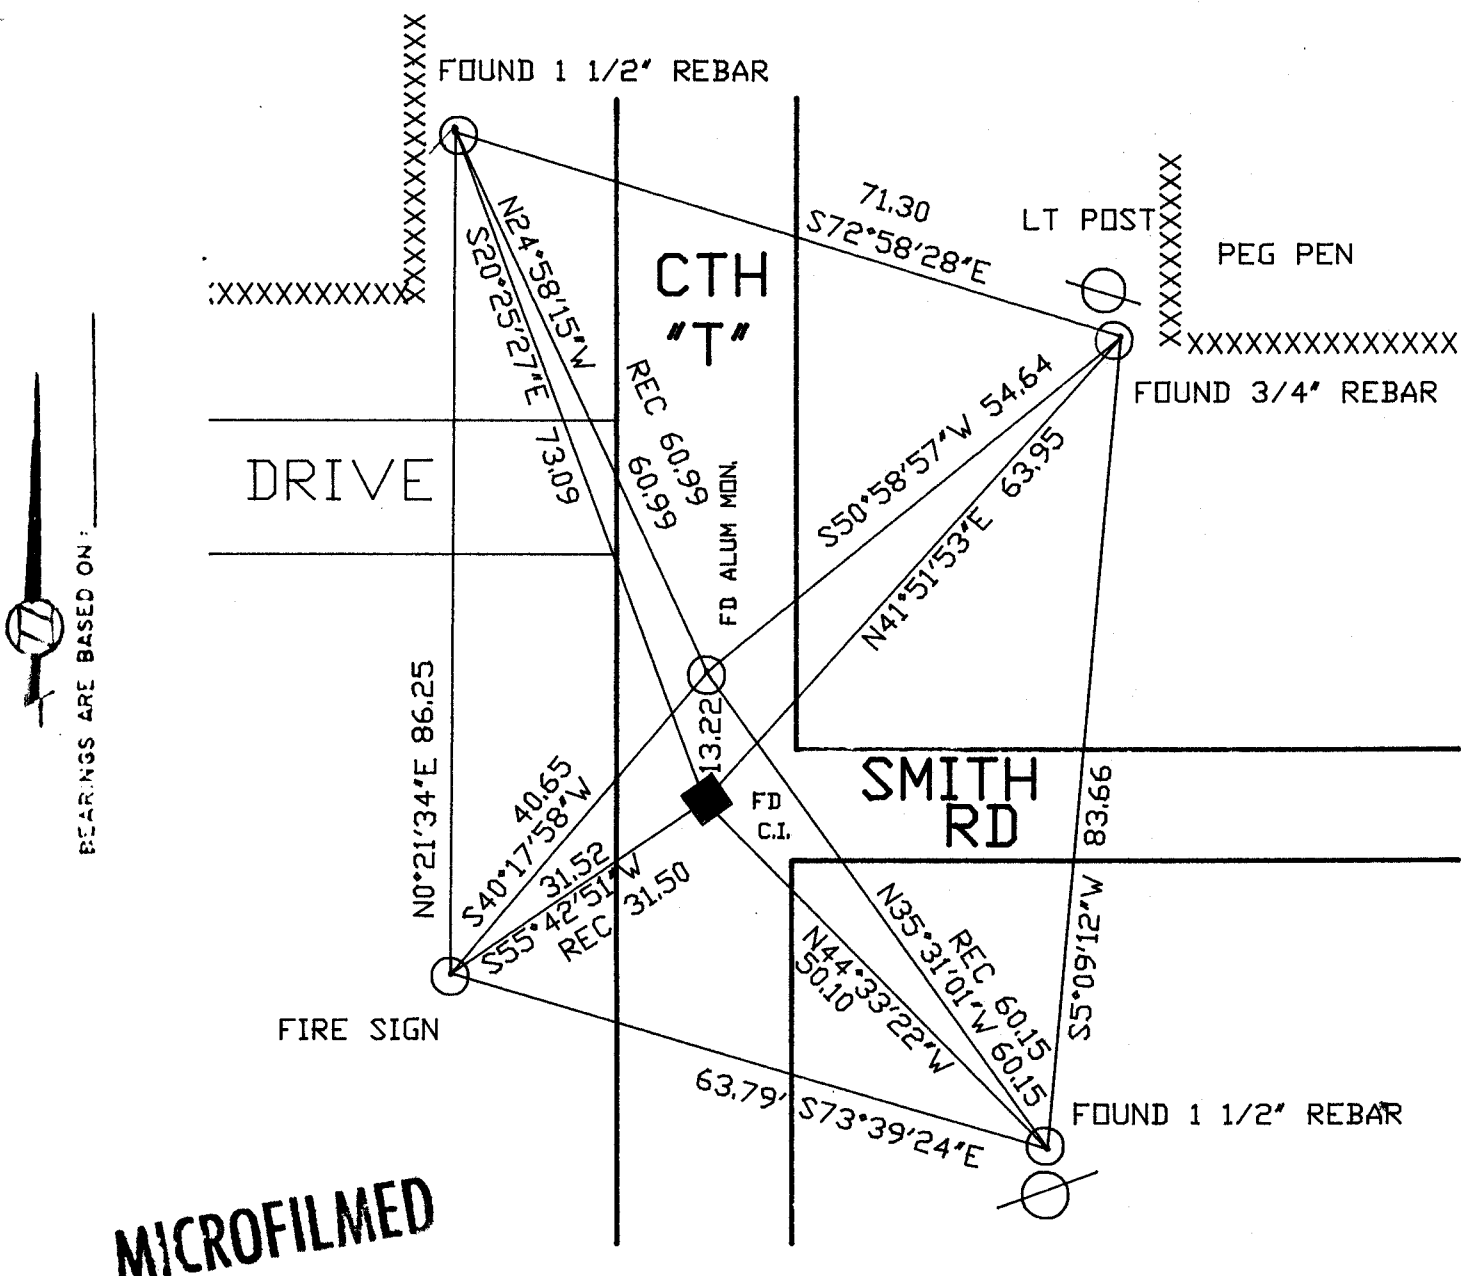

MICROFILMED



(B) Describe any record evidence, monument evidence, occupational evidence, testimonial evidence or any other material evidence you considered, and whether the monument was found or placed.

- 1833 MULLETT SET POST FOR CORNER TO SECTIONS 12 & 13. RAISED A MOUND. CALLS FOR 2640 TO THE E 1/4 COR OF SEC 12. & 2640 TO THE E 1/4 COR OF SEC 13.
- 1834 (JANUARY) HARRISON ORIGINAL GOVERNMENT SURVEYOR. WEST BOUNDARY. 13.2' SOUTH OF POST. CALLS FOR 2579.94 TO S 1/4 CORNER OF SECTION 7.
- 183? ORIGINAL SURVEY. 1879 STATE OF WISCONSIN SEALED AND CERTIFIED COPY. EAST BETWEEN SECS 12 & 13 VAR 8 E. 5336.76' INTSECTED RANGE LINE 7.92' NORTH OF POST.
- 1852 McVEAN VOL 1 PG 9 USED TO SURVEY SECTION 7. CALLS FOR 2623.50 TO S 1/4 CORNER AND 2641.98 TO W 1/4 CORNERS OF SECTION 7.
- 1856 HIGHWAY RECORDS BOOK 1 PG 28. "... THENCE RUNNING NORTH ON SAID COUNTY LINE TO INTERSECT THE COUNTY LINE ROAD ON WEST LINE OF SECTION 7 AND THAT THE SAID LINE ABOVE DESCRIBED BE THE CENTER LINE OF SAID HIGHWAY..."
- 1902 MORGAN (GREEN COUNTY SURVEYOR) PLAT OF SURVEY. FOUND ORIGINAL POST. SET ANOTHER IN ITS PLACE.
- 19?? KERCH VOL 3 PG 19 FOUND STAKE SET BY MORGAN. SET PART OF GRADE BAR 36" LONG AND 2X3 ON TOP. CALLS FOR 2610.50 TO N 1/4 CORNER AND 2641.30 TO W 1/4 CORNER OF SECTION 18. ALSO CALLS FOR AN ANGLE OF 89-11 FROM THE N 1/4 CORNER TO THE W 1/4 CORNER OF SECTION 18.
- 1977 BARNES VOL 5 PG 297 FOUND CAST IRON MONUMENT. CALLS FOR 2610.52 TO N 1/4 CORNER AND 5363.28 TO SW CORNER OF SECTION 18. ALSO CALLS FOR AN ANGLE OF 88-36-03 FROM THE N 1/4 CORNER TO THE SW CORNER OF SECTION 18.
- 1978 TALARCZYK TIE SHEET PLACED AN ALUMINUM MONUMENT AT THE SE CORNER OF SECTION 12 T1N R9E BY PROPORTIONATE MEASUREMENT AND EXISTING PHYSICAL EVIDENCE.
- 1992 SCHNEEBERGER TIE SHEET CALLS FOR A CAST IRON MONUMENT AND A ALUMINUM MONUMENT 13.22 TO THE NORTH AND 5302.78 TO THE NW CORNER OF SECTION 7.

FOUND CAST IRON MONUMENT & ALUMINUM MONUMENT IN CENTER OF PAVEMENT.

C) Was the corner restored through acceptance of (1) an obliterated evidence location, or, (2) a found perpetuated location?


ACCEPTED FOUND CAST IRON MONUMENT.

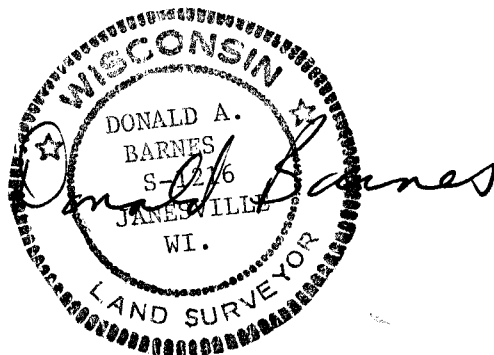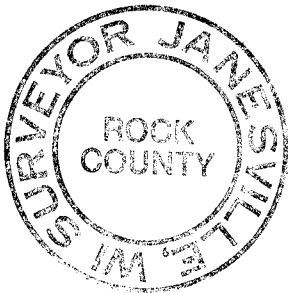

D) Describe any material discrepancy between the location of the corner as restored or reestablished and the location of that corner as previously restored or reestablished by distance and direction. Show the discrepancy on the plan view drawing under (a), above. Show the distances between the corner as previously restored or reestablished and (1) the corner as restored or reestablished, and (2) to at least 4 of the witness monuments shown on the drawing in (a), above.

THE ORIGINAL GOVERNMENT FIELD NOTES AND PLAT CALL FOR THE SE CORNER OF SECTION 12 AND THE SW CORNER OF SECTION 7 TO BE COMMON. DID NOT ACCEPT THE ALUMINUM MONUMENT. THE DISTANCE OF 13.22' BETWEEN THE CAST IRON MONUMENT AND THE ALUMINUM MONUMENT FITS THE ORIGINAL GOVERNMENT DISTANCE OF 13.2' WHICH IS NOT A JOG DISTANCE BUT IS MERELY A STATEMENT OF THE DISTANCE THAT HARRISON CLOSED UPON THE CORNER.

I, Donald Barnes, hereby certify that the corner points as identified by the corner code index were, in a field survey on, MAY 11, 1992, established, re-established, monumented, re-monumented, recovered or restored as expressed below and in conformance with the regulations and rules as required in the current manual of survey instructions of the United States Department of Interior, Bureau of Land Management.

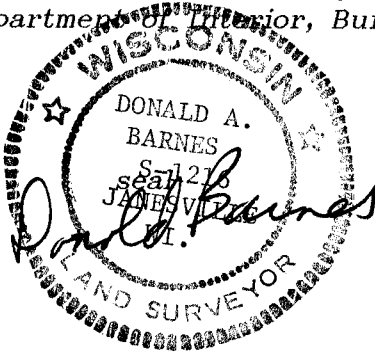

COUNTY SURVEYOR FILING DATA

Date of computer entry \_\_\_\_\_

Date microfilmed \_\_\_\_\_

Number of included sheets \_\_\_\_\_  
CORNER CODE

AFFIX YOUR LAND SURVEYOR SEAL

